

88 "Muslin" "Orange" "Red" "Blue"


3/3/91

M^o London
3/3/91

JW

HERS

4

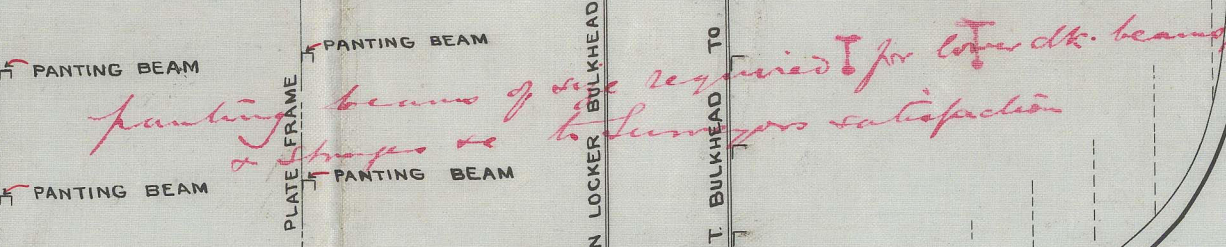

S.S. "Ruahine" Glasgow Report No. 1114 1/2

ANTONIO LOPEZ

GLS226-0053