


*See also to Gls*  
 MON 10 NOV 91

WED 12 NOV 91

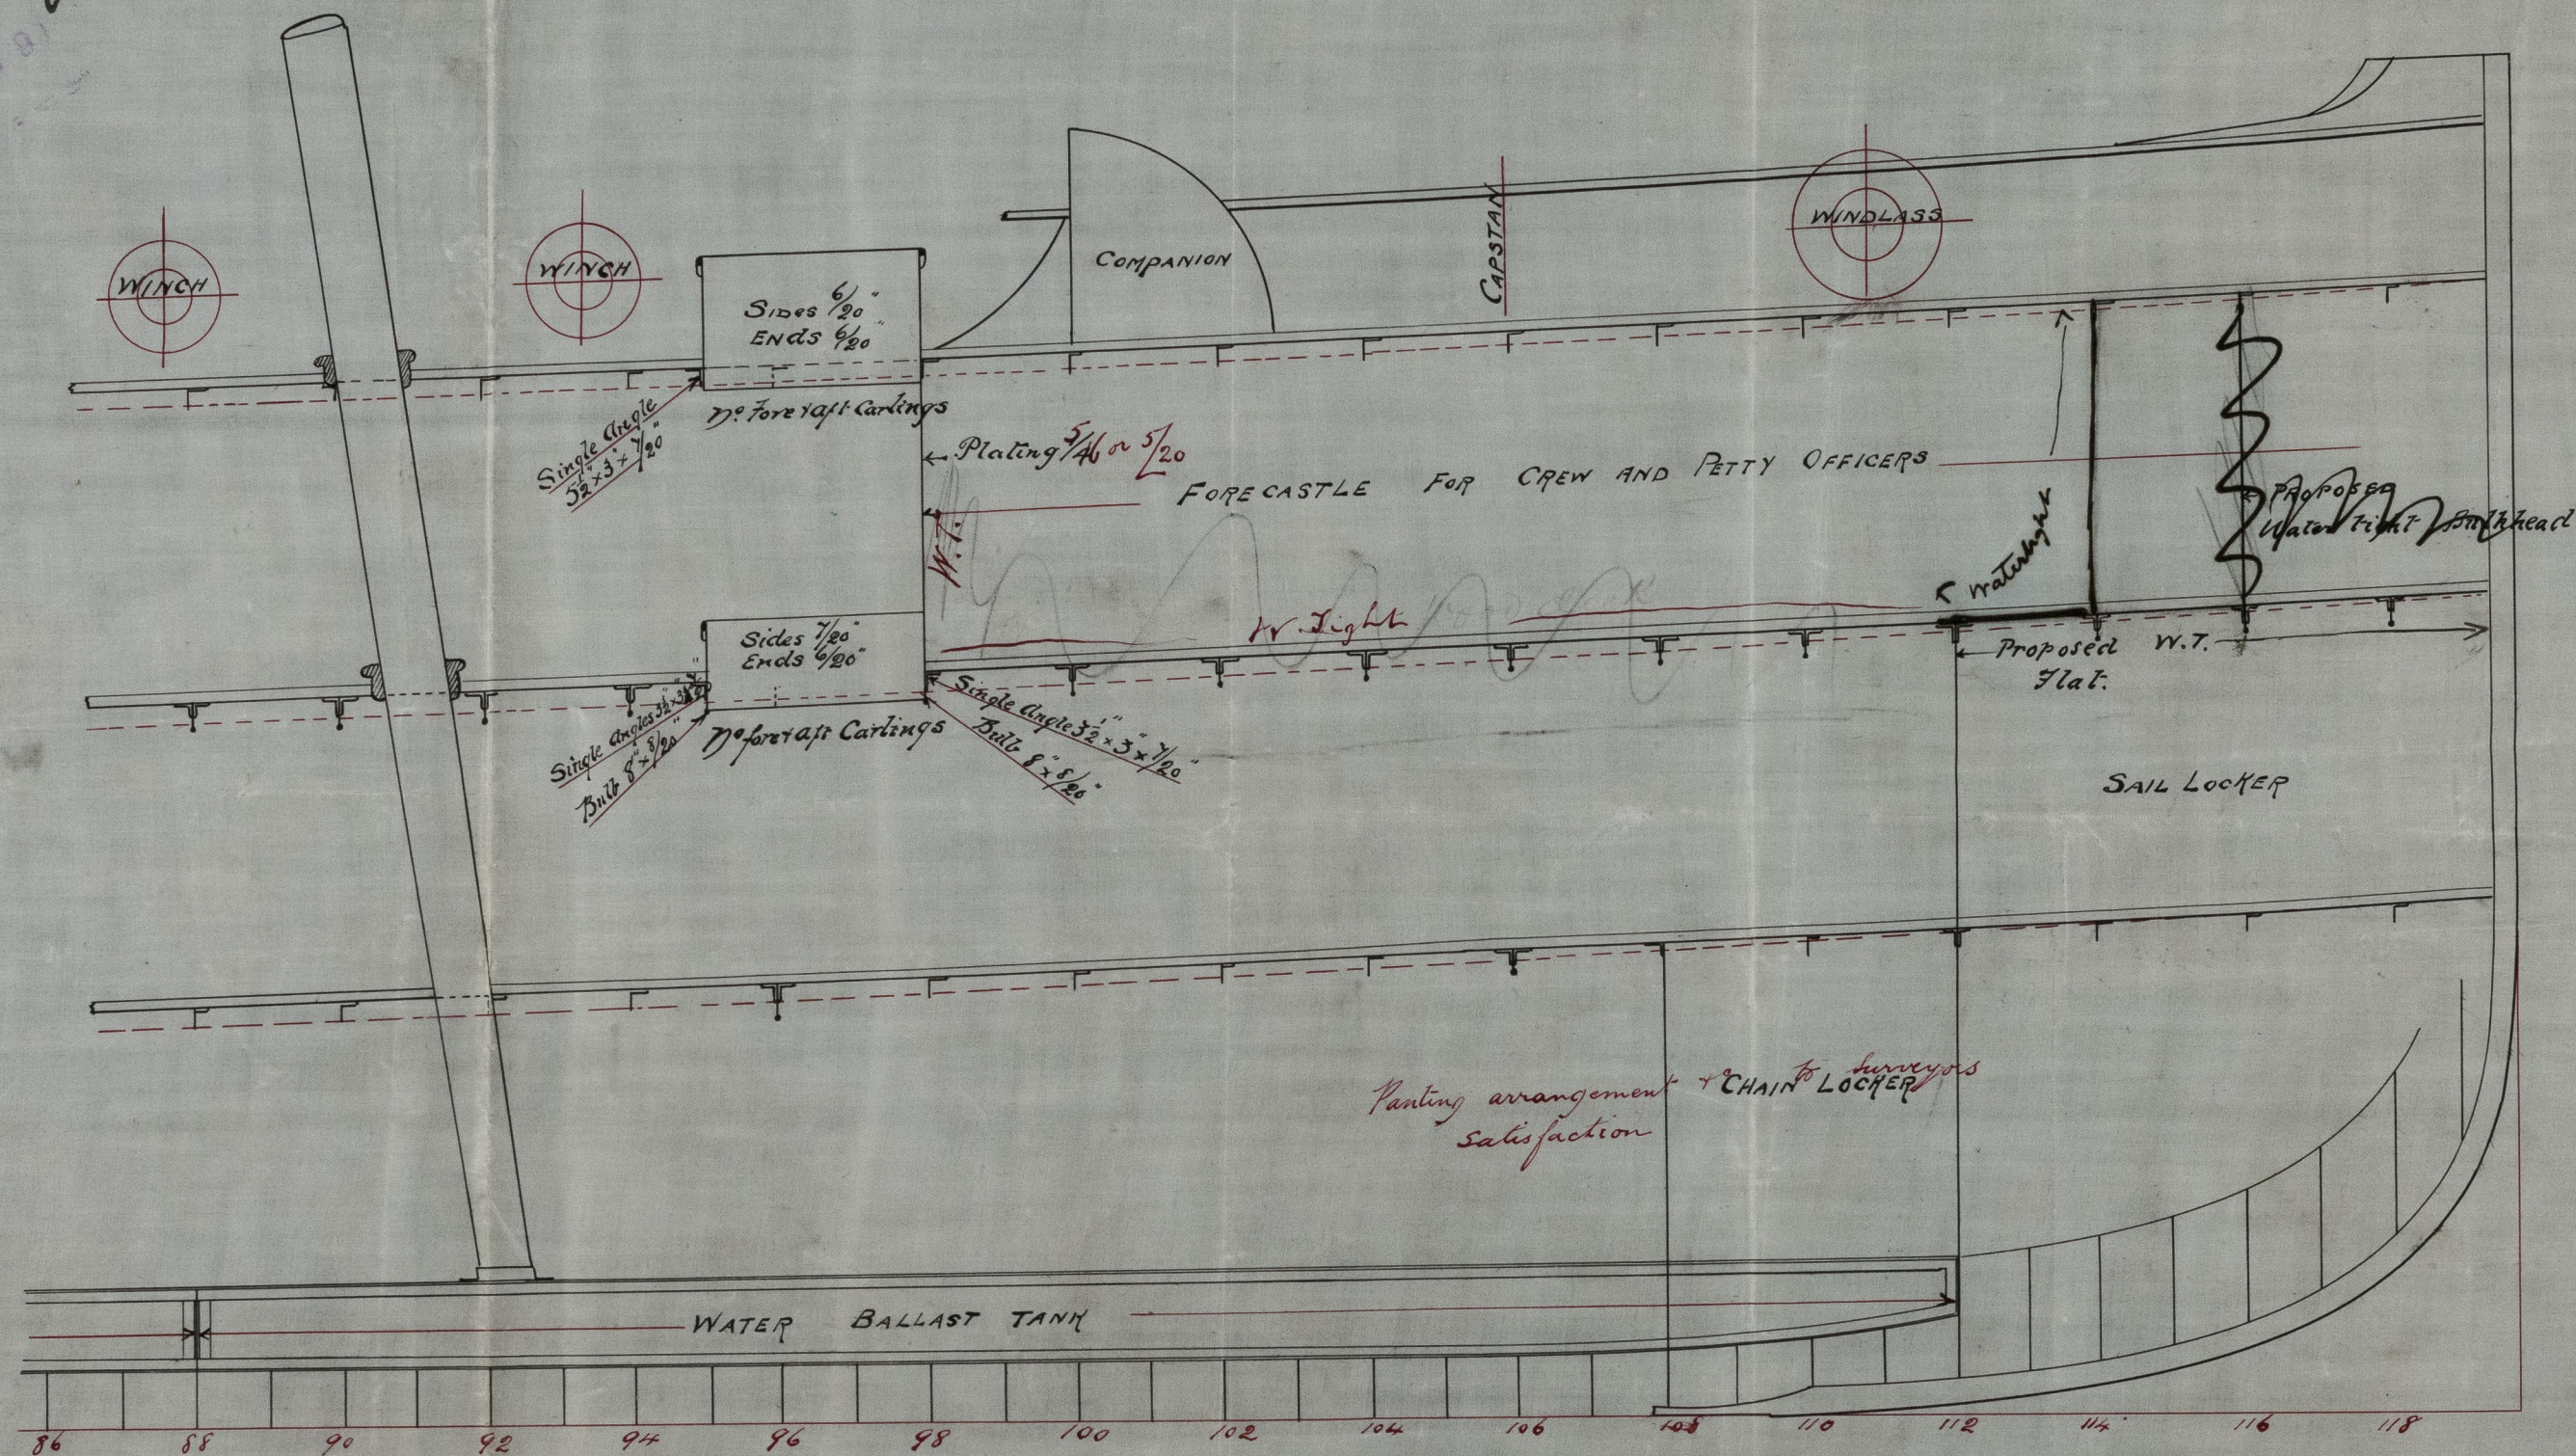

— Part Longitudinal Section of S.S. No 169 —

— Scale 1/4 Inch = 1 Foot —



© 2021

Lloyd's Register  
 Foundation

GLS226-0074