
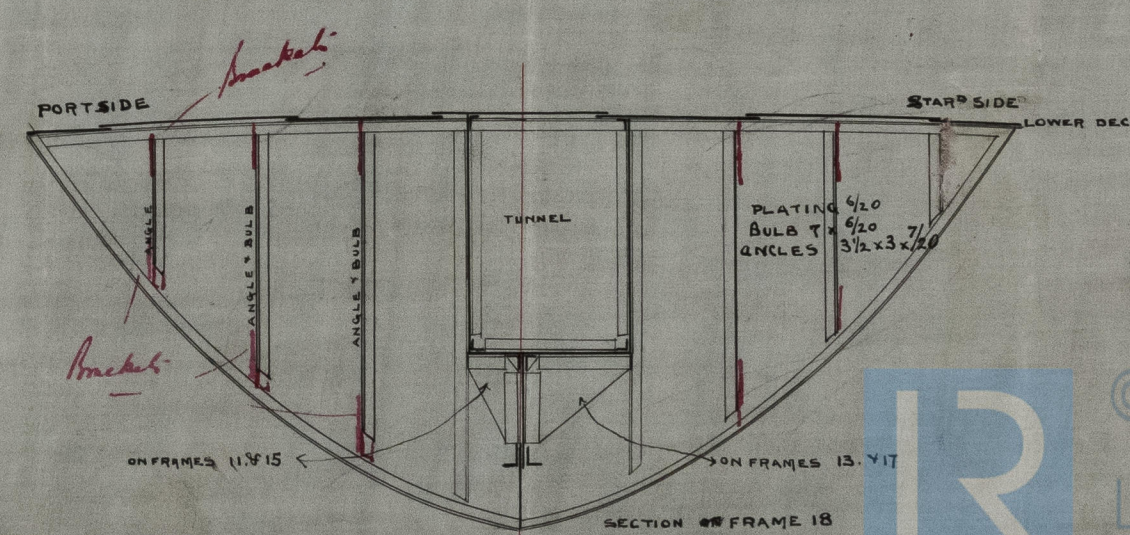
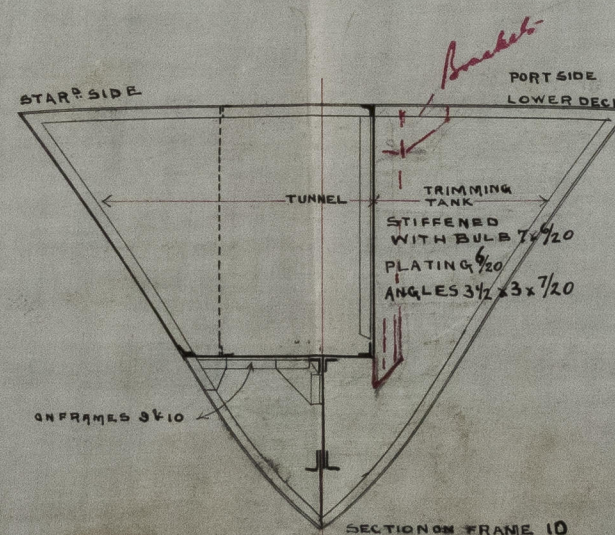
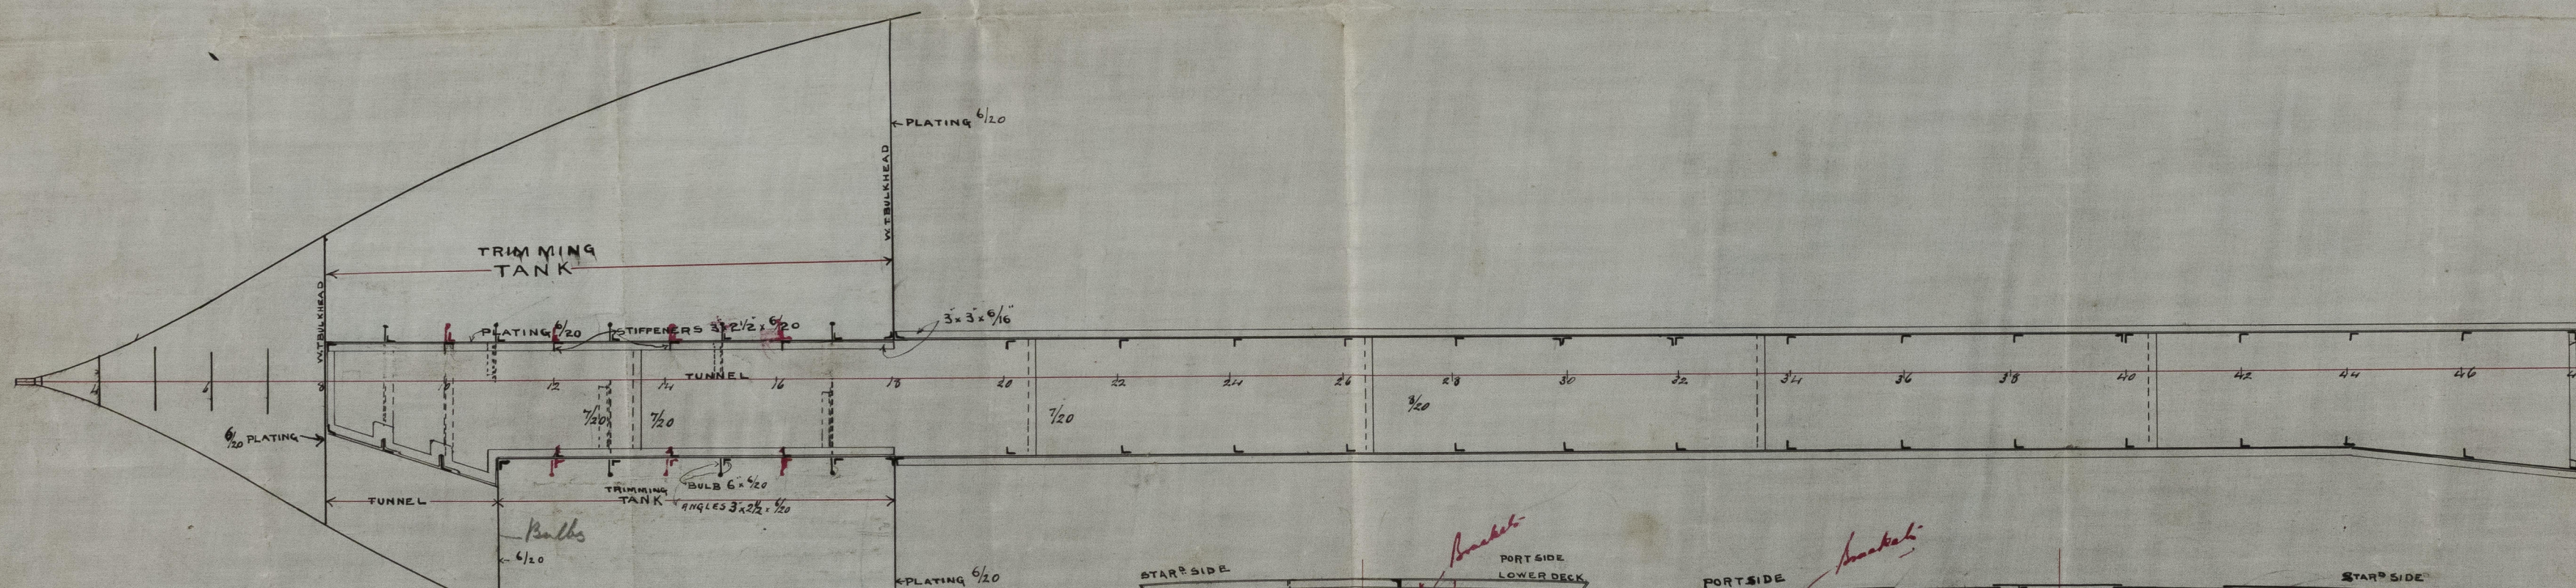


S. S. N° 169

TUNNEL PLAN


SHOWING STIFFENERS IN WAY OF
TRIMMING TANK

SCALE $\frac{1}{4}$ " = ONE FOOT

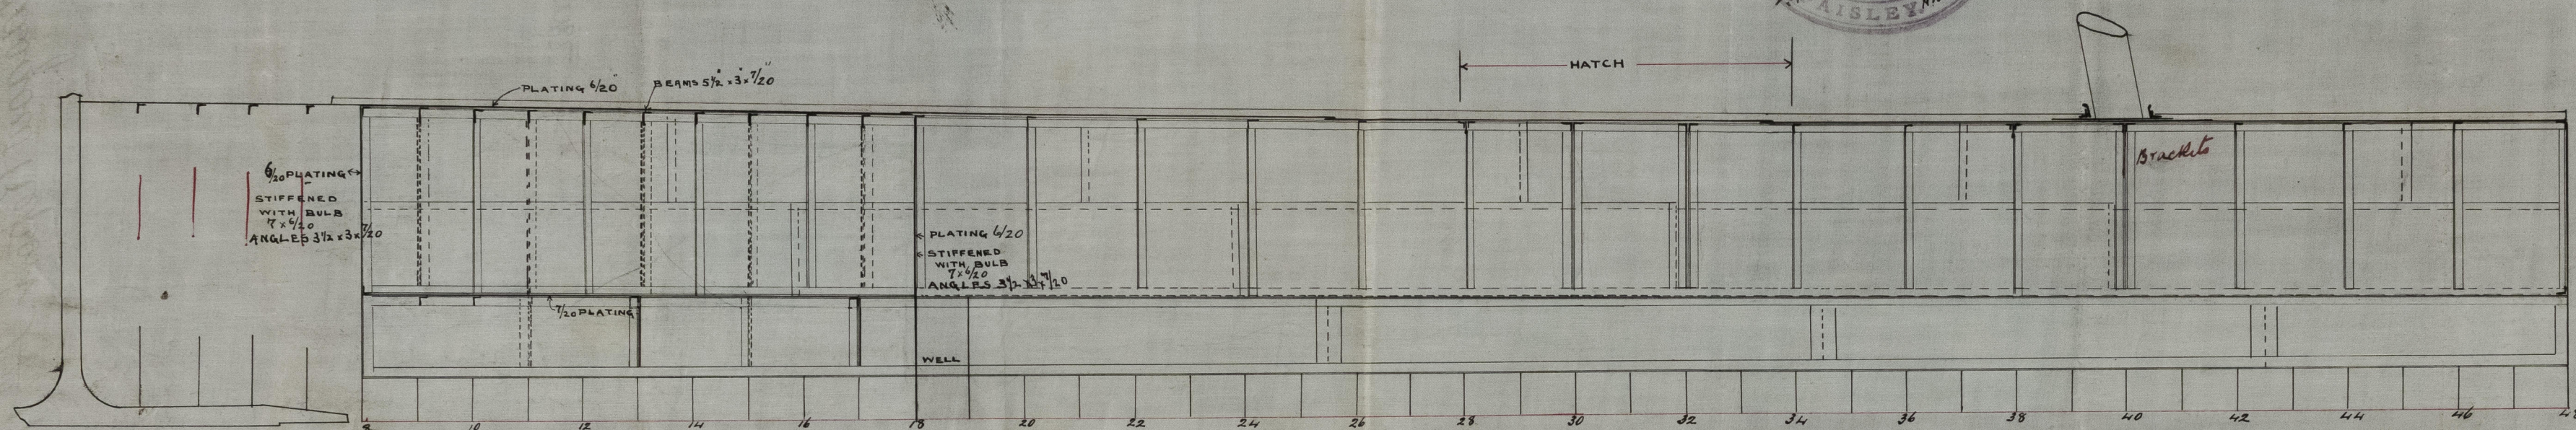


25/1/91

S.S. "Upolu" Glasgow Report No 11198.-

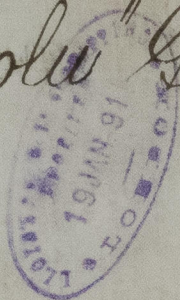

12.1.53

GLS226-0082

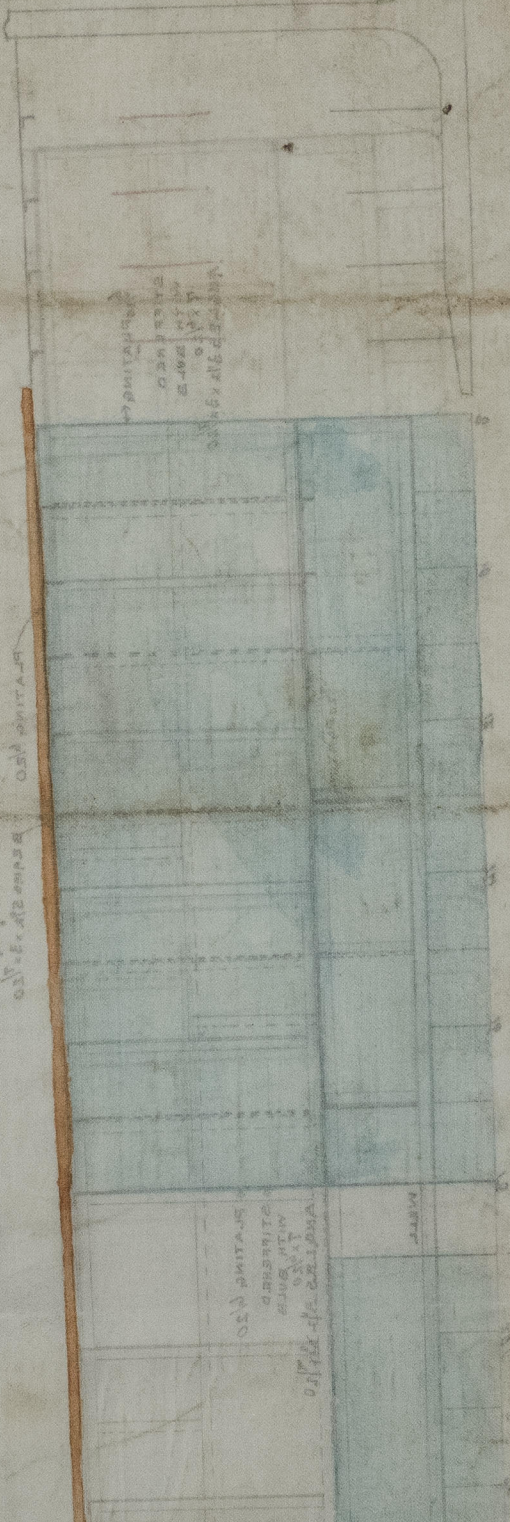

05.0.017.00000 05.0.017.00000



© 2021

Lloyd's Register
Foundation