



Descriptive Longitudinal Sketch of Steel Screw Steamer No 215. + 217  
To Class 100 A.1. 'Knee decked' 'Steel'.  
Scale  $\frac{1}{8}$ th. inch = one foot.




J. P. L.  
6/3/90

 

S.S. "Dunera" Glasgow Report No. 10694.—  
S.S. "Dilwara" — do — " 11201.—

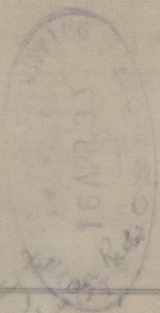

GLS226A - 0015

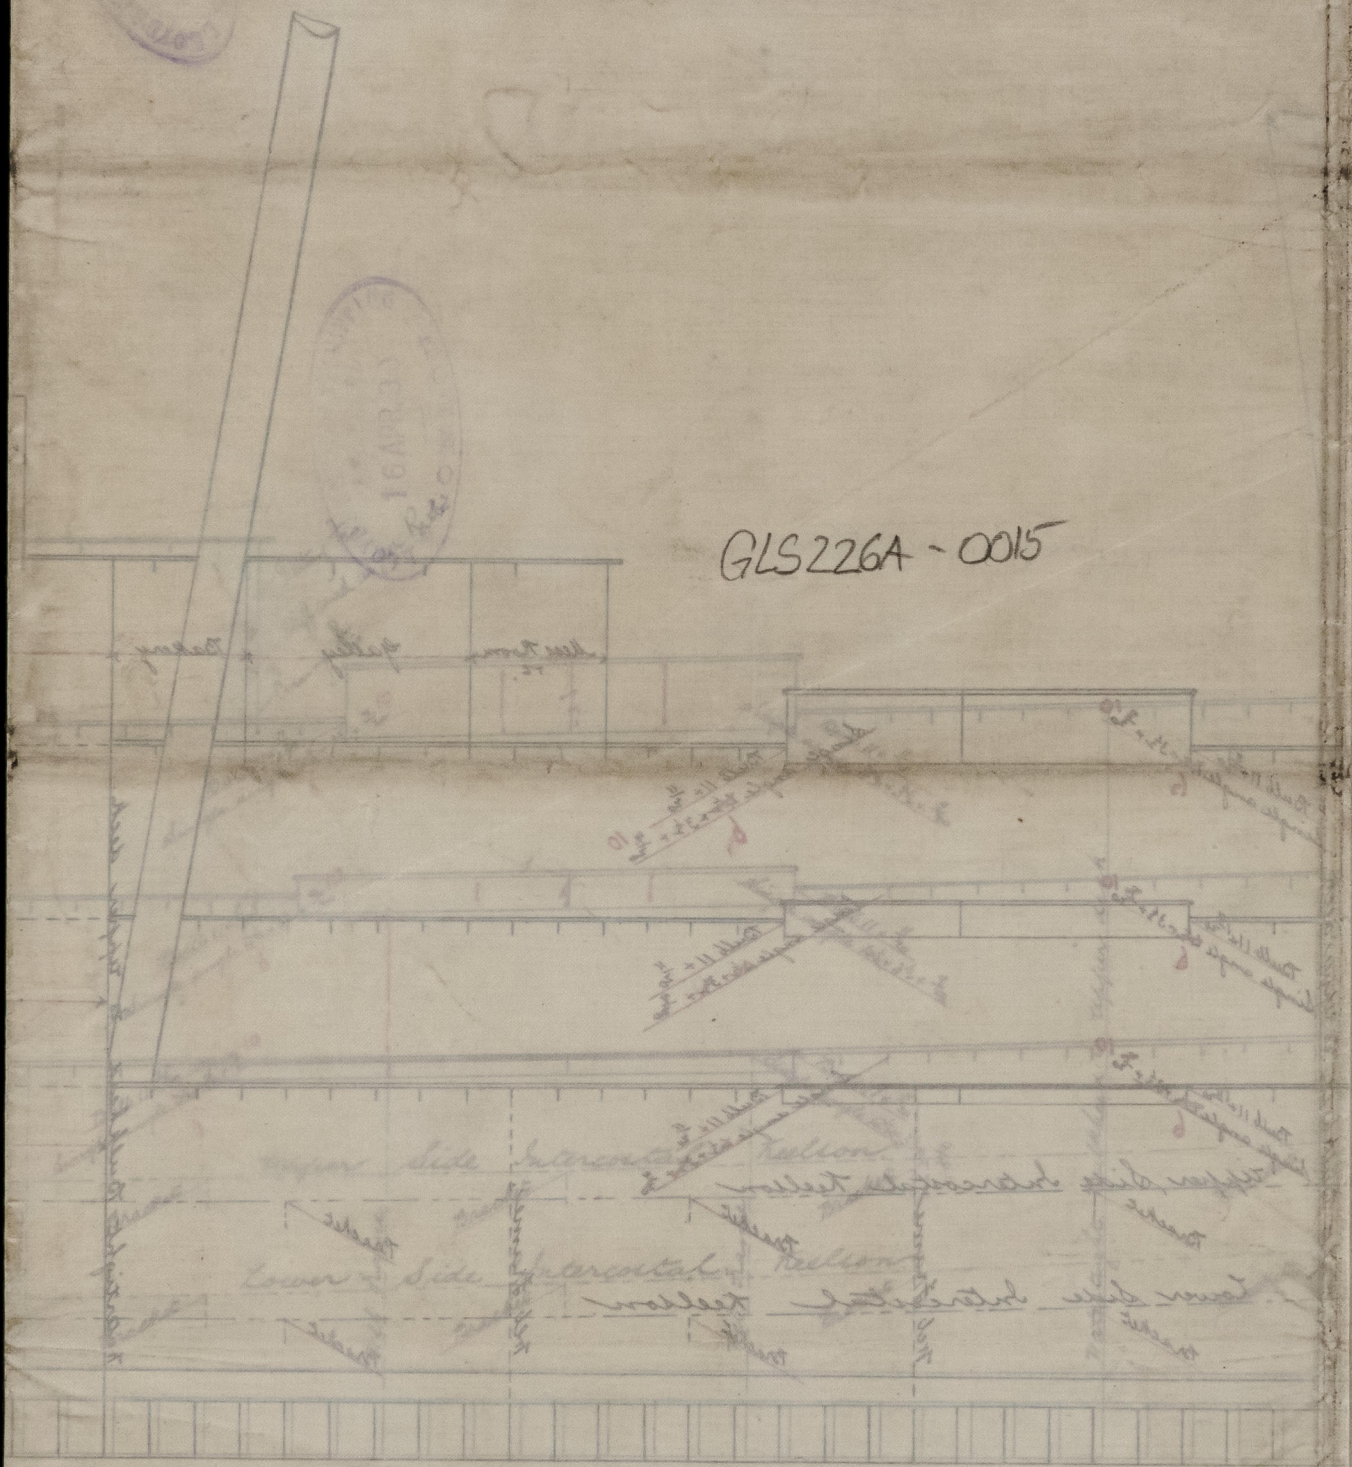

© 2021

Lloyd's Register  
Foundation