

Midship Section of Screw Steamer No. 215

To class 100 A.1. Three decked steel

Scale 1/2 inch = one foot.

SAT 16 SEP 90

THU 8 MAR 90
SAT 16 SEP 90

Have a full Pop extending about 50 feet from sternpost. Topgallant Forecastle extending about 50 feet from stern. Bridge deck amidships about 102 feet long. Combined length of deck sections 242 feet = 61 of 423 feet Forecastle deck beams. See bulk 10 x 12 on alternate frames Pop deck beams. Bulk angle 10 x 12 on alternate frames.

Stringer Plates, Sheerstrakes, Barboard strakes and all Buttstraps when above 3/8 thick, to be carefully annealed, or the holes sufficiently rimmed after punching.

Equipment

- 3 Bower Anchors 45 cwt, ea. stock
- 1 Bower Anchor 3 1/2 cwt, ea. stock
- 1 Stream Anchor 15 1/2 cwt, ea. stock
- 1 Kedg Anchor 7 1/2 cwt, ea. stock
- 1 Kedg Anchor 3 1/2 cwt, ea. stock
- 300 Fathoms 2 1/2 steel chain cable
- 90 Fathoms 1 1/2 stream chain
- 120 Fathoms 1 1/2 hawser, or 1 1/2 steel wire
- 90 Fathoms 12 hawser, or 1 1/2 steel wire
- 90 Fathoms 10 wrap.


Barboard strakes and the after hoods of plating connected to the sternframe, to be the same thickness as strakes amidships. Boss plates and the plates above and below the same to be 3/8 thicker than strakes amidships with butts double strapped, or the boss plates to be doubled.

Web frames in C & B. space, spaced 4 frame spaces apart. Channel plating 3/8 Transverse angles 4 1/2 x 3 1/2 x 3/8 spaced 4 ft apart, and 3 feet inway of hatchways.

Rummers		Proportions	
Half Breadth	24.0	Breadths in Length	5.512
Half Girth	52.2	Depths to upper deck	12.74
Depth to keel	33.2	Depths to main deck	16.75
	109.4		
Deduct	7.0		
	102.4		
	102.4 x 423 =		43315 scantling lumber
	109.4 x 423 =		46276
Forections add 64 of 5784 =	3728		
	49804		Equipment Rumber
	49977		

Frames 6 x 3 1/2 x 3/8 for 3/8 L. to 6 x 3 1/2 x 3/8 at ends. Spaced 25 apart throughout. Reverse frames 4 1/2 x 3 1/2 x 3/8 all to extend to upper deck for 3/8 L. amidships and all abaft aft peak bulkhead. In way of Forecastle to extend to main and Forecastle decks alternately. Remainder to extend to upper and main decks alternately. Doubled from bilge to bilge in C & B. space. Bulkheads 3/8 below. 3/8 above. Vertical stiffeners, angle 6 x 3 1/2 x 3/8 spaced 30 inches. Horizontal stiffeners bulk angle 8 x 3 1/2 x 3/8 spaced 18 inches apart below main deck. Hold pillars in centre of main beams for 3/8 L. amidships. on every frame at ends. Side pillars on main beam for 3/8 L. amidships. Stem 10 x 3 1/2 x 3/8 at head. Sternpost 11 1/2 x 7 1/2 x 3/8 fore post 12 x 7 1/2 and carried up to upper deck. Rudder stock 10 dia. at head to 5 at keel.

Riveting. The butts of upper and main deck stringer plates to be lapped and treble rivetted all fore and aft. The butts of main deck stringer plates to be lapped and double rivetted all fore and aft. Butts of steel decks lapped and double rivetted throughout. Deck landings single rivetted. Butts of shell plating treble rivetted all fore and aft. From bilge to upper deck sheerstrake for about 3/8 L. amidships buttstraps to be 3/8 thicker than plates with two stiffening angles 4 1/2 x 3 1/2 x 3/8 to be fitted across each buttstrap. Remainder of buttstraps to be 3/8 thicker than plates, treble rivetted, with back row of rivets spaced 5 diameters apart centre to centre. Butts of upper deck sheerstrake treble rivetted with buttstraps fitted outside. Butts of upper deck sheerstrake doubling treble rivetted with buttstraps fitted inside. Butts of Pop Bridge & Forecastle side plating double rivetted. Fore sternpost from keel to after end of arch treble rivetted. Keel, stem and remainder of sternpost double rivetted. Strakes below sheer to have double buttstraps 3/8 and 3/8 thick respectively.

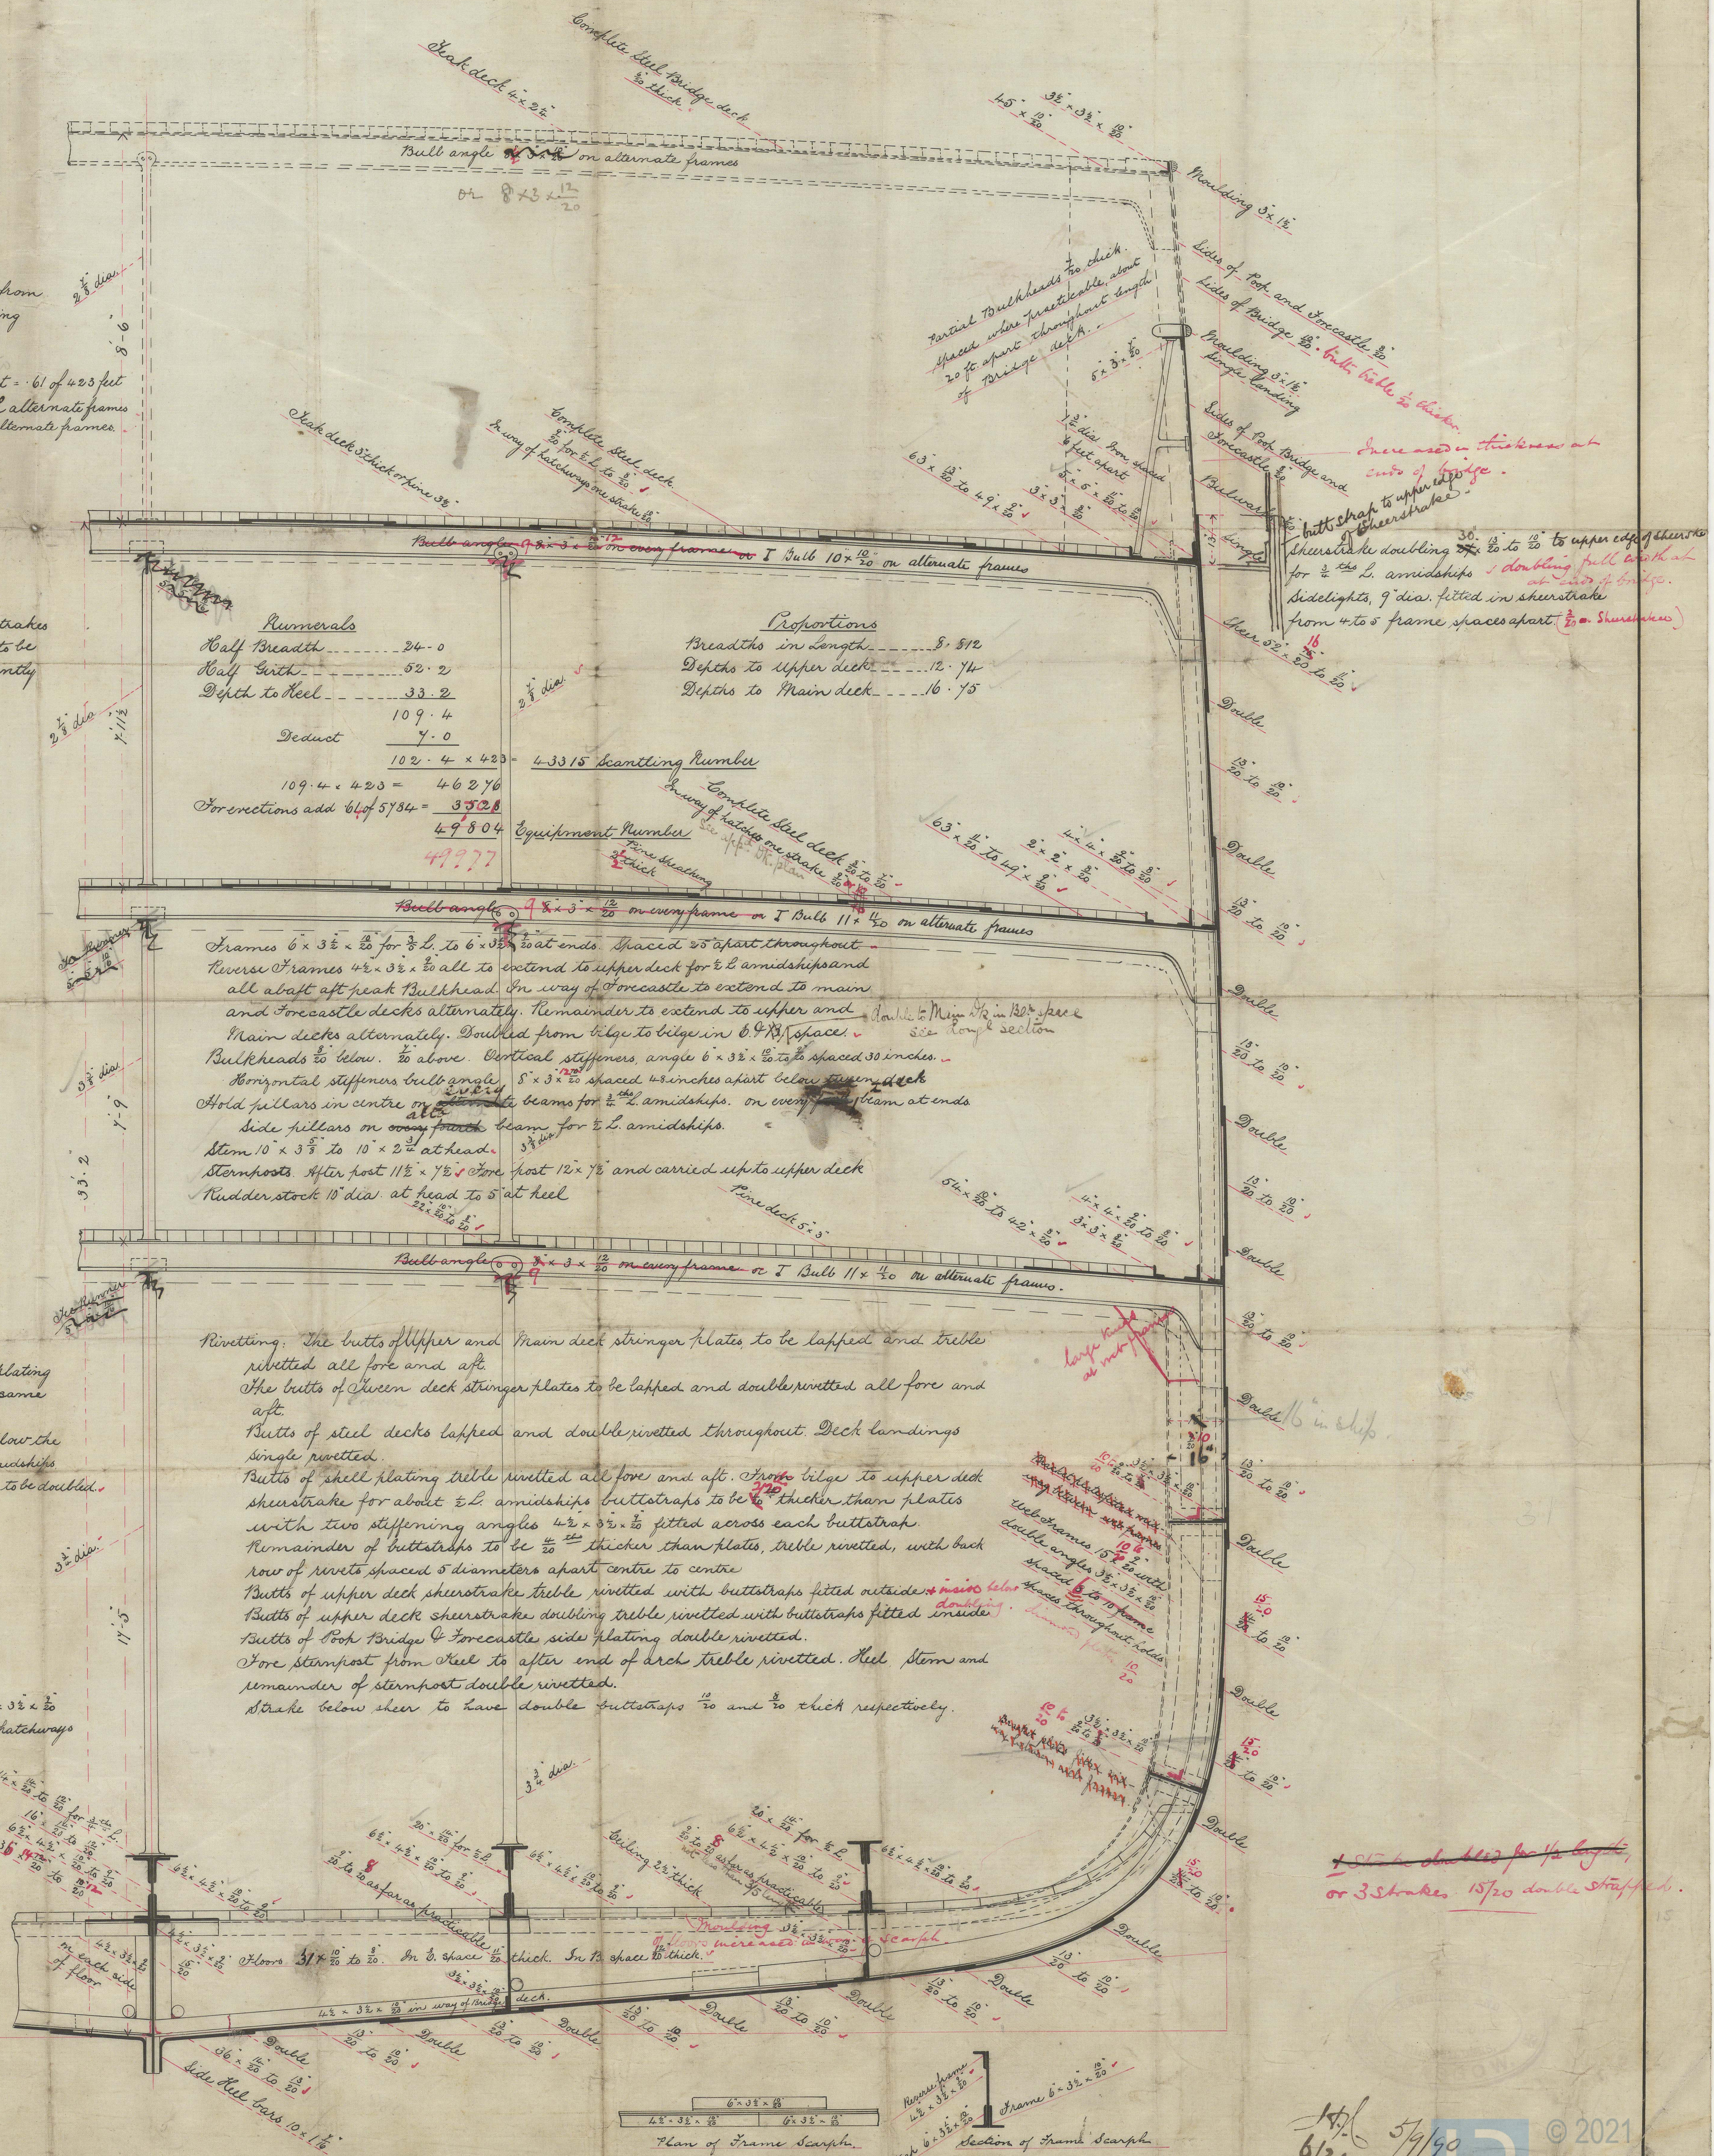

10 1/2 in. double for 1/2 length, or 3 strakes. 15/20 double strapped.

S S "Dunera" Glasgow Report A# 10694.-
 S S "Dilwara" — do — "



GLS226A-0017

[Faint handwritten notes, likely bleed-through from the reverse side of the page.]

© 2021
 Lloyd's Register
 Foundation