

# Lloyd's Register of British and Foreign Shipping.

*Glasgow* (Report on Vessel No. *11669* Port *Glasgow*)  
*Ship "Yolda."*

## No. *2279-a* SHIP FORGINGS OR CASTINGS.

The words FORGINGS or CASTINGS, IRON or STEEL, should be struck out as may be required.

I have to report that the undermentioned Iron or ~~Steel~~ Forgings or Castings, manufactured by

*Messrs R S Bagnall & Sons* of *Wylton*  
for the Vessel No. *8/T*, being built by *Messrs John Reid & Co*  
of *Glasgow* have been inspected by me as set forth below, and found  
to be, so far as can be seen, *sound*



Mark on Forgings.

Lloyd's  
No. *2279-a*  
*266*

*Rush Cameron*  
*Sunderland*  
*57592*

	STERN FRAME.	RUDDER FRAME.	STEM.
Material* - - - -	<i>Scrap iron</i>	<i>Scrap iron</i>	<i>Scrap iron</i>
How made - - - -	<i>Forged</i>	<i>Forged</i>	<i>Forged</i>
Dimensions - - - -	<i>8 1/2" x 2 1/2"</i>	<i>6 1/4" - 3 1/4"</i>	<i>8 1/2" x 2 1/2"</i>
Progress on Inspection -	<i>Forged &amp; Smithed</i>	<i>Forged &amp; Smithed</i>	<i>Forged</i>
Dates when Inspected	<i>July 10-20-25/92</i>	<i>March 16 &amp; April 12/92</i>	<i>July 27/92</i>

SKETCHES OF FRAMES SHEWING POSITION AND DESCRIPTION OF WELDS OF FORGINGS, OR PARTICULARS OF TESTS APPLIED TO CASTINGS.

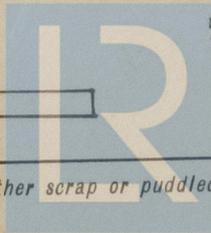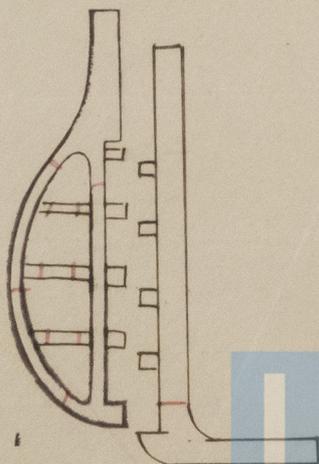

© 2021

*Welds*

Lloyd's Register  
Foundation

\* If of Iron, state whether scrap or puddled Iron.