

3.2.92
 7.2.92
 33

Pop. Beams $6 \times \frac{1}{2}$ buld Angle.

Pop. Side plating $\frac{1}{16}$

Hatch $\frac{3}{16}$

Main Deck Beams - $9 \times 5 \frac{1}{2} \times \frac{2}{20}$
 $4 \times \frac{1}{2}$ angles $3 \frac{1}{2} \times 3 \frac{1}{2} \times \frac{1}{16}$

Tween Deck Beams $10 \times 6 \times \frac{1}{20}$
 $4 \times \frac{1}{2}$ buld 4 angles $3 \frac{1}{2} \times 3 \frac{1}{2} \times \frac{1}{16}$

Hatch $\frac{3}{16}$

Hatch Beams Buld $9 \frac{1}{2} \times \frac{1}{16}$
 and one angle $6 \times 3 \frac{1}{2} \times \frac{1}{16}$

Hatch $\frac{3}{16}$

Hatch Beams Buld $9 \frac{1}{2} \times \frac{1}{16}$
 and one angle $6 \times 3 \frac{1}{2} \times \frac{1}{16}$

Bulb $8 \times \frac{1}{16}$ angle

Bulb $8 \times \frac{1}{16}$ Rafter $3 \times 3 \times \frac{1}{16}$

Wing houses

Side plating $\frac{1}{16}$

1" above deck

Angle $3 \frac{1}{2} \times 3 \frac{1}{2} \times \frac{1}{16}$

Chain Traker

Butting stringer

Side stringer

Side stringer

Butt Keelson

Breasthook $\frac{10}{16}$

Breasthook $\frac{10}{16}$

PROFILE
 SHIP No 8/T
 SCALE $\frac{1}{4}$ INCH = 1 FT.

JOHN REID & CO
 SHIP BUILDERS
 GLASGOW

29-1-92
 J.R.
 1.2.92

26/1/92

GLS229-0178


Ship "Yola" Glasgow Report No 11669

Boat beam

22

22 1/2
22 1/2
22 1/2

GLS229-0178

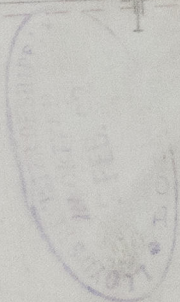


PROFILE

SHIP NO 8/1

1/4 INCH = 1 FT.

10 1/2
10 1/2

10 1/2
10 1/2

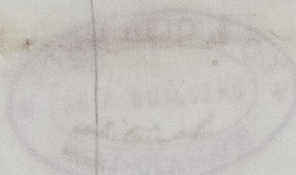

24-1-92

Q.Q.O.

1.2.92

26/1/92



© 2021

Lloyd's Register
Foundation