

27. 2. 92.


34

Main Deck

DECK PLAN
No 8/T
SCALE - 1/4 INCH = 1 FOOT.

JOHN REID & CO
SHIP BUILDERS
GLASGOW



24/1/92
J.S. 2.92

 

Pooh

Lower Deck


Monkey Forecastle

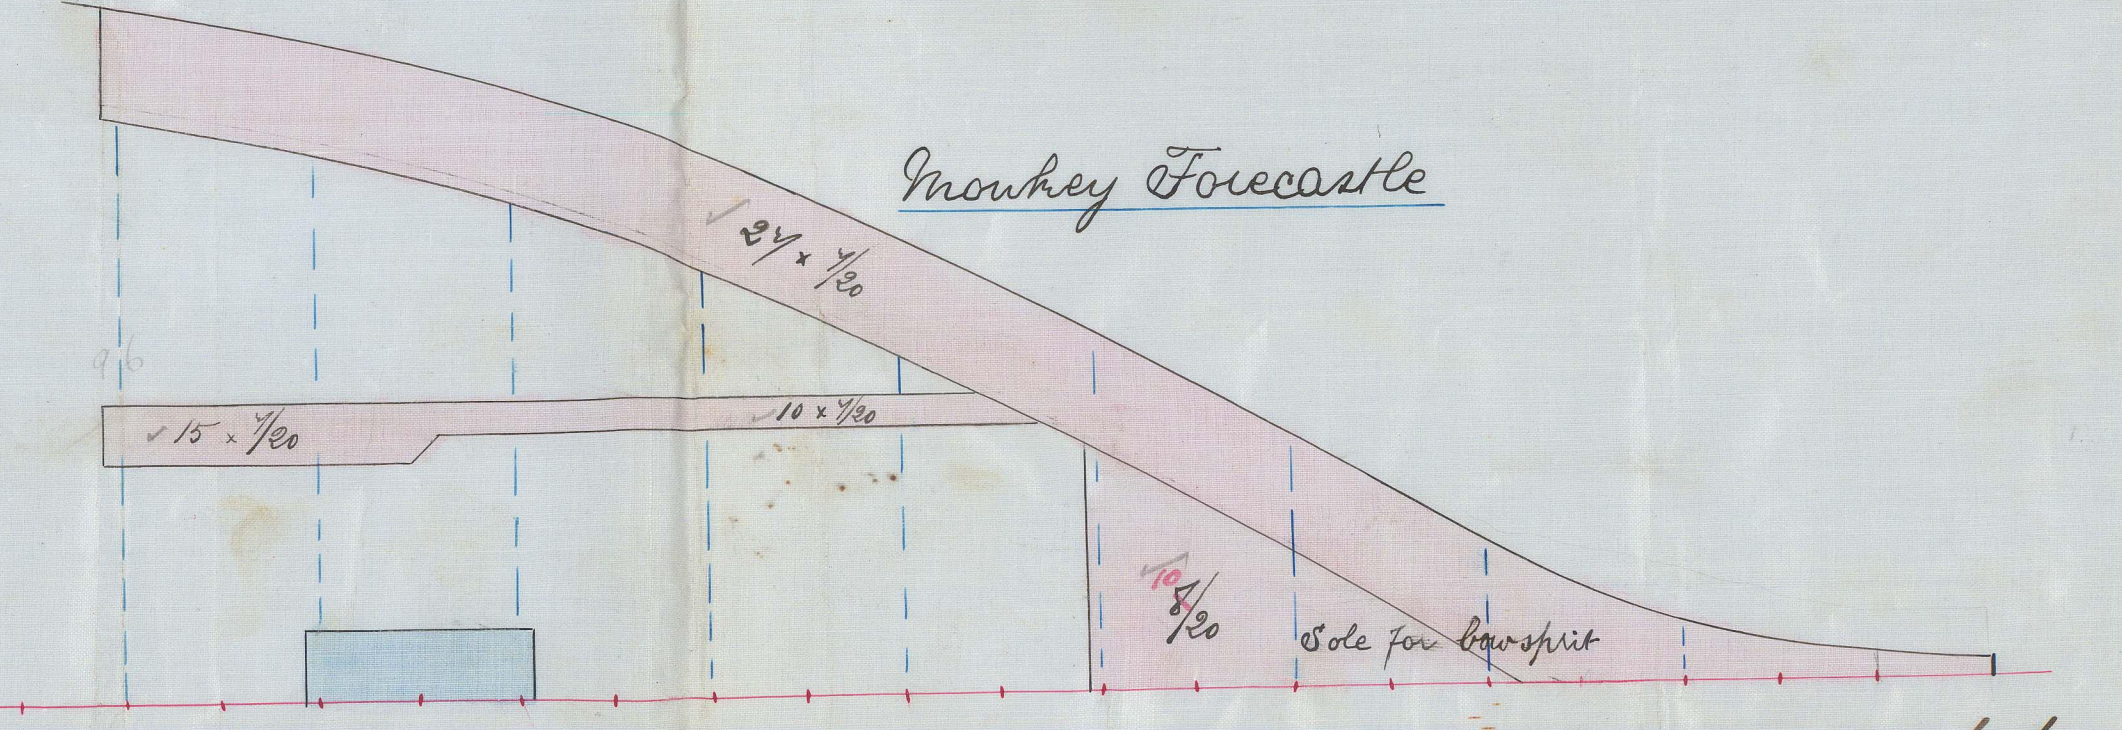 

24/1/92

Ship "Yola" Glasgow Report No 11669.-


GLS 229-0179

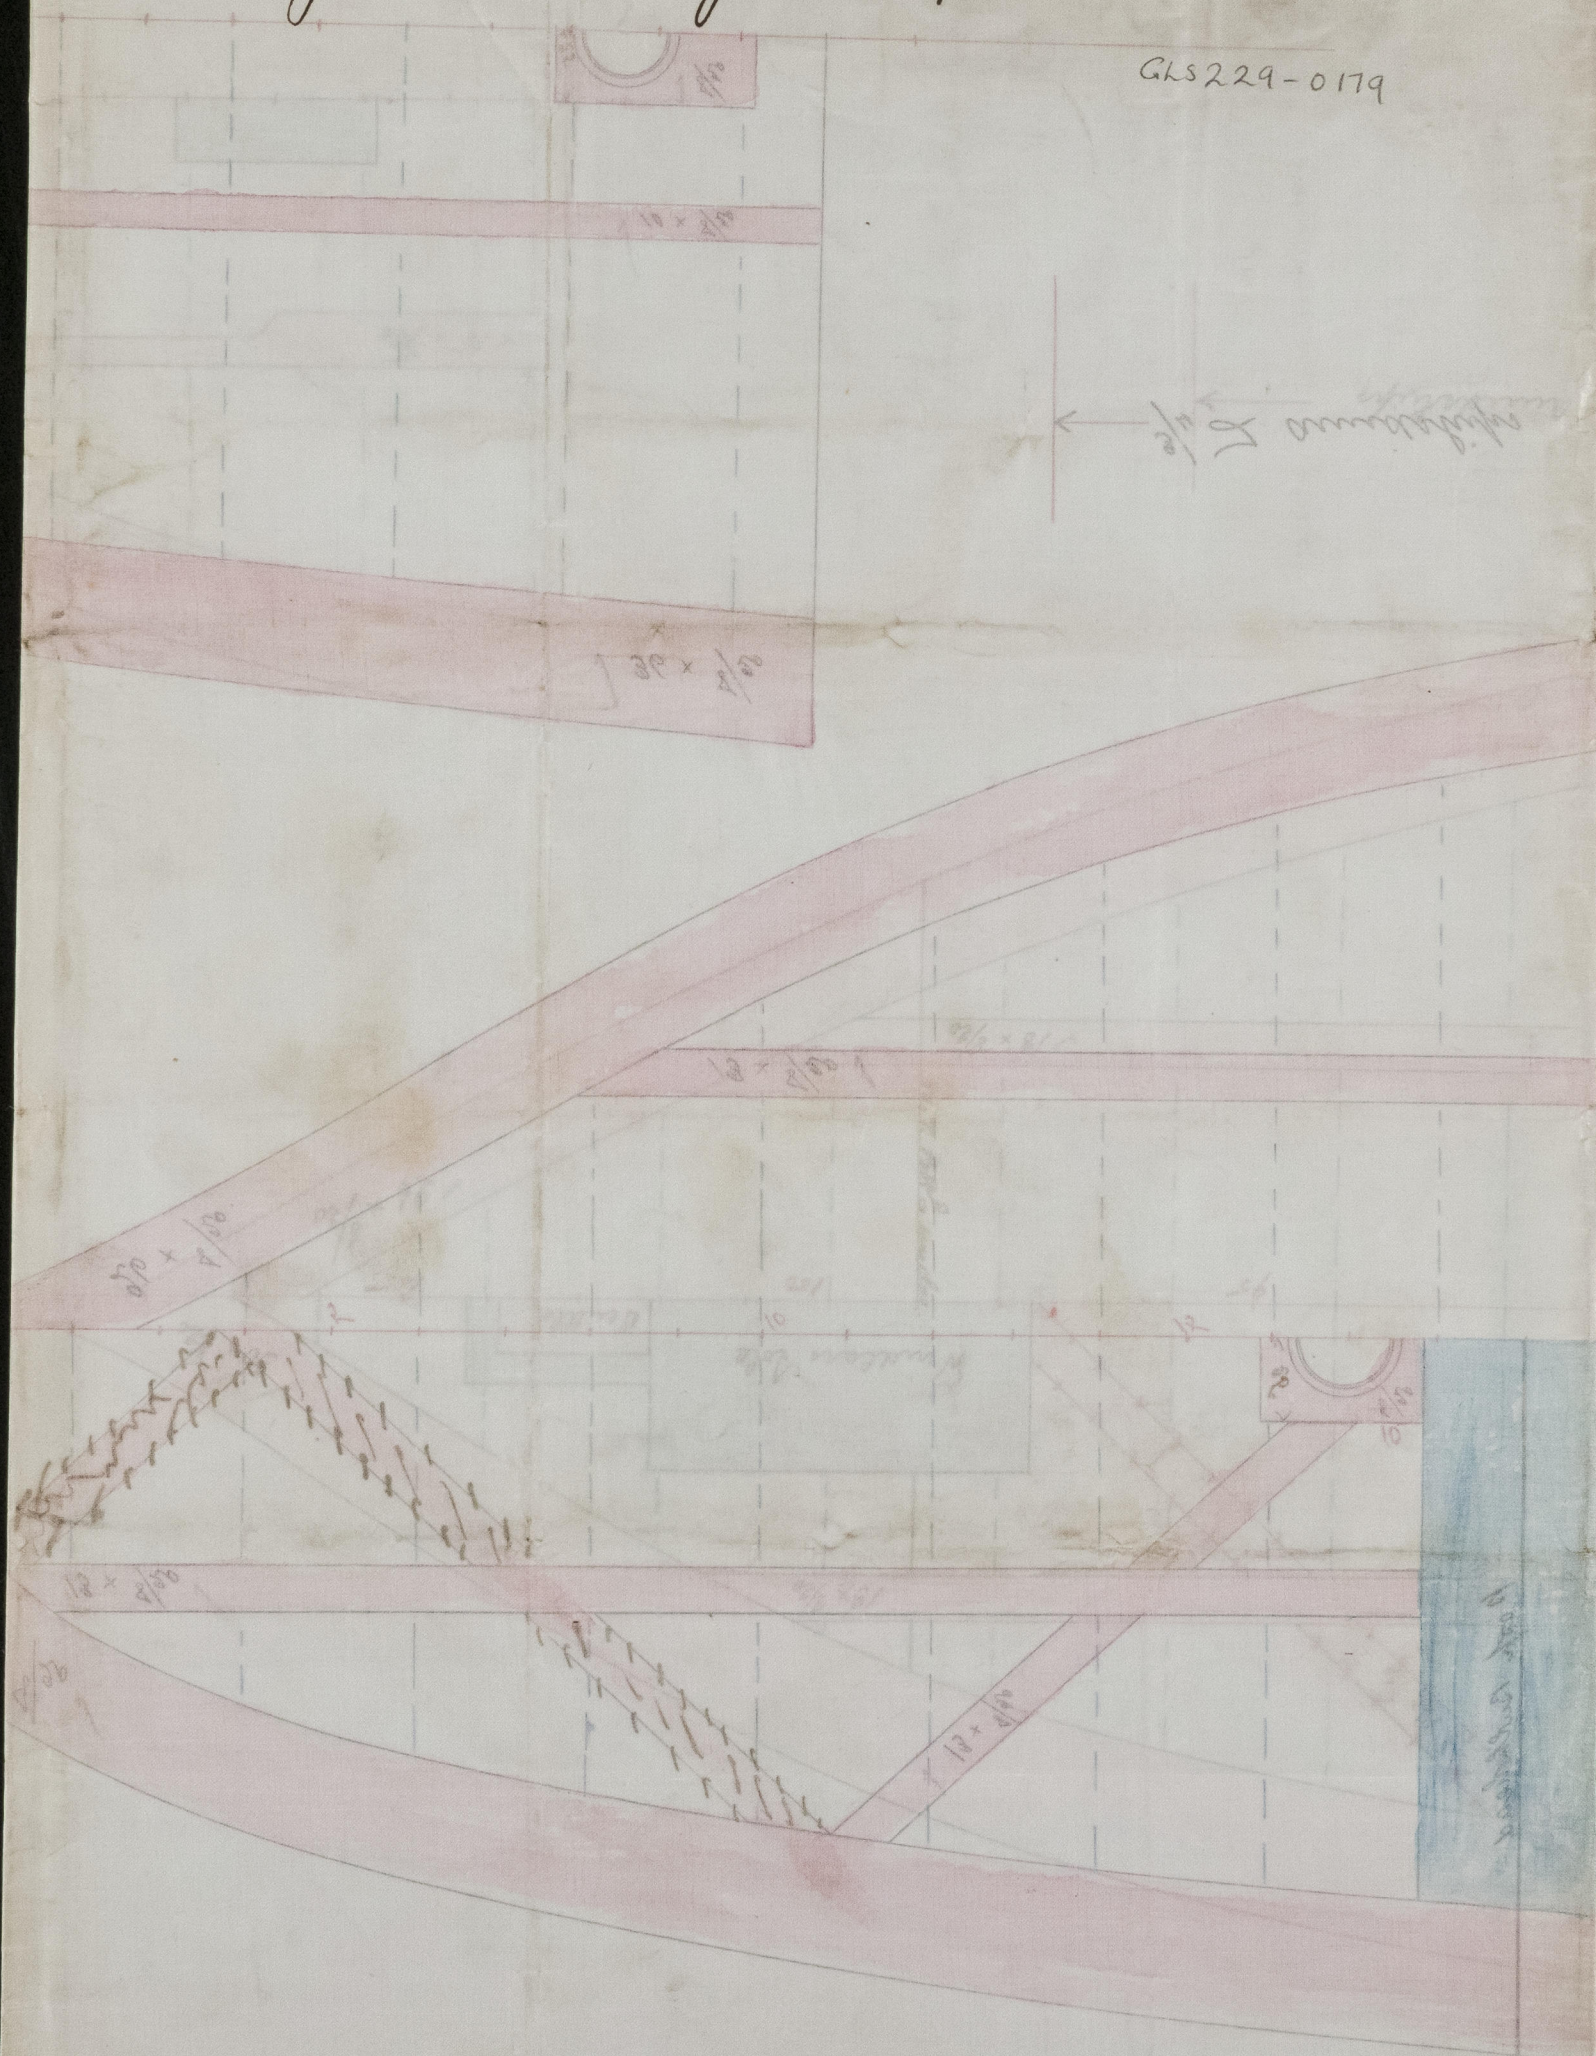

© 2021

Lloyd's Register
Foundation

0179

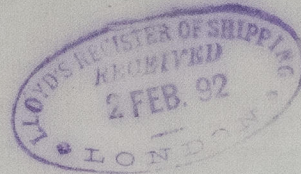

James Smith