


171
N^o 8/T

Proposed alteration to Stays
scale 1/8" = one foot



Position of stays as fitted.
Alteration made to suit Owners.
J. S.
4.6.92

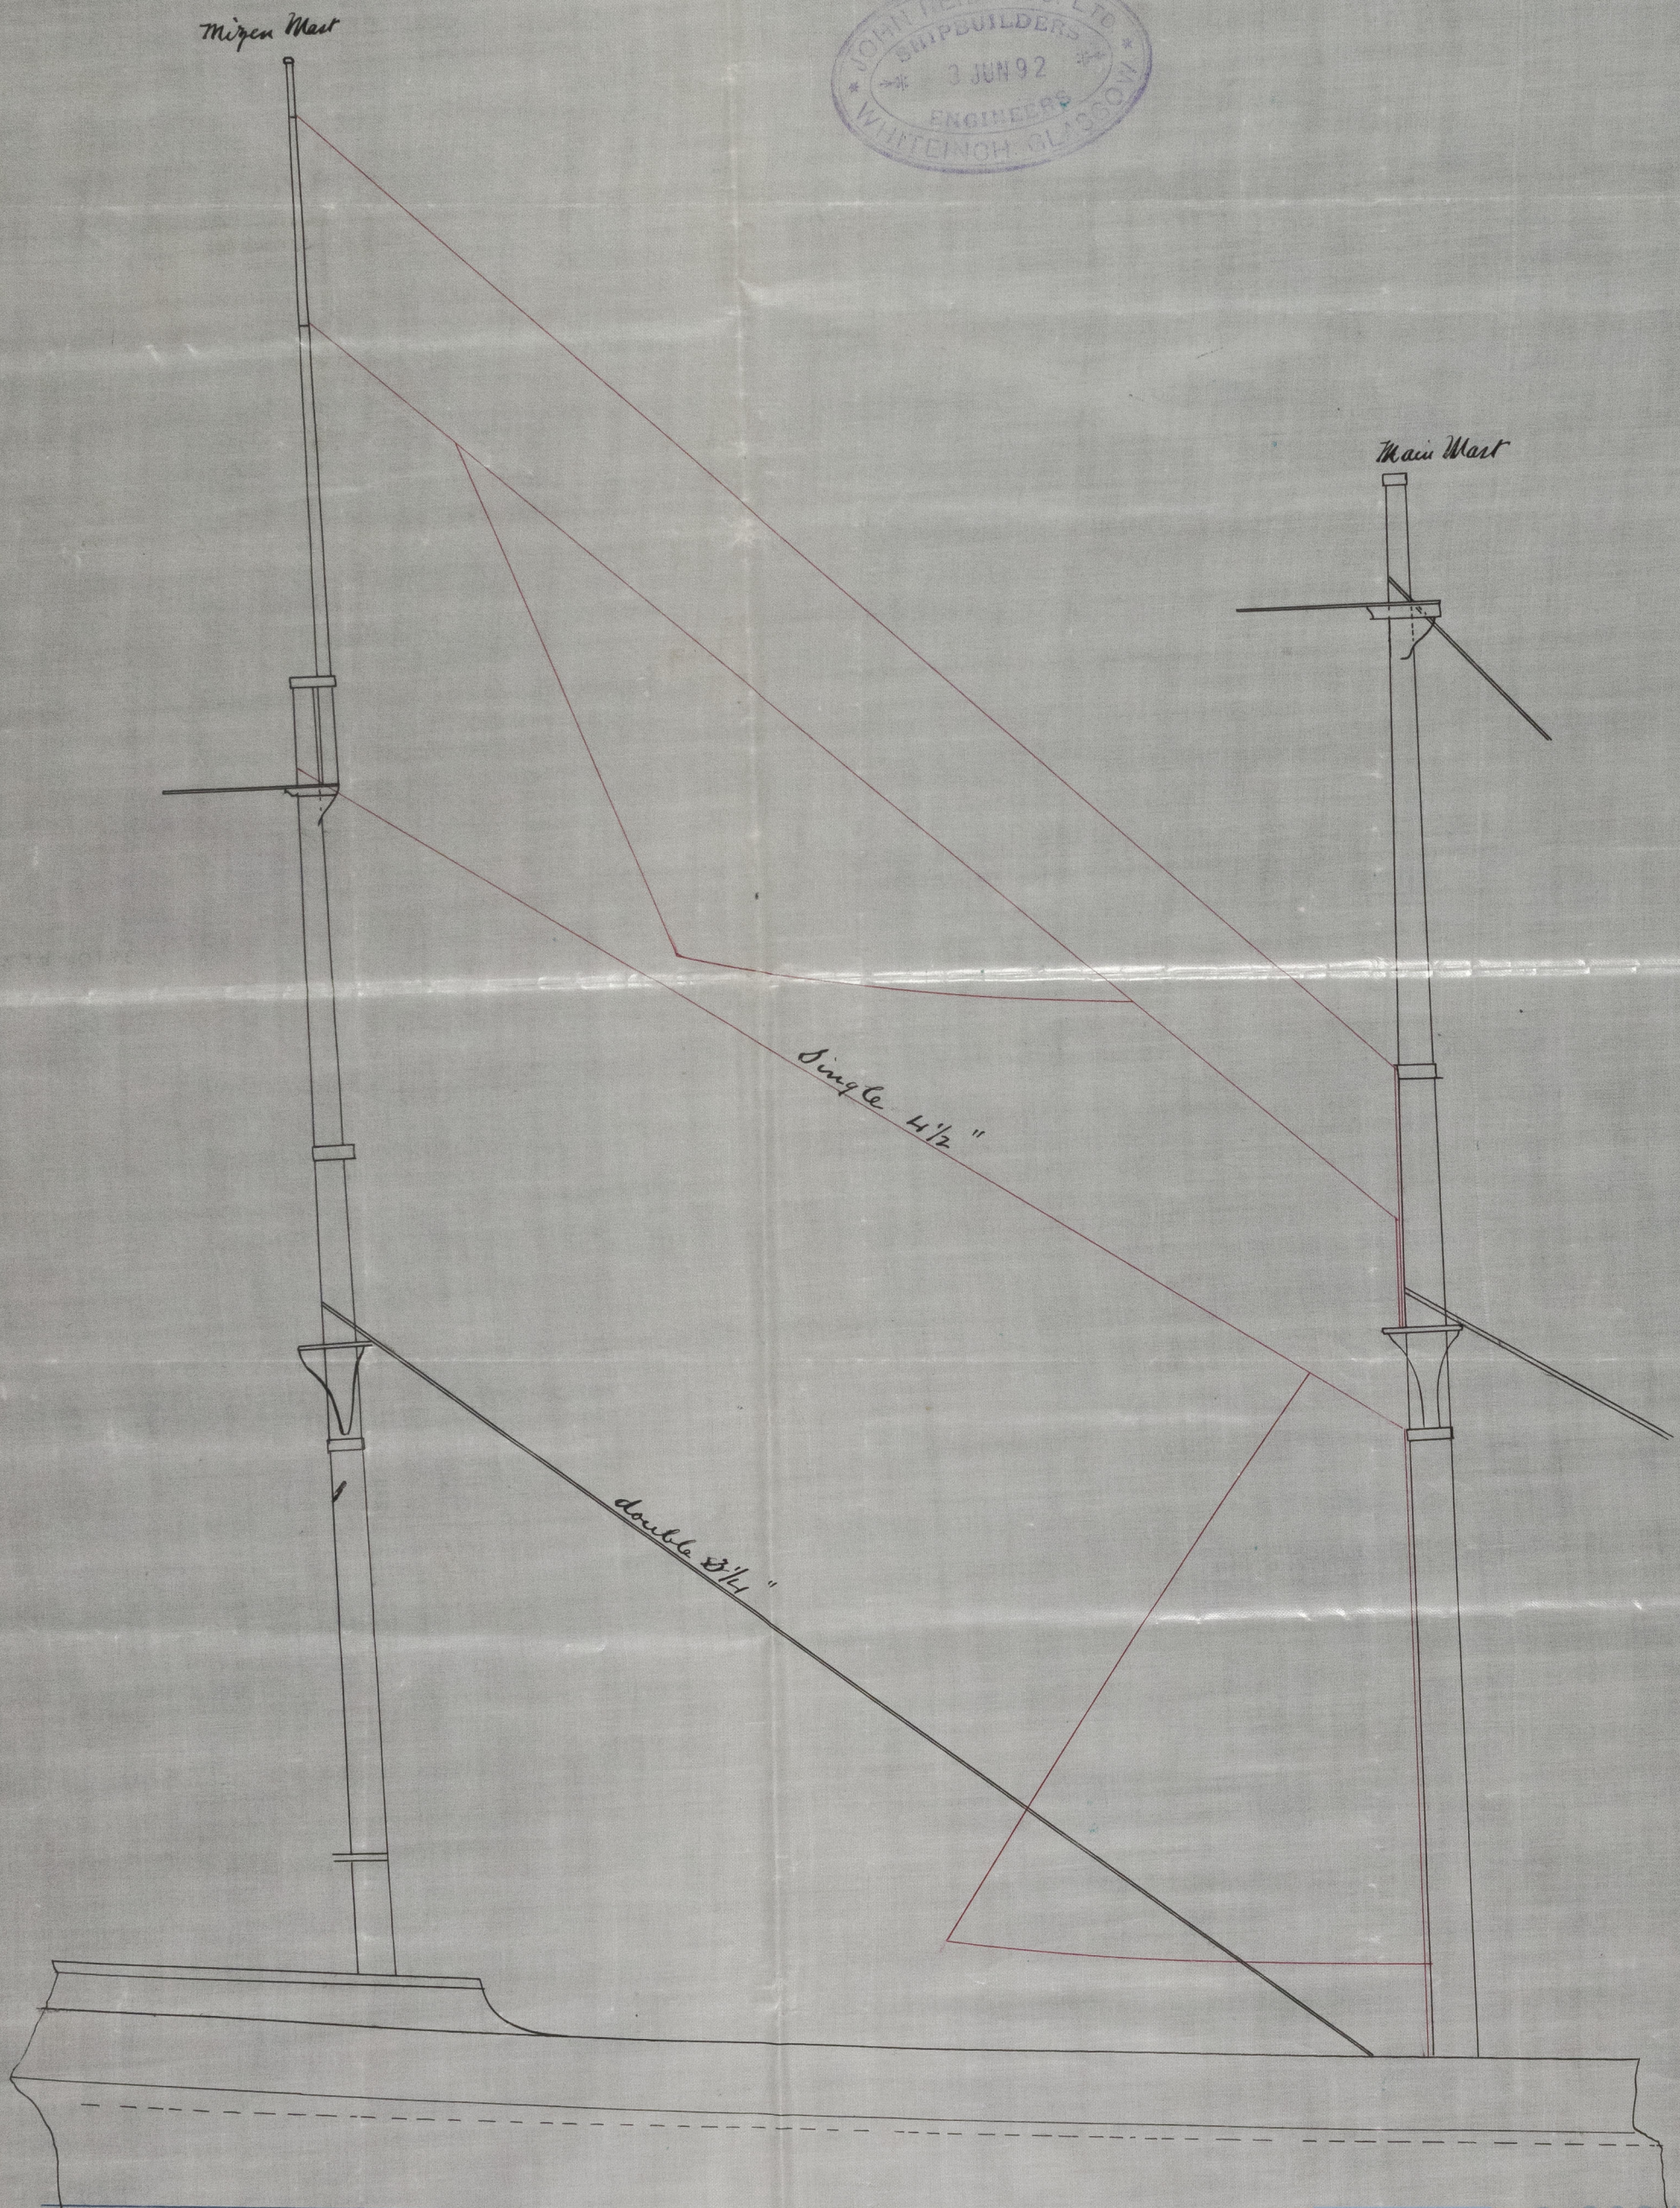

© 2021

Lloyd's Register
Foundation