

# Lloyd's Register of British and Foreign Shipping.

(Report on Vessel No. 11450 Port Glasgow)

S.S. "Plover"

No. 3600 SHIP FORGINGS ~~OR CASTINGS~~

The words FORGINGS or CASTINGS, IRON or STEEL, should be struck out as may be required.

I have to report that the undermentioned Iron or ~~Steel~~ Forgings or Castings, manufactured by The Irvine Forge Coy of Irvine for the Vessel No. 95 being built by Messrs Scott & Coy of Bowling have been inspected by me as set forth below, and found to be, so far as can be seen, Sound & efficient



Mark on Forgings.

Lloyd's  
No. 3600  
W.H.

William Hamilton  
Glasgow  
8/7/92

	STERN FRAME.	RUDDER FRAME.	STEM.
Material* - - - -	/	Scrap iron	/
How made - - - -		Forged	
Dimensions - - - -		3 1/2 to 2	
Progress on Inspection -		Forging & smithing	
Dates when Inspected			

SKETCHES OF FRAMES SHEWING POSITION AND DESCRIPTION OF WELDS OF FORGINGS, OR PARTICULARS OF TESTS APPLIED TO CASTINGS.

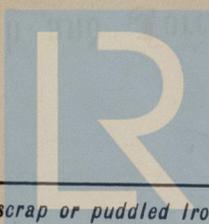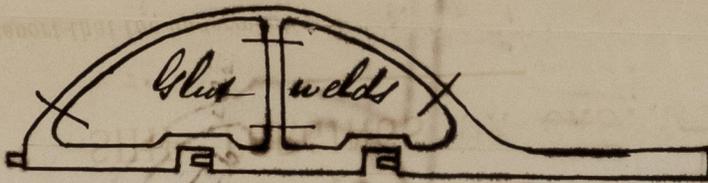

© 2021

Lloyd's Register  
Foundation