S.S. "Plover"
as built 29/8/92

SCOTT & CO.
SHIPBUILDERS
16/8/92
BOWLING, NR GLASGOW

S. S. No. 95

Scale ½" = One Foot

Classed 100 A Special Survey

Framework Iron
Shell Plating Steel

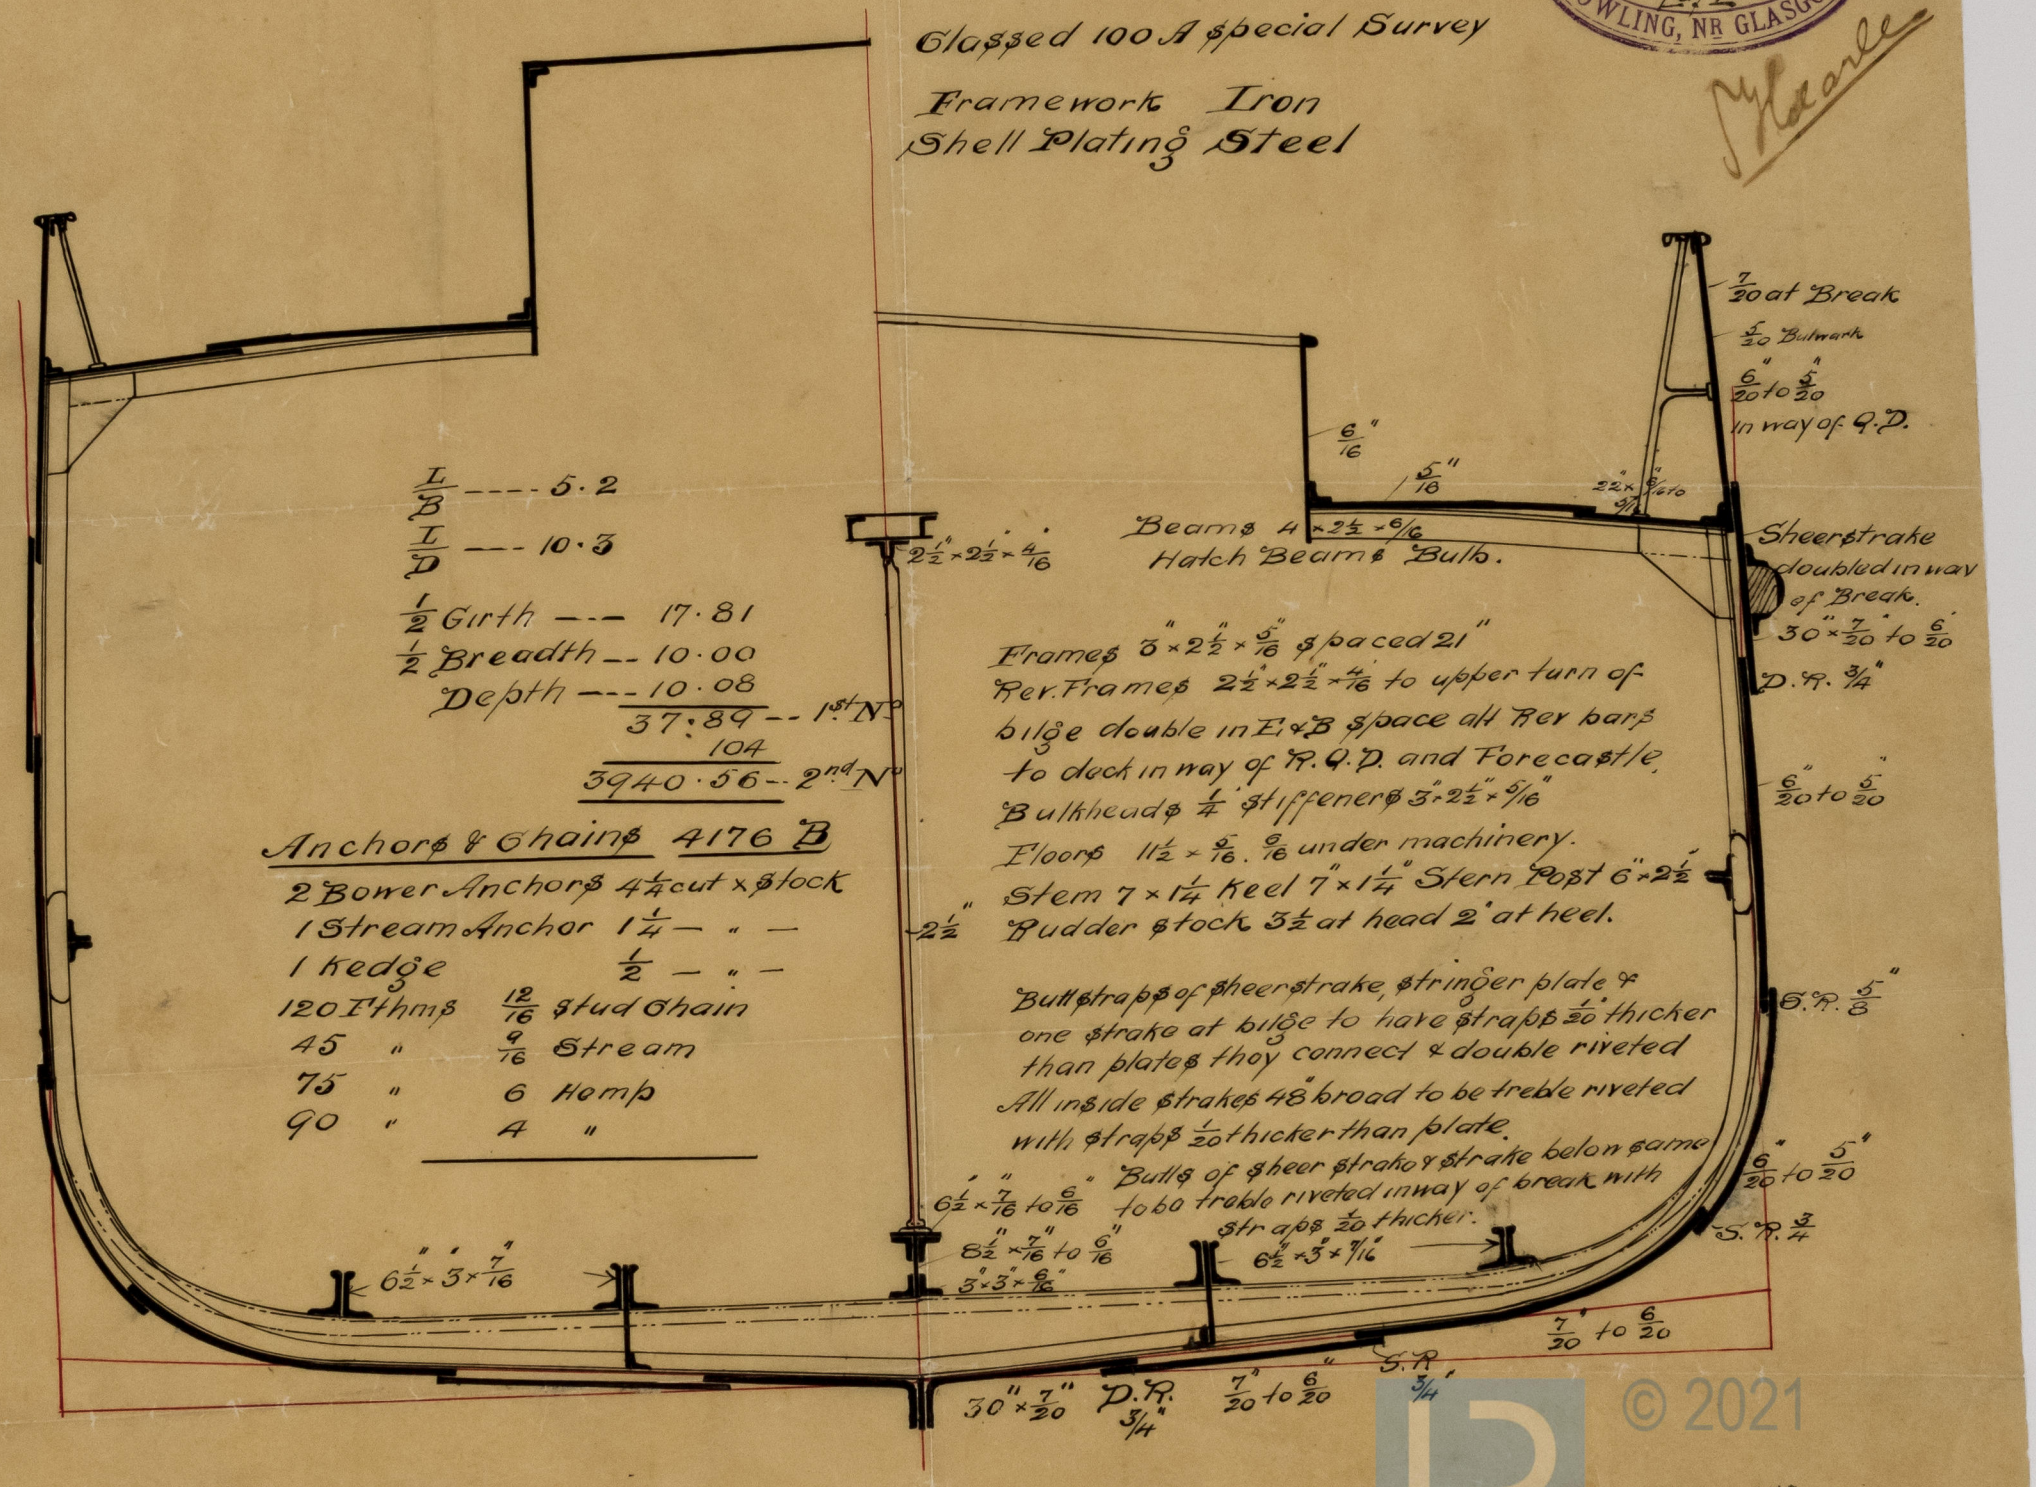

L/B ---- 5·2
L/D ---- 10·3

½ Girth --- 17·81
½ Breadth -- 10·00
Depth --- 10·08
37·89 -- 1st No
104
3940·56 -- 2nd No

Frames 3" × 2½" × 5/16" spaced 21"
Rer. Frames 2½" × 2½" × 4/16" to upper turn of bilge double in E & B space all Rer bars to deck in way of R.Q.D. and Forecastle.
Bulkheads ¼" Stiffeners 3" × 2½" × 5/16"
Floors 11½ × 5/16. 6/16 under machinery.
Stem 7 × 1¼ Keel 7" × 1¼" Stern Post 6" × 2½"
Rudder stock 3½ at head 2" at heel.

Butt straps of sheerstrake, stringer plate & one strake at bilge to have straps 1/20" thicker than plates they connect & double riveted
All inside strakes 48" broad to be treble riveted with straps 1/20 thicker than plate.
Butts of sheer strake & strake below same to be treble riveted in way of break with str aps 1/20 thicker.

Anchors & Chains 4176 B

2 Bower Anchors	4¼ cwt	× Stock
1 Stream Anchor	1¼	" "
1 Kedge	½	" "
120 Fathms	12/16	Stud Chain
45 "	9/16	Stream
75 "	6	Hemp
90 "	4	"

© 2021
Lloyd's Register Foundation
GLS230-0110

© 2021 Lloyd's Register Foundation
Q 152230-0110





















