

Lloyd's Register of British and Foreign Shipping.

(Report on Vessel No. 11899

Port

Glasgow
"Horsing."No. 3771SHIP FORGINGS ~~OR CASTINGS~~.

The words FORGINGS or CASTINGS, IRON or STEEL, should be struck out as may be required.

I have to report that the undermentioned Iron or ~~Steel~~ Forgings or Castings, manufactured byThe Irvine Forge Co

of

Irvinefor the Vessel No. 60, being built by Messrs Mackie & Thomsonof Glasgowhave been inspected by me as set forth below, and found to be, so far as can be seen, Sound & efficient



Mark on Forgings.

Lloyd's

No. 3771W.H.William HamiltonGlasgow26/8/92

	STERN FRAME.	RUDDER FRAME.	STEM.
Material*	/	Scrap iron	/
How made		Forged	
Dimensions		4 1/2 to 2 3/4	
Progress on Inspection .		Forging & smithing	
Dates when Inspected {		21/6/92. 5. 12. 14. 26/7/92. 26/8/92	

SKETCHES OF FRAMES SHEWING POSITION AND DESCRIPTION OF WELDS OF FORGINGS, OR PARTICULARS OF TESTS APPLIED TO CASTINGS.

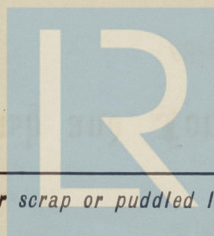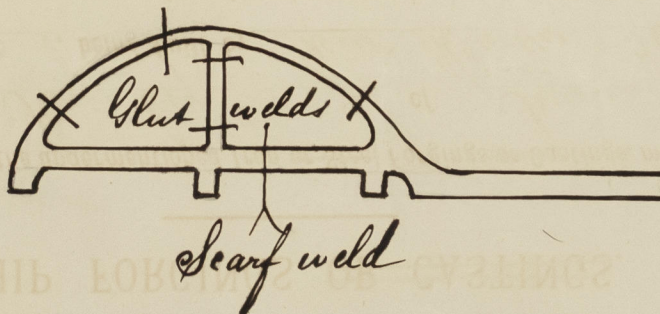

© 2021

Lloyd's Register
Foundation

00 28 60

