

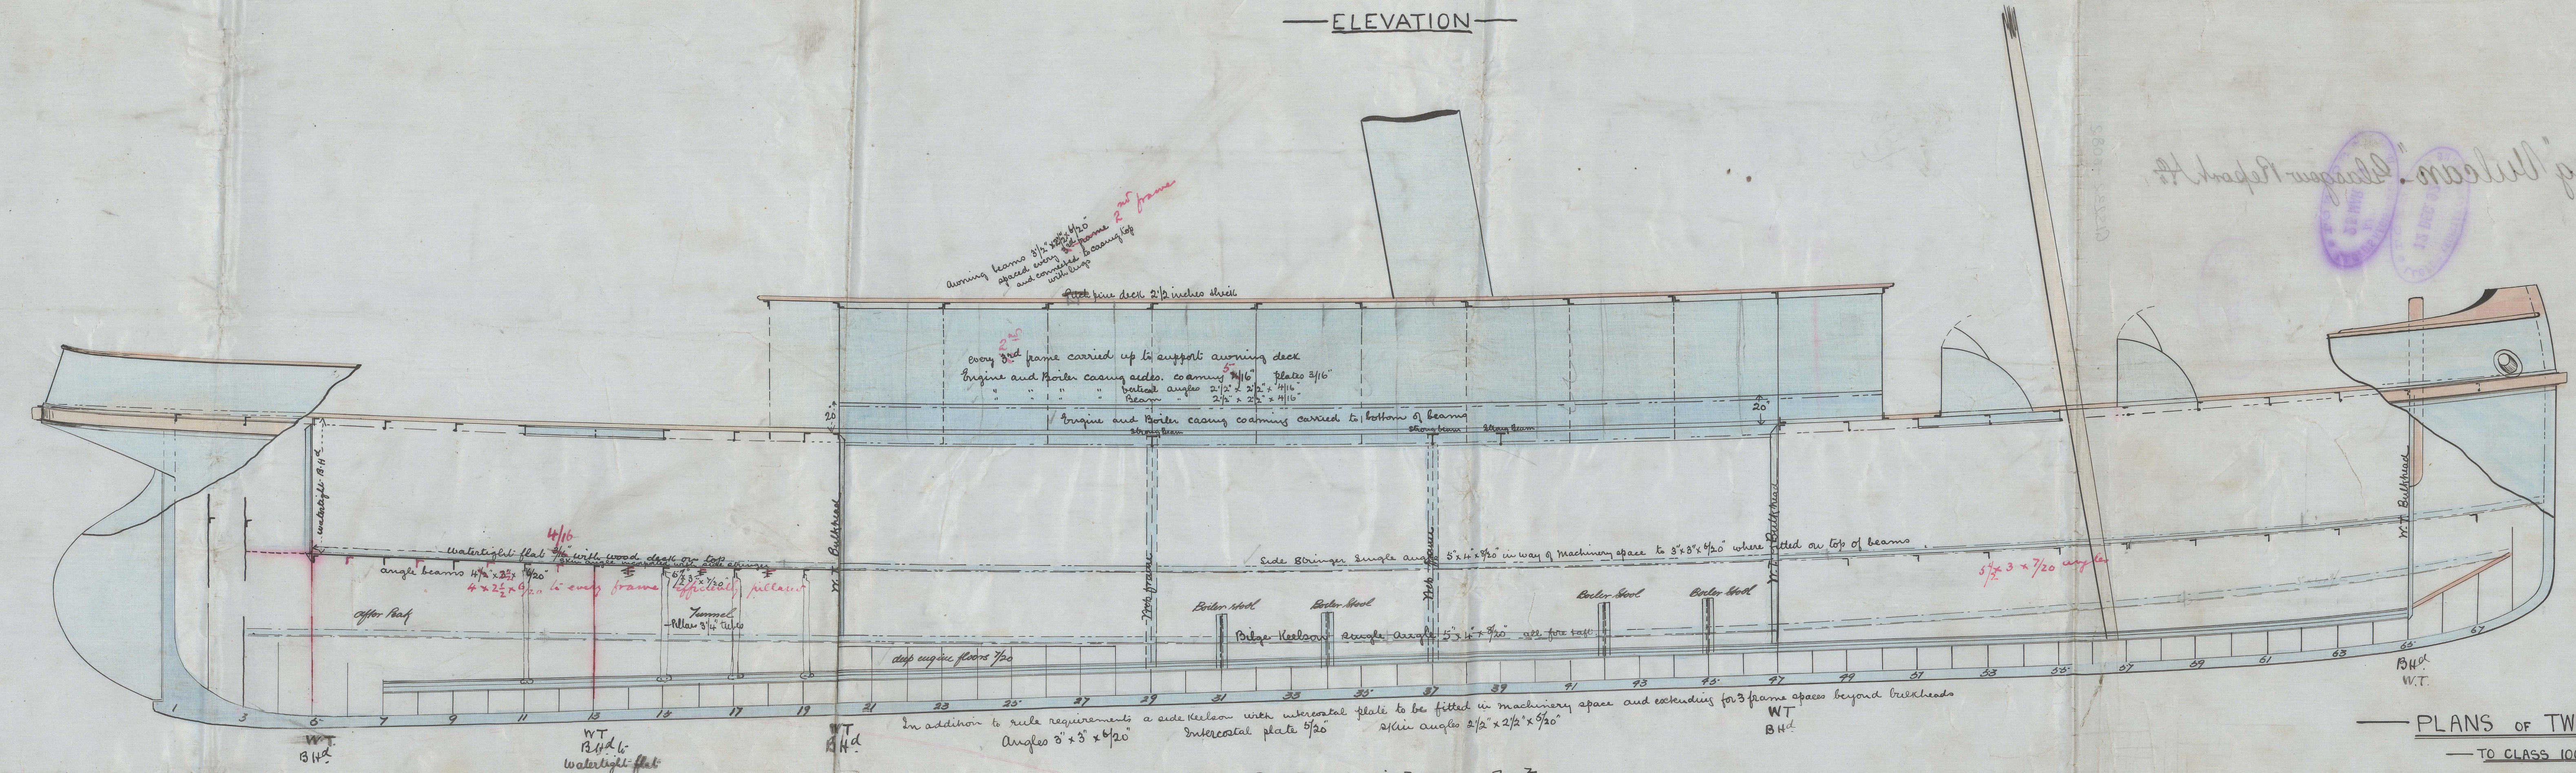


21. 10. 92

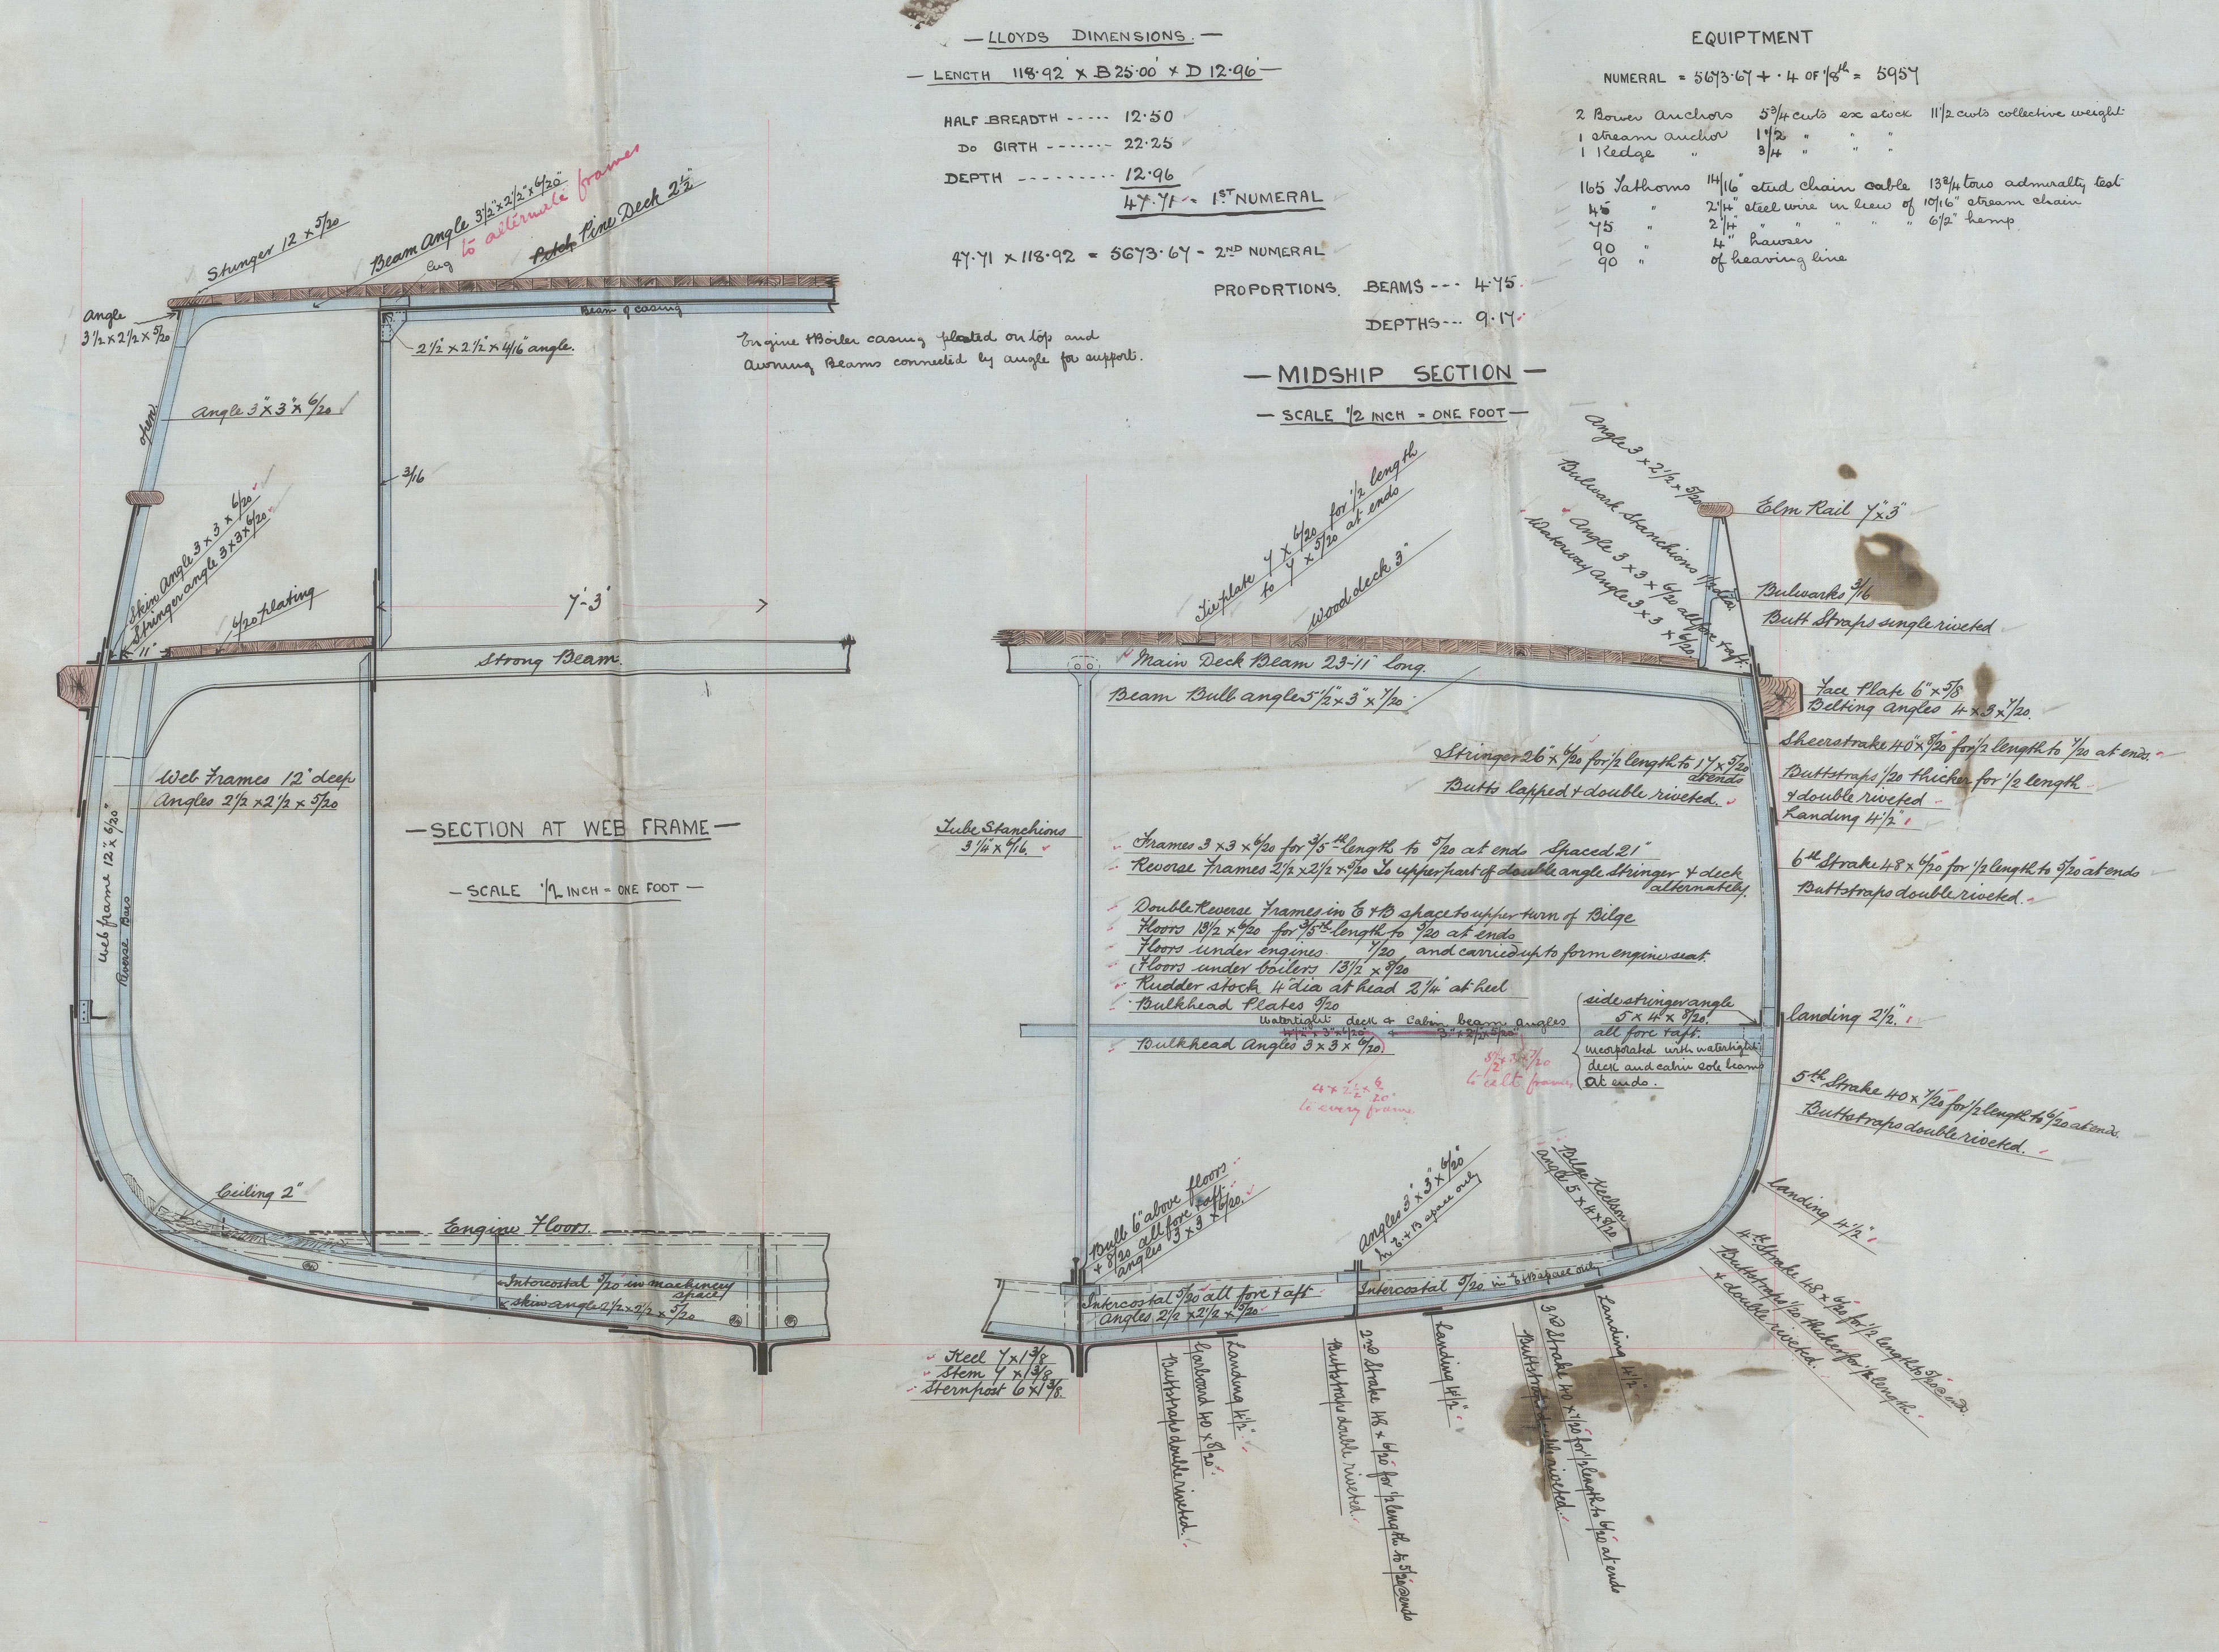

— PLANS OF TWIN SCREW STEAMER —
— TO CLASS 100 A.1 AT LLOYDS —


—Nº 383—

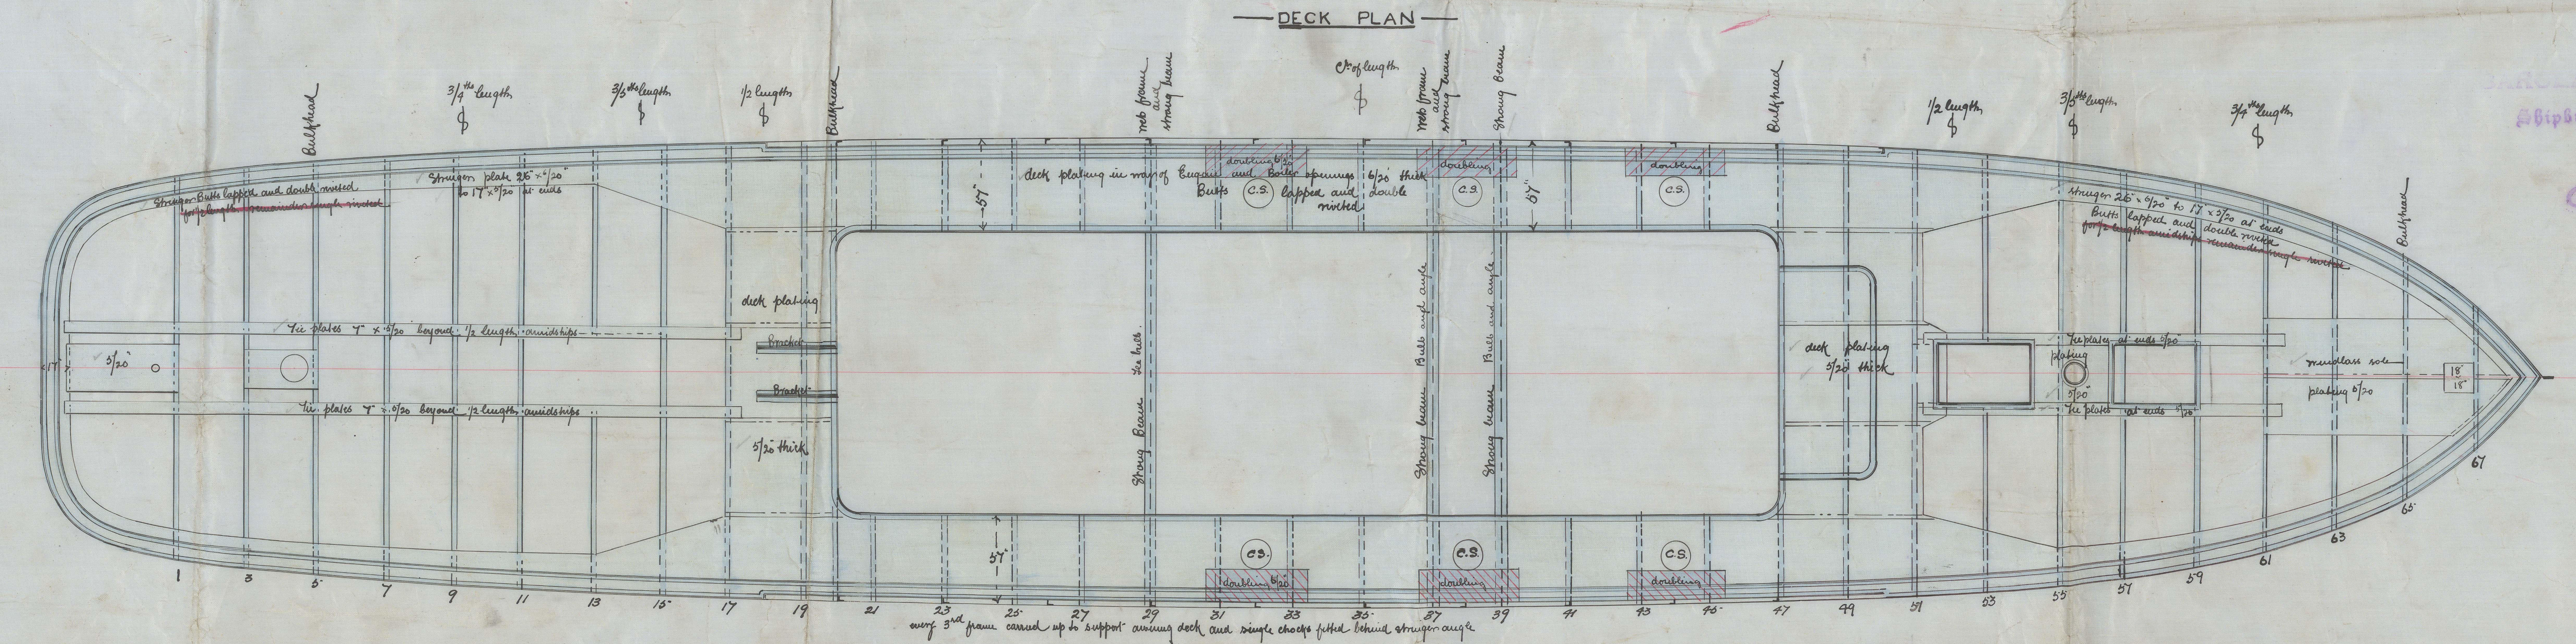

J. Feb. 19. 10. 92

S. Tug "Vulcan" - Glasgow Report A¹¹

GLS232-0082

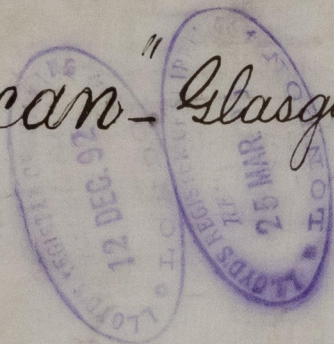

PLANS OF TWIN SCREW

— TO CLASS LOCAL AT LLOYD

— V. 383



© 2021

Lloyd's Register
Foundation