



Chr. 21: 12: 92.

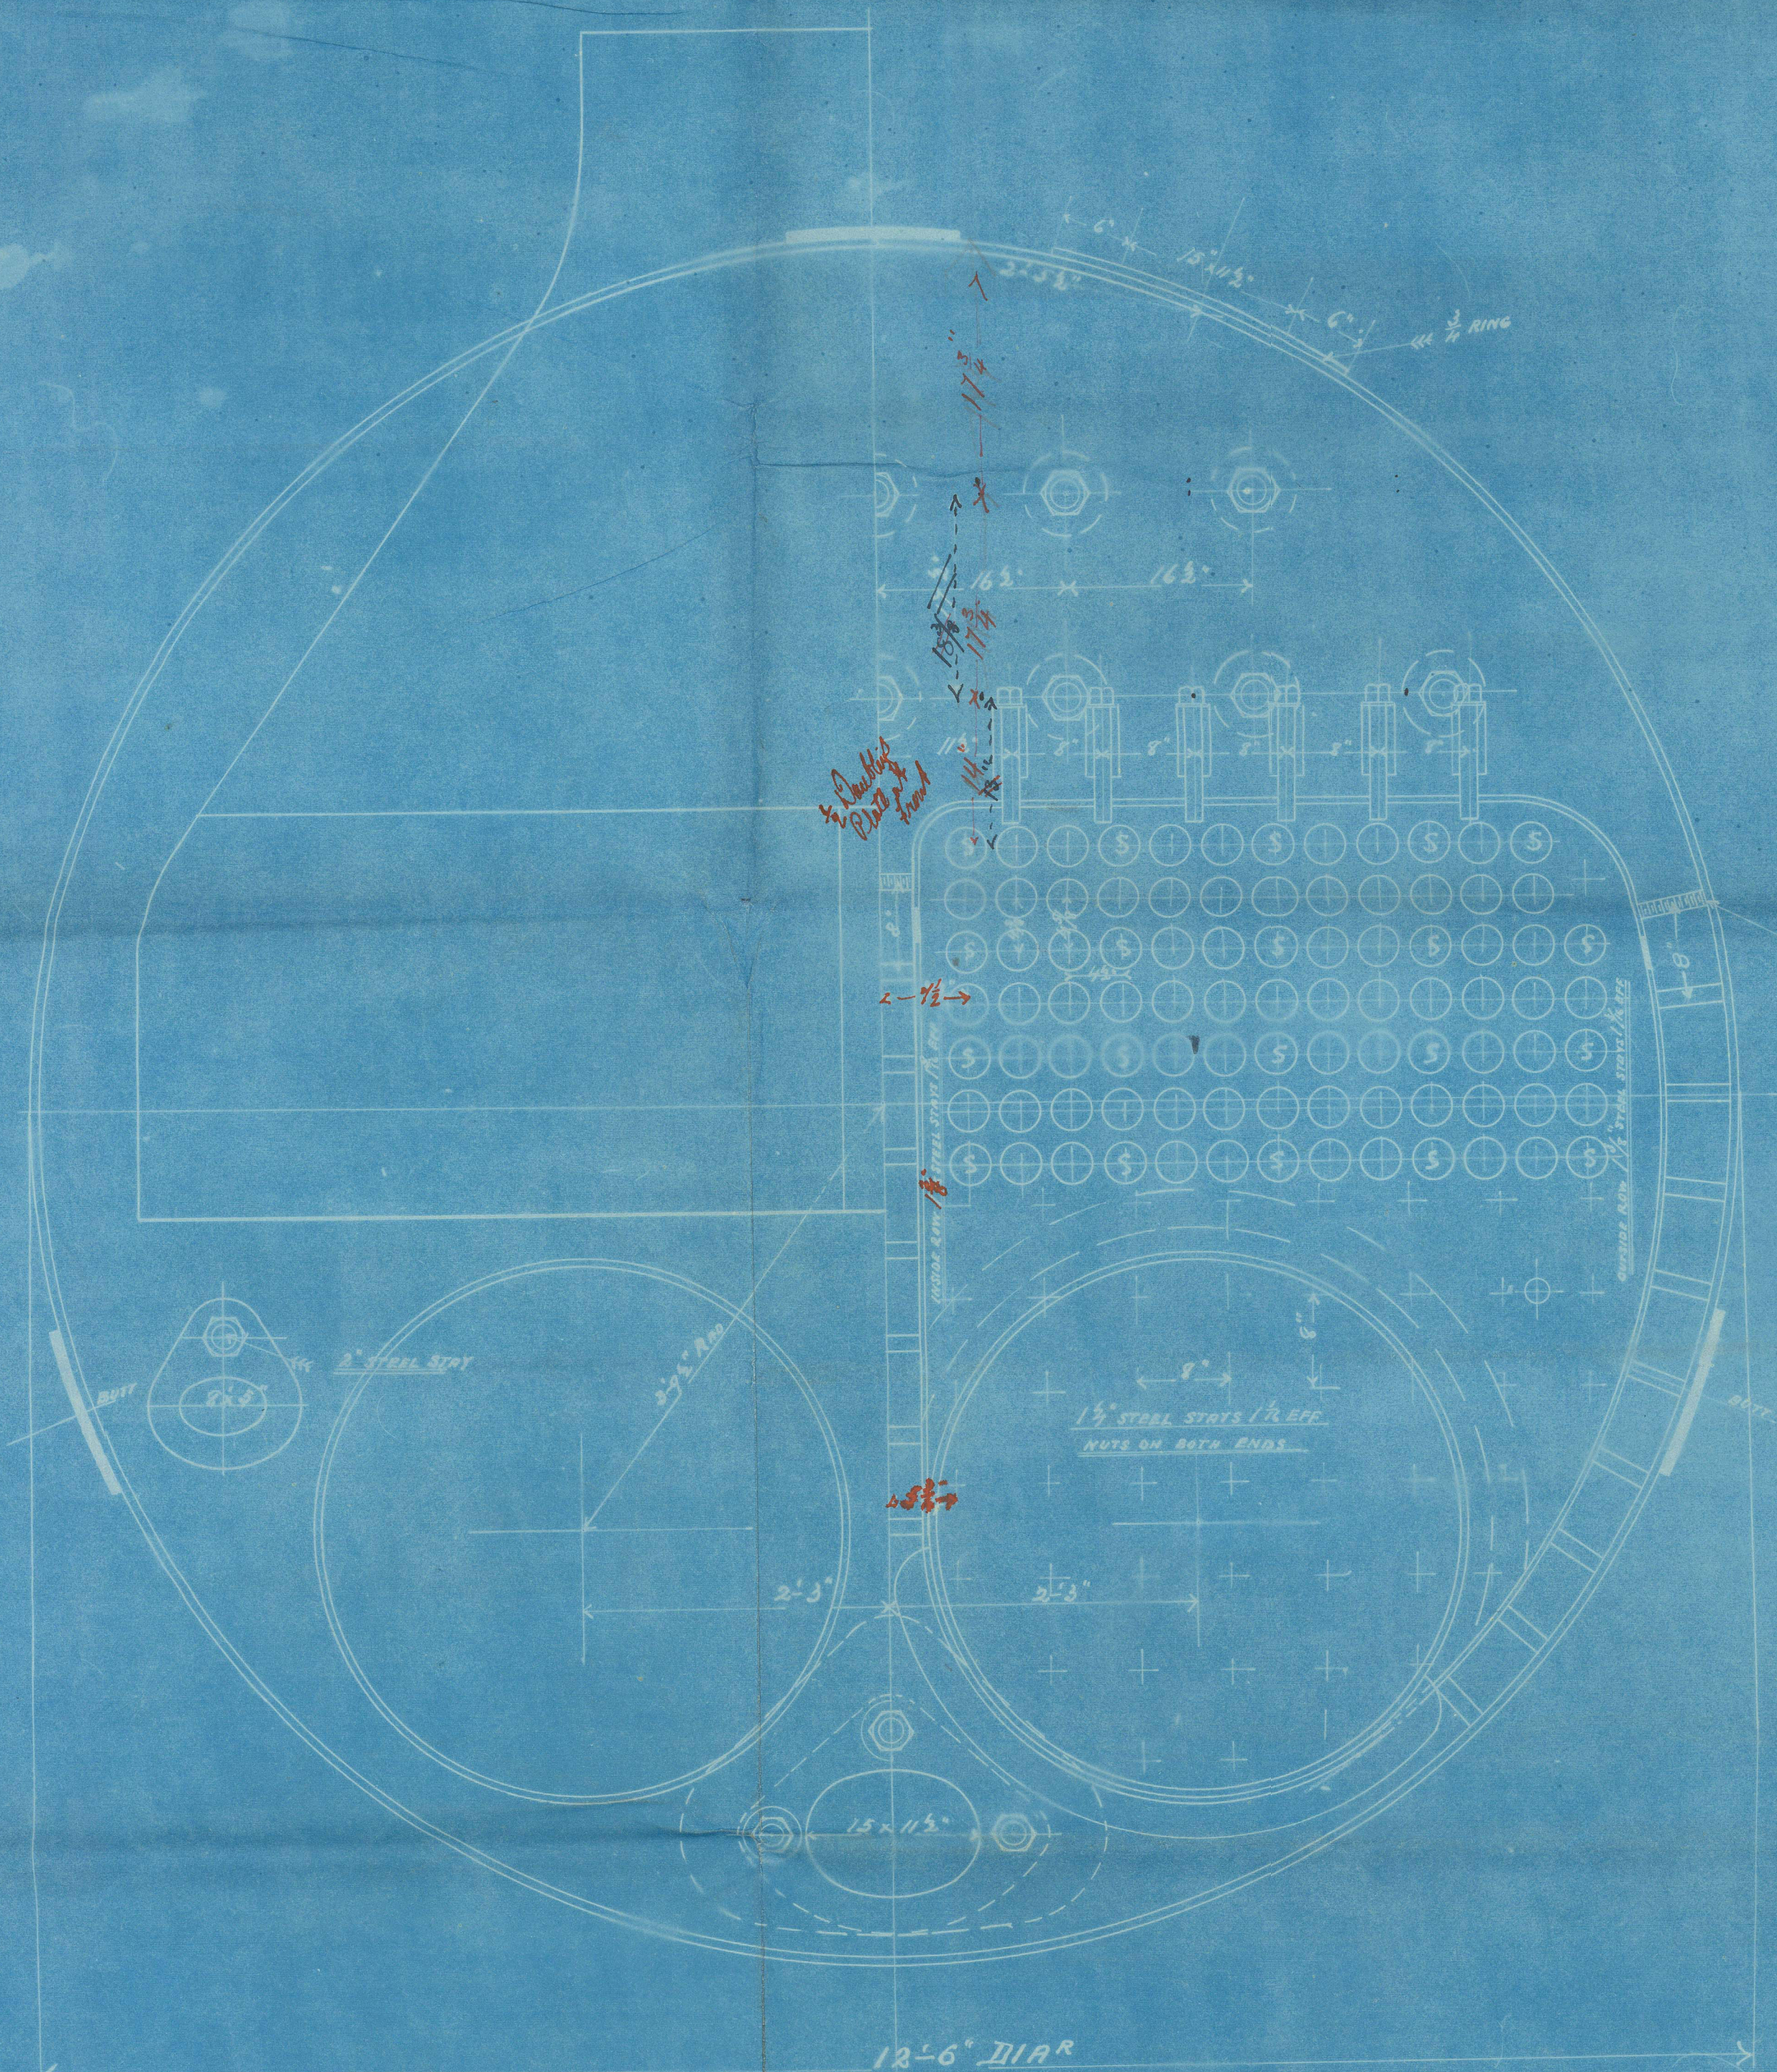


CIRC SEAMS DOUBLE RIVETED
1 1/2" DRILLED HOLES 3" PITCH 2 1/2" DIA.

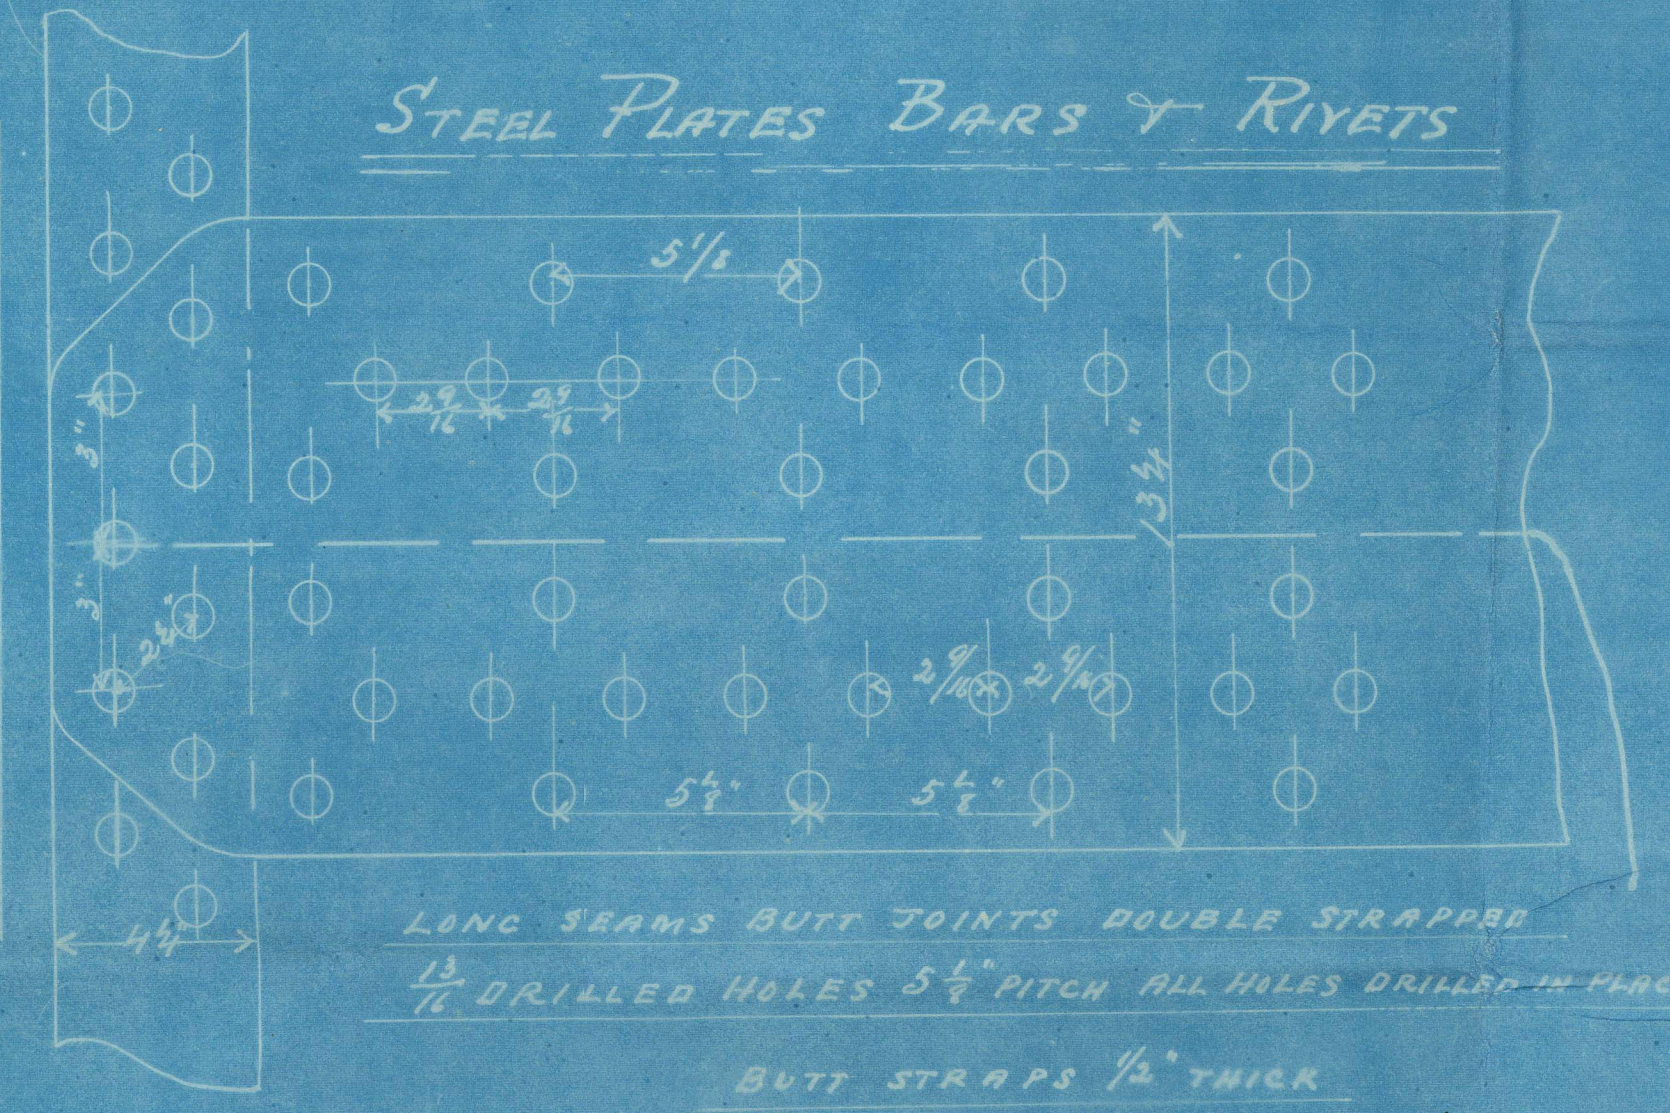

LONG SEAMS BUTT JOINTS DOUBLE STRAPPED

BUTT STRAPS 1/2" THICK
Internal Butt Strap 9/16" thick

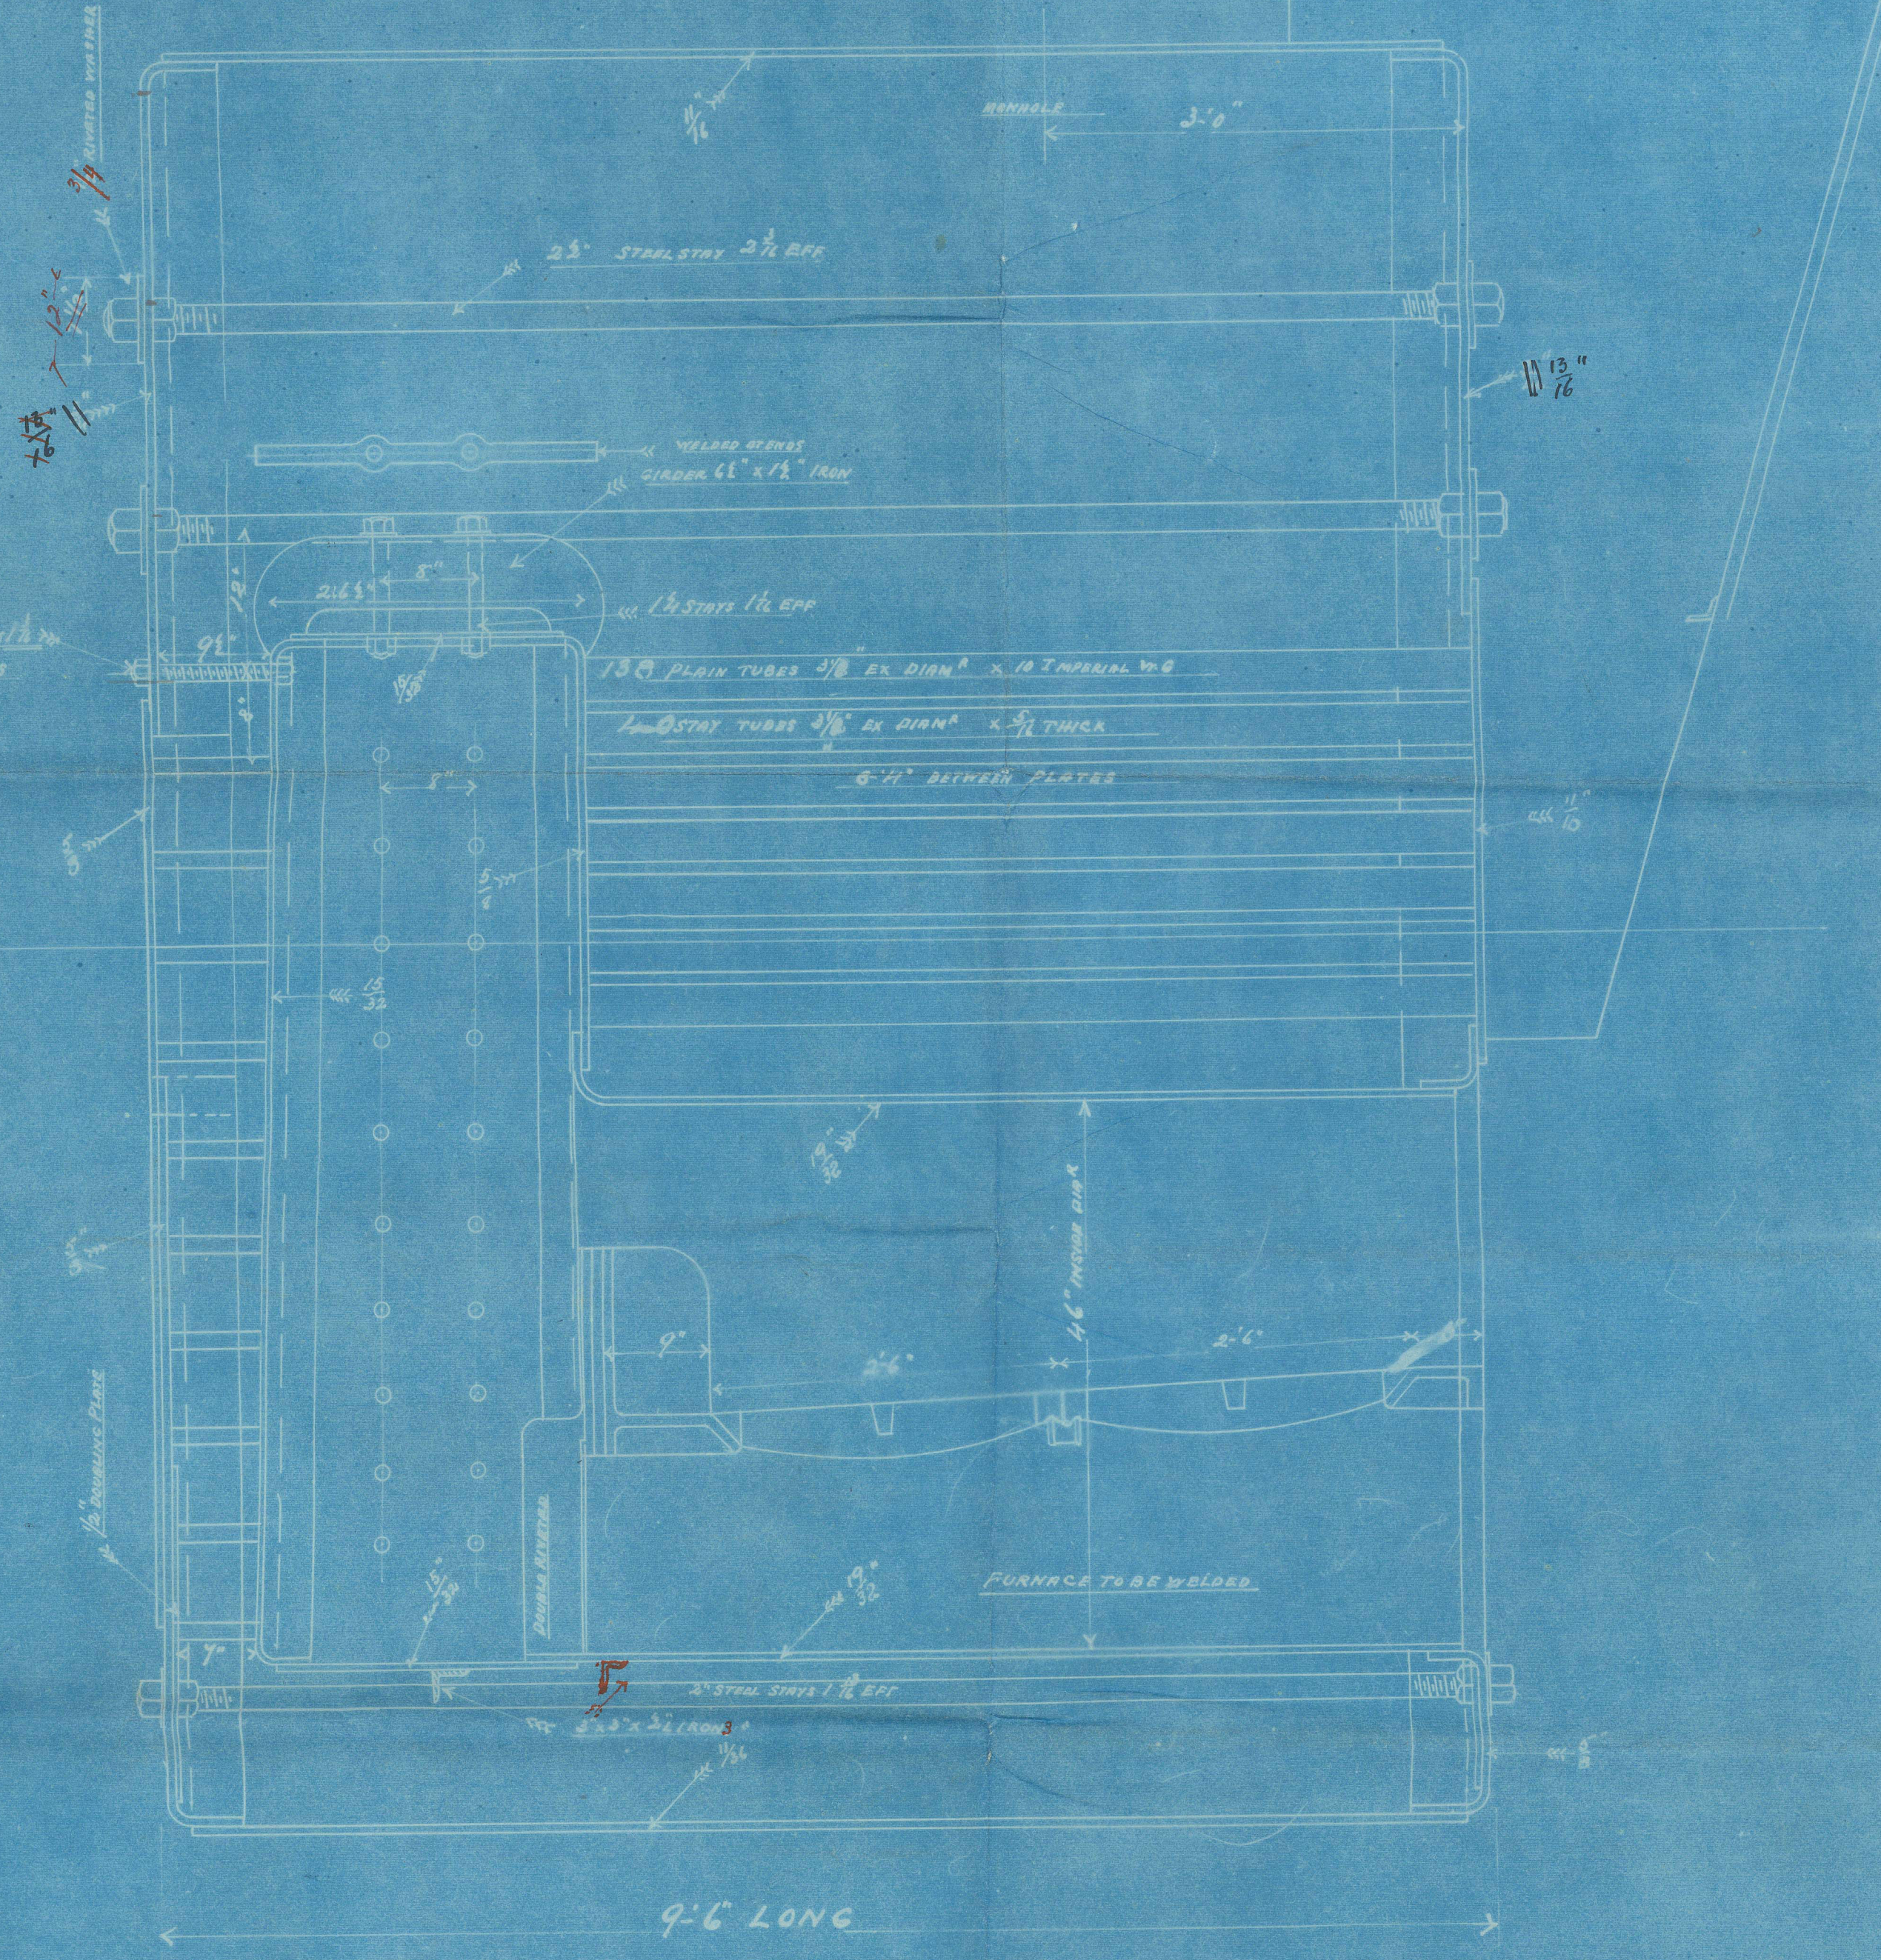

BOILER No 565
WORKING PRESSURE 100 LBS PER D.
SCALE INCH = ONE FOOT

TO PASS LLOYDS

7/12/92
1/10

RMB
14/12/92


Capt.
12/12/92

Rae & Duncan 575
Piers 100 lbs

Lullington SS. 113.-114

"Cumberland"
Glasgow Report
No 12204.

"Yorkshire"
Glasgow Report
No 12558

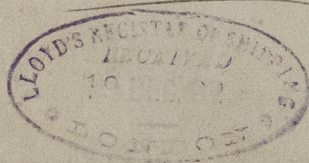

© 2021

Lloyd's Register
GLS 233-0176
Foundation