

Lloyd's Register of British and Foreign Shipping.

(Report on Vessel No. 12219 Port Glasgow)

"Carrier"

No. 3385 SHIP FORGINGS ~~OR CASTINGS~~

The words FORGINGS or CASTINGS, IRON or STEEL, should be struck out as may be required.

I have to report that the undermentioned Iron or Steel Forgings or Castings, manufactured by

The Irvine Forge Co of Irvine

for the Vessel No. 90, being built by Messrs Scott & Co

of Bowling have been inspected by me as set forth below, and found

to be, so far as can be seen, Sound & efficient

Mark on Forgings.


Lloyd's
No. 3385
W.H.

William Hamilton

Glasgow
3/3/92

	STERN FRAME.	RUDDER FRAME.	STEM.
Material*	/	Scrap iron Forged	/
How made	/	3 1/4 x 6 1/4	/
Dimensions	/	Forging & smithing	/
Progress on Inspection	/	28/30/12/91. 19. 27/2/92. 8/2/92	/
Dates when Inspected	/	1/3/92	/

SKETCHES OF FRAMES SHEWING POSITION AND DESCRIPTION OF WELDS OF FORGINGS, OR PARTICULARS OF TESTS APPLIED TO CASTINGS.

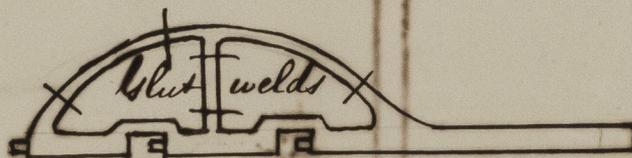

* If of Iron, state whether scrap or puddled Iron.

