


STEEL BOILER

SCALE 1" = ONE FOOT

W.P. 100 LBS (LLOYDS & B.O.T.)

FOR C. HAMMOND ESQ. SWANSEA.

ORDER NO 693

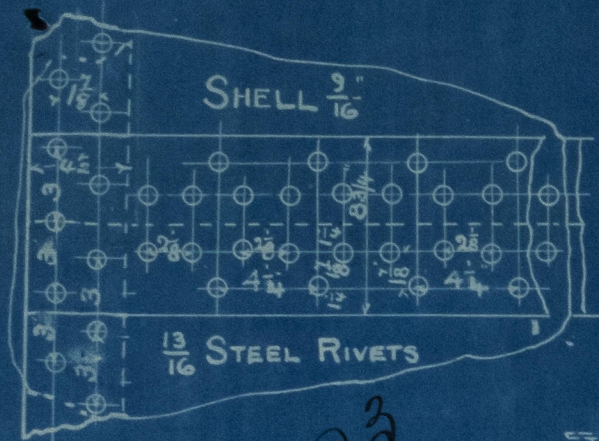


$\frac{7}{16}$ DOUBLE STRAPS.

$\frac{13}{16}$ STEEL RIVETS

Chr. 1.9.93

*Hot Steam Trug
Search light*

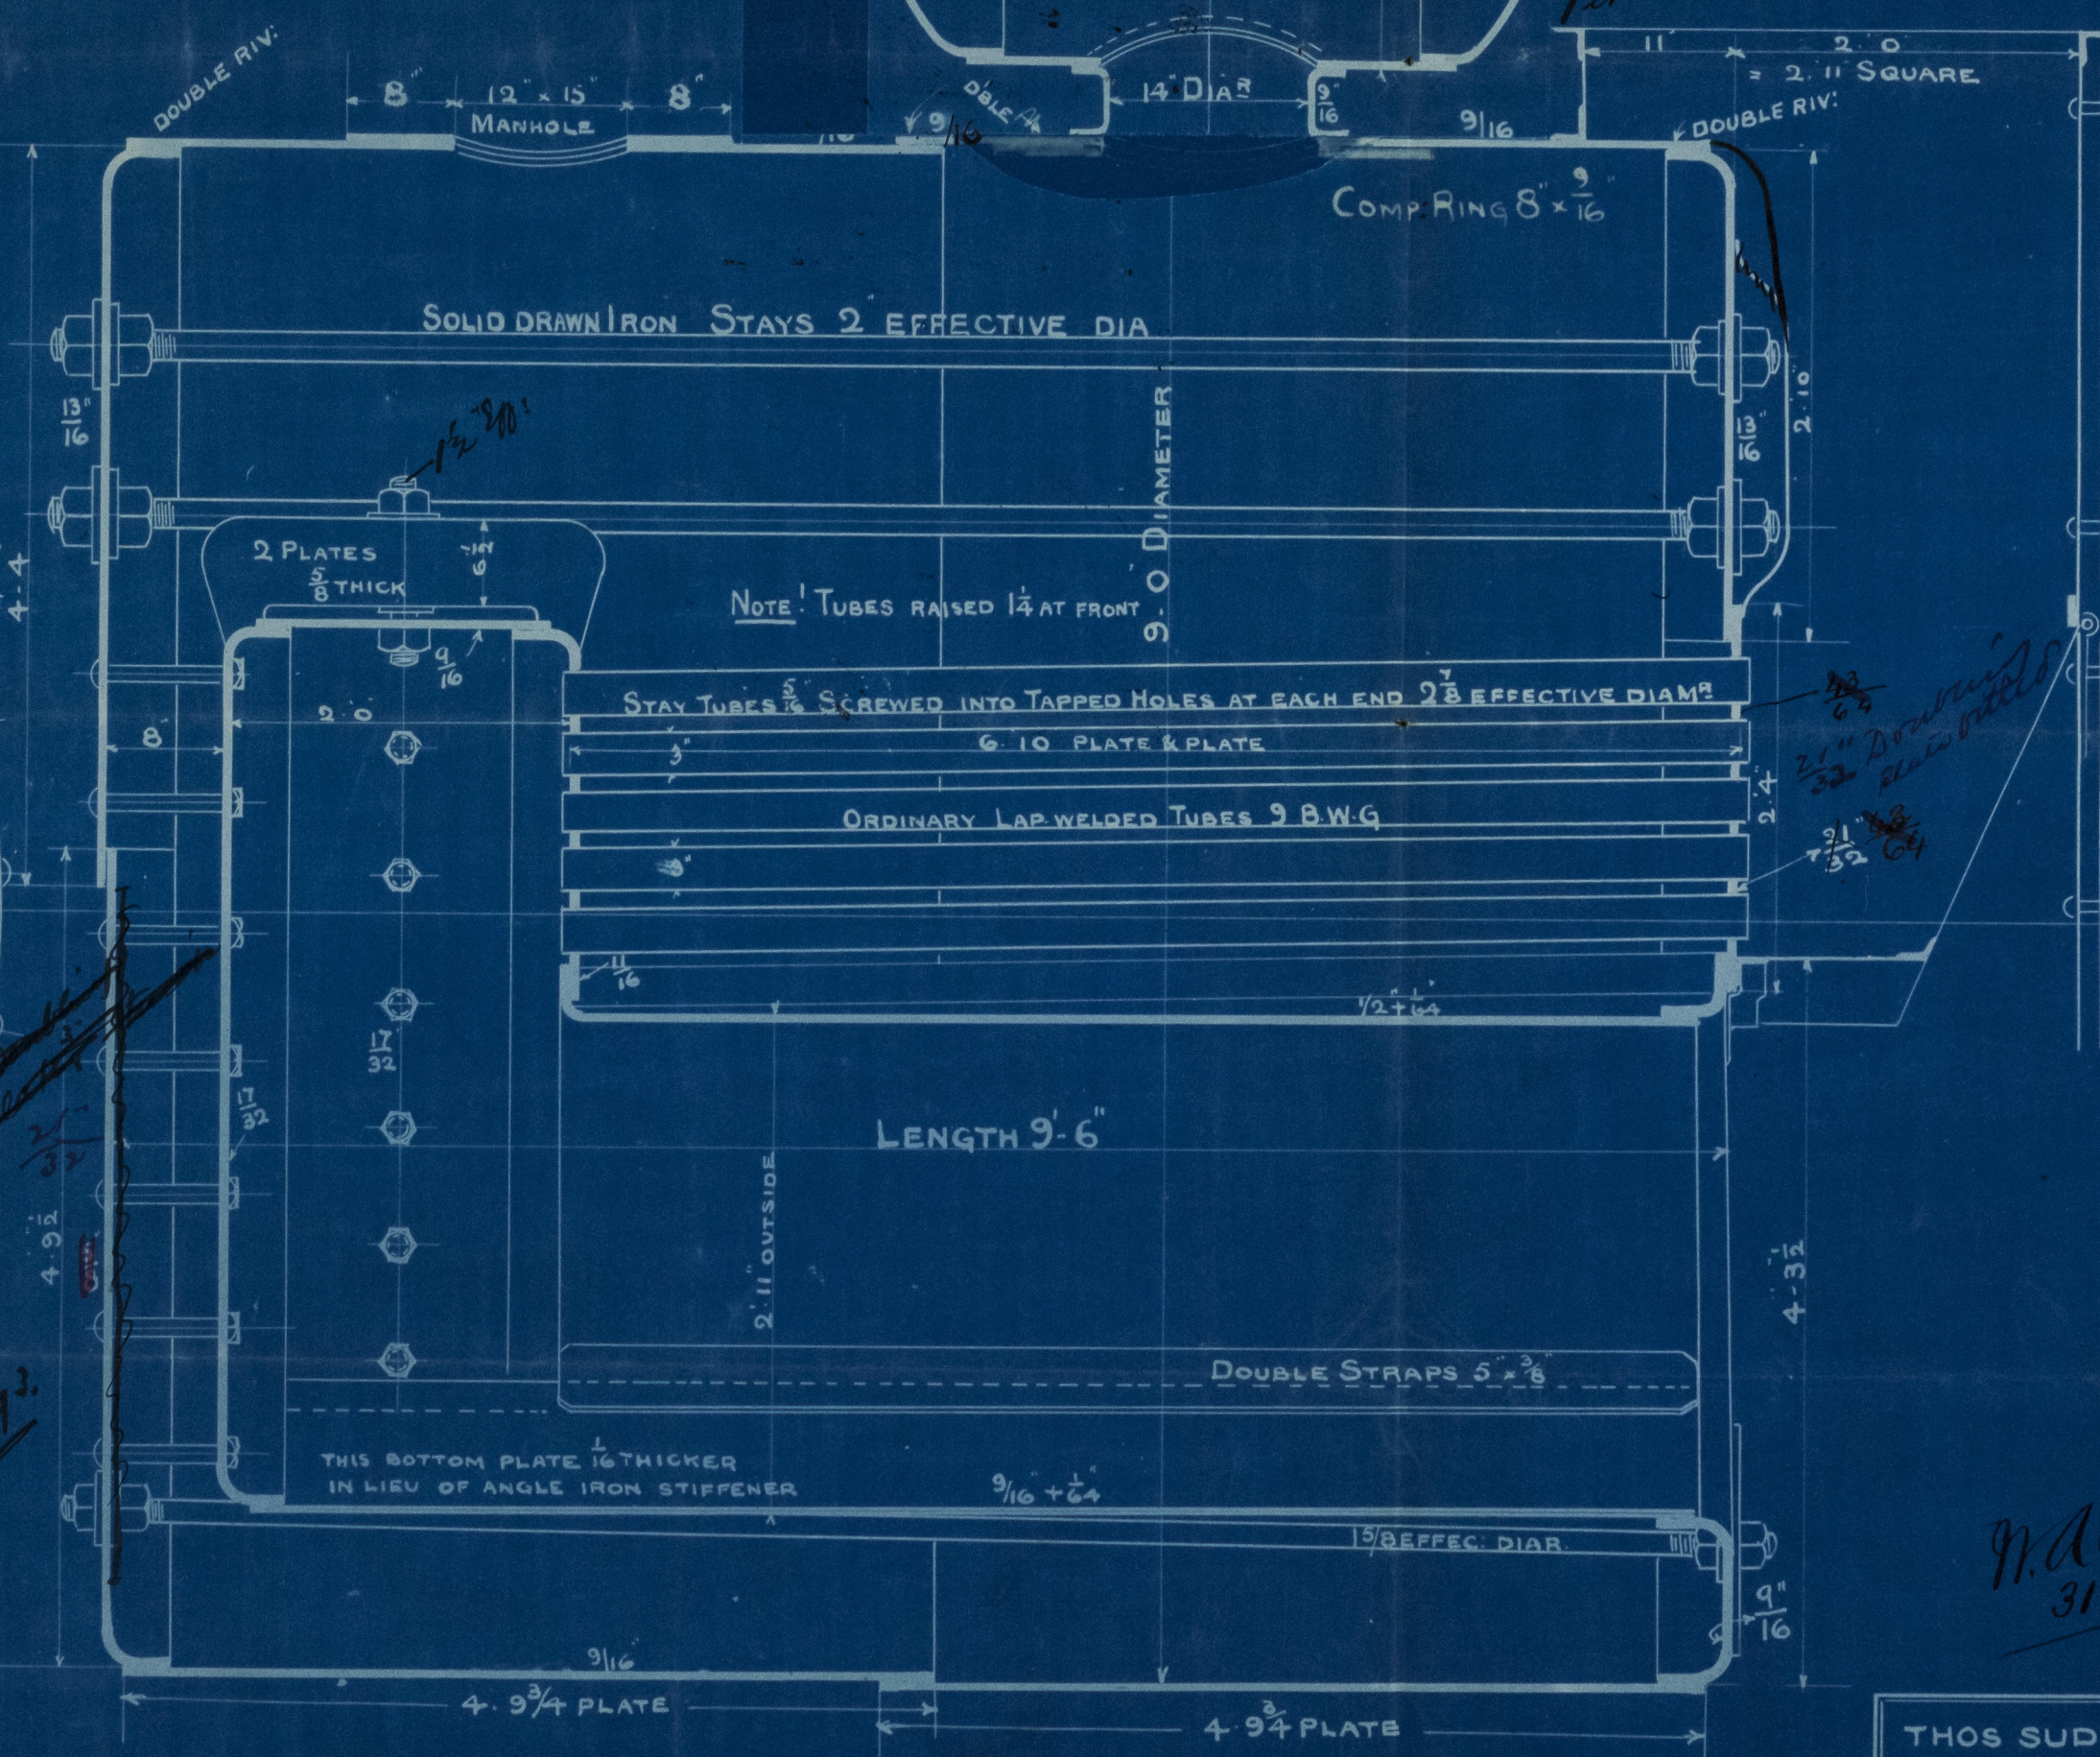

*Lap joint boiler riv?
13/16 Rivets 2 1/2" pitch = 70 1/2"*

*Simple machine
Lap joint.
Rivet 1 1/2" dia
Pitch of rivets 2 1/2"*

*2 1/2" Down riv?
plate outside*

*13/16"
Holes
filled on
inside stay
as boiler
leak*

*N.A.
31.8.93*

*LLOYD'S REGISTER OF
ROYAL EXCHANGE
MARSHALL STREET
SHIPPING
W.R.H.
30th August 1893*

THOS SUDRON & CO LTD
IMPERIAL BOILER WORKS
STOCKTON-ON-TEES



© 2021
Lloyd's Register
Foundation

Steel Bolts
for
Main Top
Search Light.

Ink 10774

Clk 12249.
31 AUG. 93
LONDON

665234-0054



© 2021

Lloyd's Register
Foundation