

## Lloyd's Register of British and Foreign Shipping.

(Report on Vessel No. 12346 Port Glasgow  
"Osprey".)No. 195

## SHIP FORGINGS OR CASTINGS.

The words FORGINGS or CASTINGS, IRON or STEEL, should be struck out as may be required.

I have to report that the undermentioned Iron or Steel Forgings or Castings, manufactured by James Carmichael & Co of Dundee for the Vessel No. 67, being built by Mackie & Thompson of Glasgow have been inspected by me as set forth below, and found to be, so far as can be seen, sound.


Mark on Forgings.

Lloyd's

No. 279HC 5/93Harry ClarkeDundee

	STERN FRAME.	RUDDER FRAME.	STEM.
Material* . . . .	/	<u>Scrap Iron</u>	/
How made . . . .		<u>Forged</u>	
Dimensions . . . .		<u>3 1/2' head 2 1/4' pintles</u>	
Progress on Inspection .		<u>Finished</u>	
Dates when Inspected {		<u>April 24-25.</u> <u>May 2. 1893. Jan 3/93</u>	

SKETCHES OF FRAMES SHEWING POSITION AND DESCRIPTION OF WELDS OF FORGINGS, OR PARTICULARS OF TESTS APPLIED TO CASTINGS.

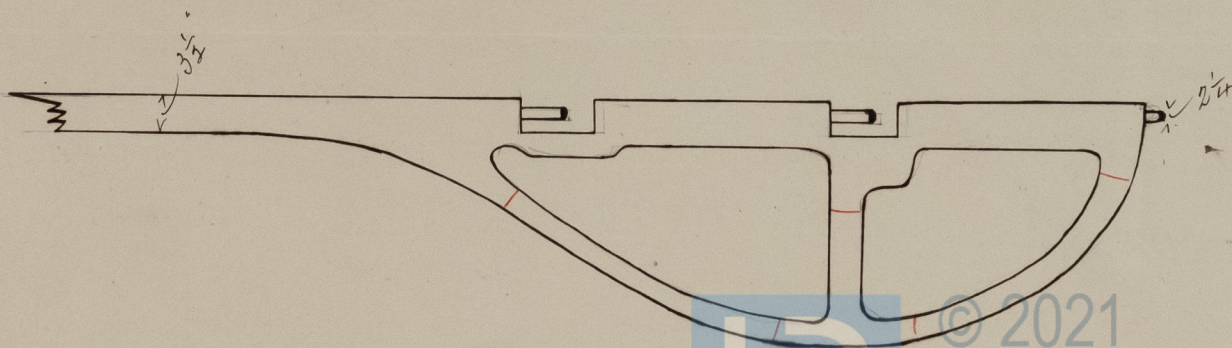



© 2021

Lloyd's Register  
Foundation