

MIDSHIP SECTION

STEEL SCREW TRAWLER

TEAL

No 69

As built

J. Thomson

13.7.93

TO CLASS 100 A. STEAM TRAWLER

DIMENSIONS

HALF MOULDED BREADTH 10.2
DEPTH FROM TOP OF KEEL 12.0
HALF MIDSHIP GIRTH 17.80
LEN. AS PER RULE 47.25

NUMERALS

$10.2 + 12.0 + 17.80 = 40.0$ THWAIRSHIPS
 $10.2 + 12.0 + 17.80 \times 97.25 = 3890.0$ LONG

PROPORTIONS

$97.25 \div 12.0 = 8.10$
 $97.25 \div 20.4 = 4.767$

EQUIPMENT FOR 120 TO 140 TONS

1 ANCHOR 4 1/2 CWTs. EX STOCK
1 D² 4 D² D²
1 D² 2 1/2 D² D²
60 FMS. 1 1/2 SL CHAIN
60 FMS. 3 1/2 HAWSER
60 FMS. 3 1/2 WARP

NOTE

BULKHEAD PLATING
KEEL + STEM
BULWARK
RUDDER
BULWARK STANCHIONS
HOLD PILLARS
RIVER SLIPS


IRON
REMAINDER
OF
STEEL



SCALE 1/2" = 1 FOOT.

Copy

S. S. "Teal" Glasgow Report No.

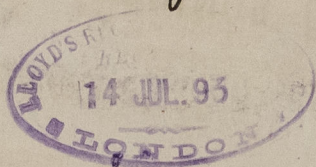

GLS235-0018



© 2021

Lloyd's Register
Foundation