


MARINE BOILER. N<sup>os</sup> 232-3-4-5-6-7



SCALE 1 INCH = 150 FT.

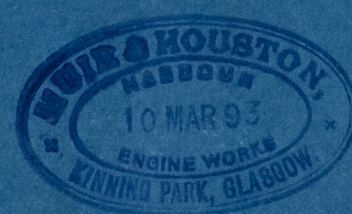

## DIMENSIONS

Diameter of Boiler (INSIDE) 9'-0"  
Length of Boiler 8'-9"  
Diameter of Furnaces 2'-9"  
Number of Plain Tubes 52  
Number of Stay Tubes 30  
Total Number of Tubes 82  
Total Heating Surface  
Total Fire grate Area  
Working Pressure 160 LBS



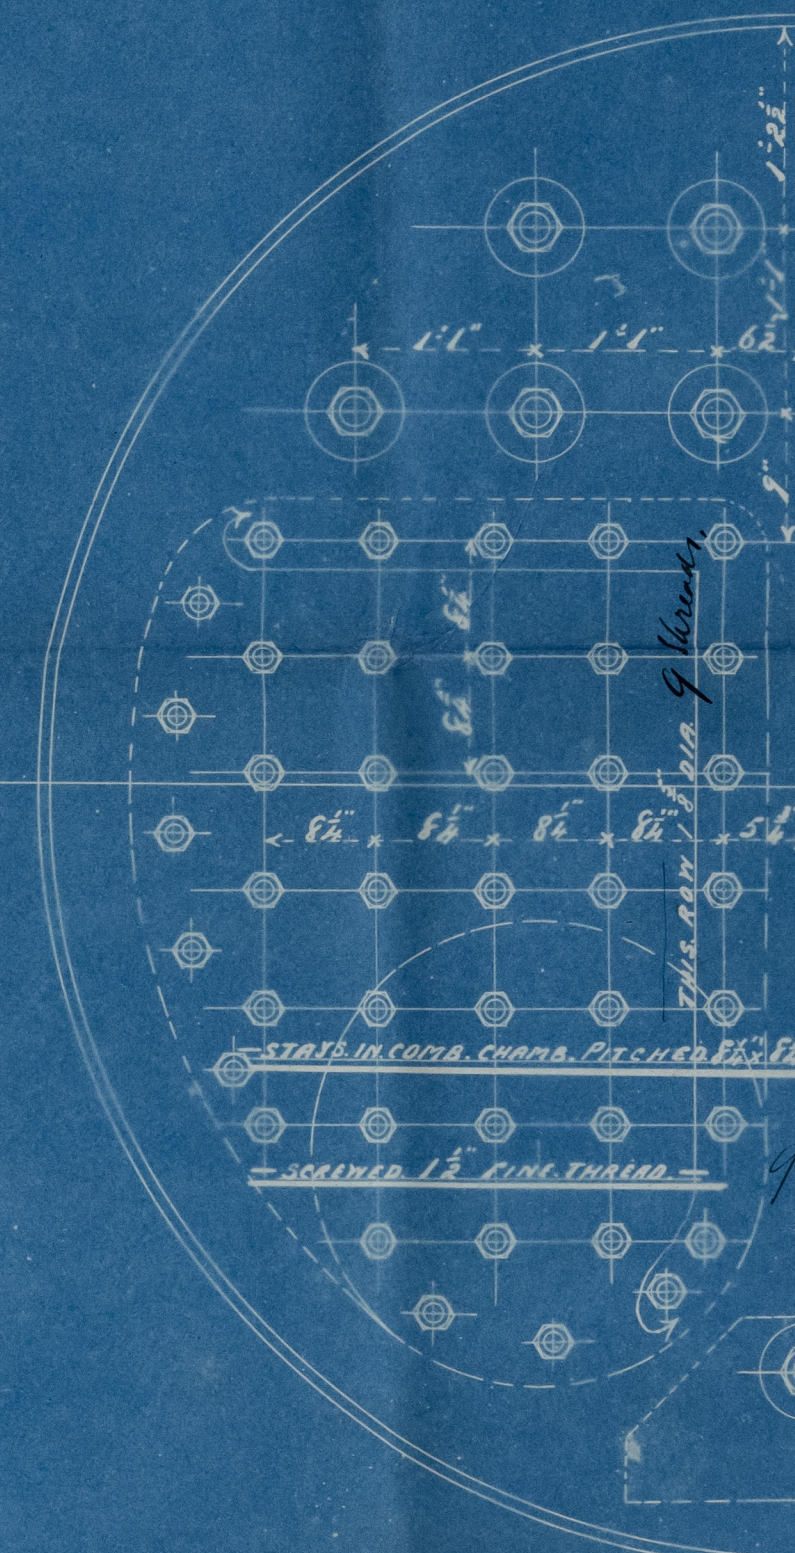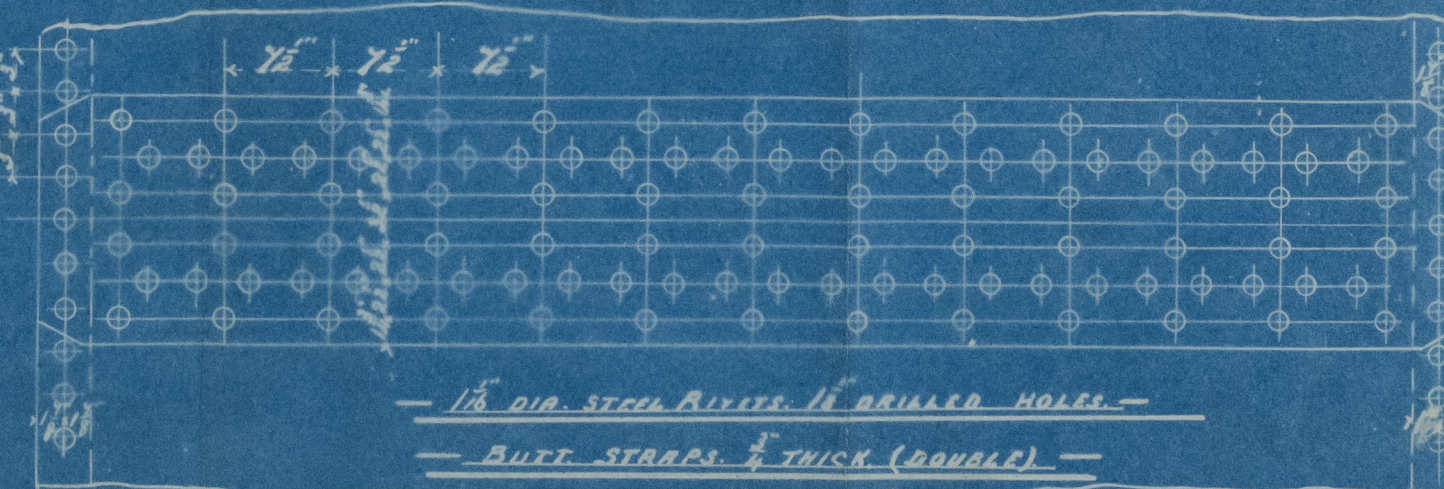

13. 3 93  
JUL 15/3/93-



Marin Bailes  
Wm & Houston  
232 — 237

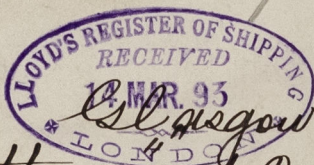

"Glasgow Reports  
"Bittern" No. 12308  
"Lynnet" " 12321  
"Halcyon" " 12322  
"Osprey" " 12346  
"Stork" " 12344  
"Seal" " 12348-



© 2021

Lloyd's Register  
Foundation

GLS235-0019