

Lloyd's Register of British and Foreign Shipping.

(Report on Vessel No. 12348, Port Glasgow  
Seab.)

No. 194 SHIP FORGINGS OR CASTINGS.

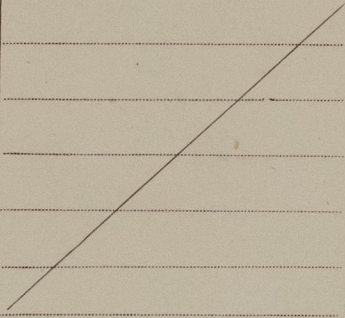
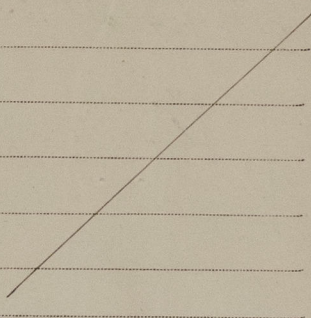
The words FORGINGS or CASTINGS, IRON or STEEL, should be struck out as may be required.

I have to report that the undermentioned Iron or Steel Forgings or Castings, manufactured by James Cornichael & Co. of Dundee for the Vessel No. 69, being built by Mackie & Thomson of Glasgow have been inspected by me as set forth below, and found to be, so far as can be seen, sound.

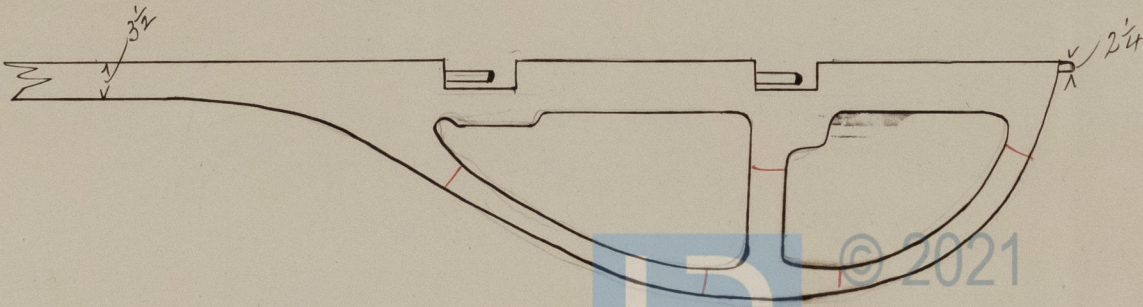
Mark on Forgings.

Lloyd's  
No. 286  
HC 6/93

Harry Clarke  
Dundee

	STERN FRAME.	RUDDER FRAME.	STEM.
Material* . . . .		<u>Scrap Iron</u>	
How made . . . .		<u>Forged</u>	
Dimensions . . . .		<u>3 1/2 head 2 1/4 pintles</u>	
Progress on Inspection .		<u>Finished</u>	
Dates when Inspected {		<u>May 25.</u> <u>June 3 - 1893</u>	

SKETCHES OF FRAMES SHEWING POSITION AND DESCRIPTION OF WELDS OF FORGINGS, OR PARTICULARS OF TESTS APPLIED TO CASTINGS.





(69)  
udder

© 2021

Lloyd's Register  
Foundation