

Lloyd's Register of British and Foreign Shipping.

(Report on Vessel No. 12348 Port Glasgow)
"Seal"No. 188

SHIP FORGINGS OR CASTINGS.

The words FORGINGS or CASTINGS, IRON or STEEL, should be struck out as may be required.

I have to report that the undermentioned Iron or Steel Forgings or Castings, manufactuerd by James Carmichael & Co. of Dundee for the Vessel No. 69, being built by Mackie & Thomson of Glasgow have been inspected by me as set forth below, and found to be, so far as can be seen, Sound.


Mark on Forgings.

Lloyd's
No. 241
H.C. 5/93

Harry Clarke
Dundee


	STERN FRAME.	RUDDER FRAME.	STEM.
Material* - - -	<u>Scrap Iron</u>		
How made - - -	<u>Forged</u>		
Dimensions - - -	<u>6½" x 2½"</u>		
Progress on Inspection -	<u>Finished</u>		
Dates when Inspected	<u>April 12. 19. 24.</u> <u>May 2-1893</u>		

SKETCHES OF FRAMES SHEWING POSITION AND DESCRIPTION OF WELDS OF FORGINGS, OR PARTICULARS OF TESTS APPLIED TO CASTINGS.

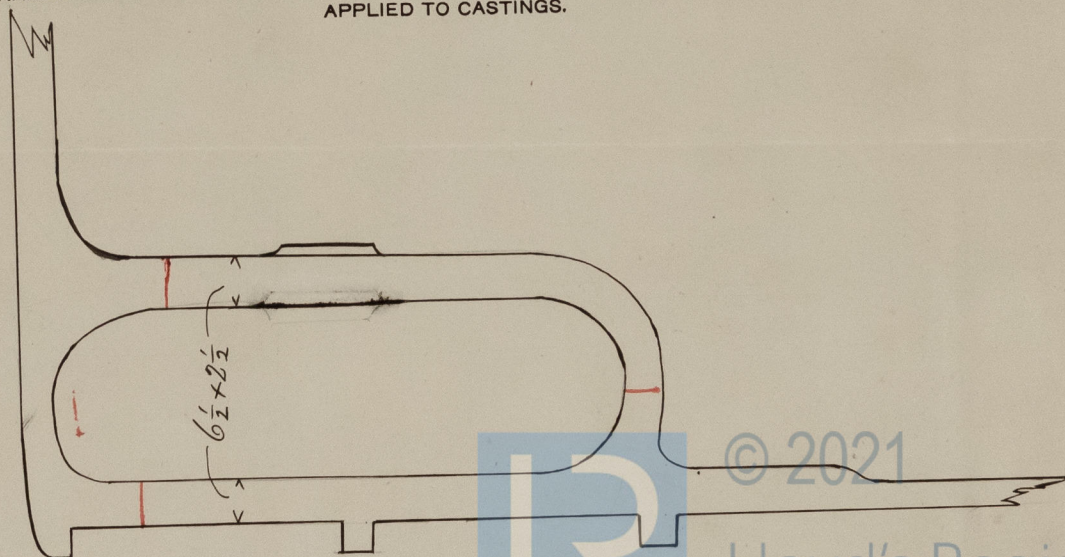

* If of Iron, state whether scrap or puddled Iron.

(69 stern frame)

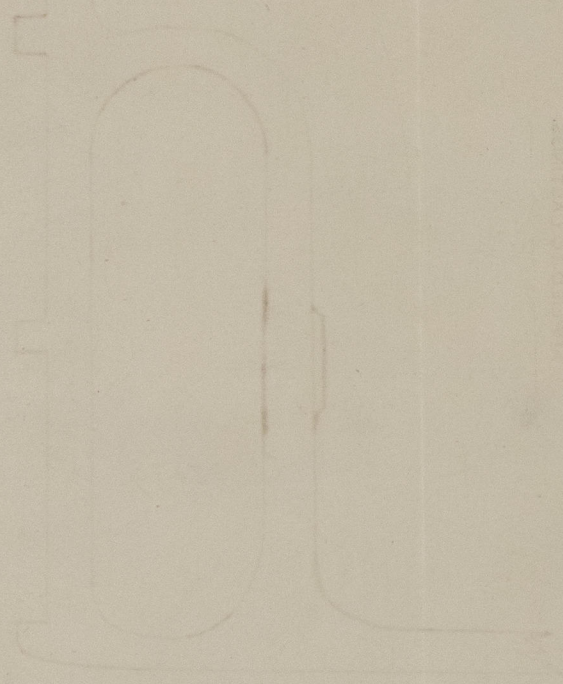

© 2021
Lloyd's Register
Foundation