



"S. S. Olive" Glasgow Report No. ~~187~~ 29.-
St. Catharine

LONGITUDINAL SECTION

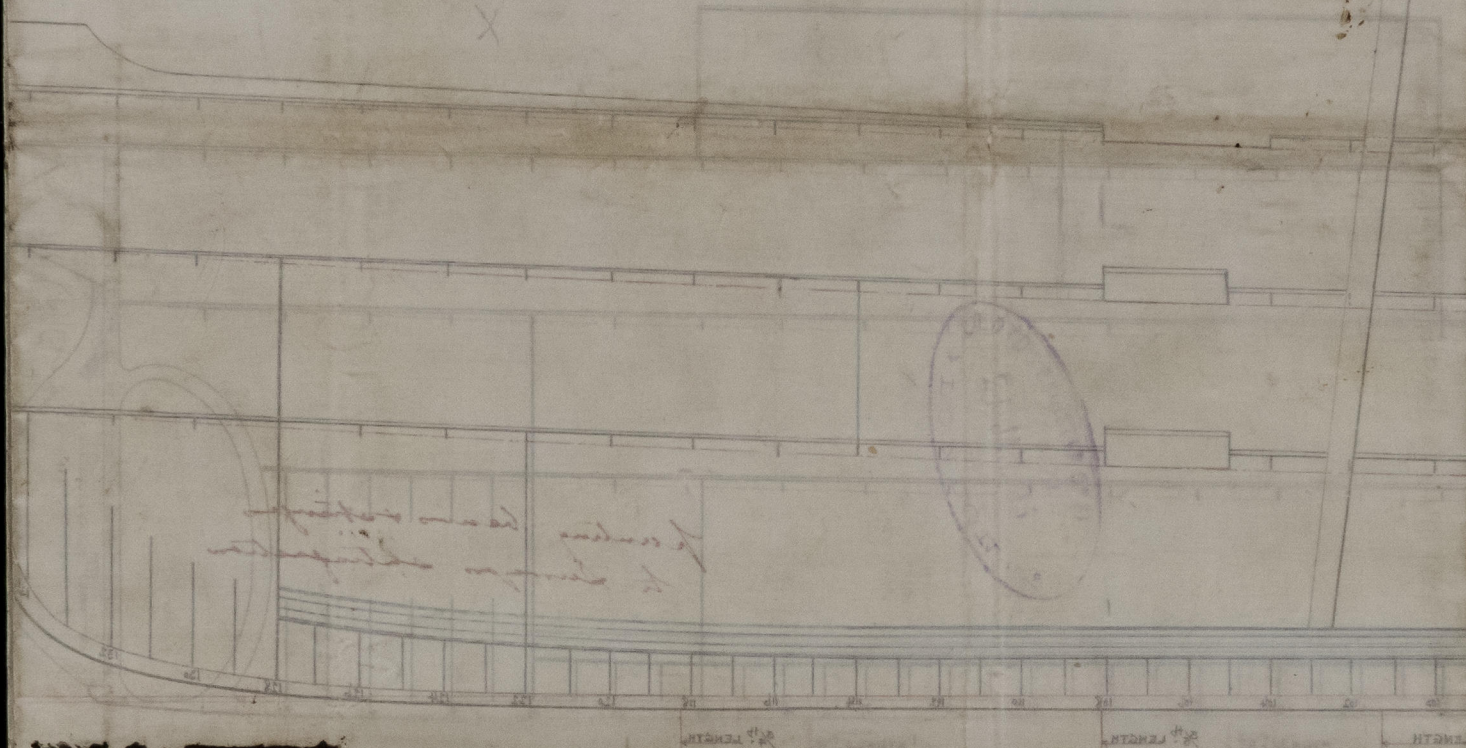

FORECASTLE

POOP DECK

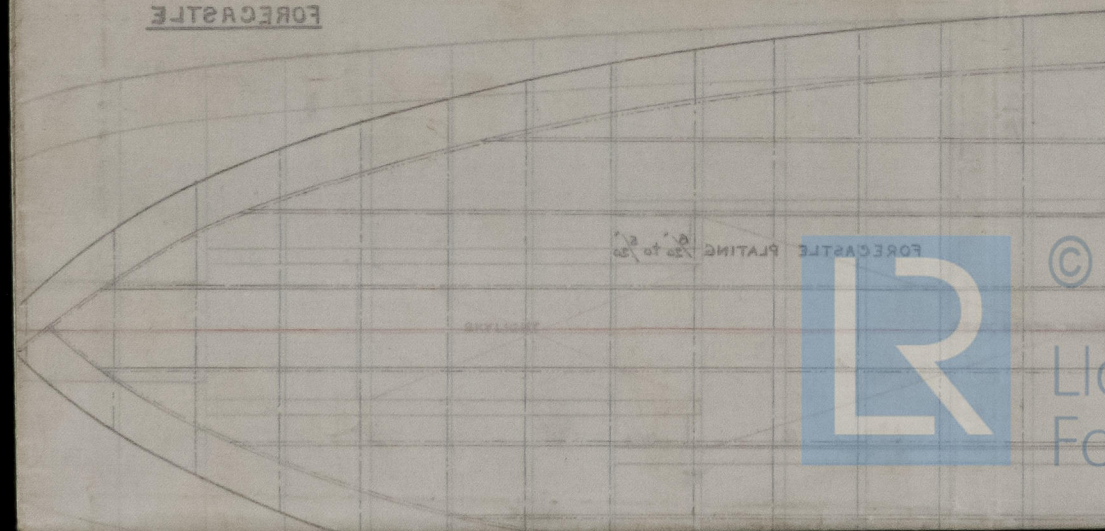

FORECASTLE PLATING



© 2021

Lloyd's Register
Foundation

465235-0085