

Lloyd's Register of British and Foreign Shipping.

(Report on Vessel No. 12429 ~~368~~ "Port Glasgow Oliver")

No. 4057 SHIP FORGINGS ~~OR CASTINGS~~

The words FORGINGS or CASTINGS, IRON or STEEL, should be struck out as may be required.

I have to report that the undermentioned Iron ~~or Steel~~ Forgings ~~or Castings~~, manufactuerd by Messrs D & W. Henderson & Coy of Glasgow for the Vessel No. 368, being built by Them of _____ have been inspected by me as set forth below, and found to be, so far as can be seen, Sound & efficient

Mark on Forgings.

Lloyd's
No. 4057
W. H.


William Hamilton

Glasgow

29/4/93

	STERN FRAME.	RUDDER FRAME.	STEM & Keel bars
Material*	/	Scrap iron	Scrap iron
How made		Forged	Forged
Dimensions		by dia	18 1/2 x 2 1/2
Progress on Inspection		Forging & smithing	Forging
Dates when Inspected		4. 16. 17/3/93. 4. 13. 98 27. 28/4/93 10/5/93	10. 15. 23. 24. 27/2/93 4/3/93

SKETCHES OF FRAMES SHEWING POSITION AND DESCRIPTION OF WELDS OF FORGINGS, OR PARTICULARS OF TESTS APPLIED TO CASTINGS.

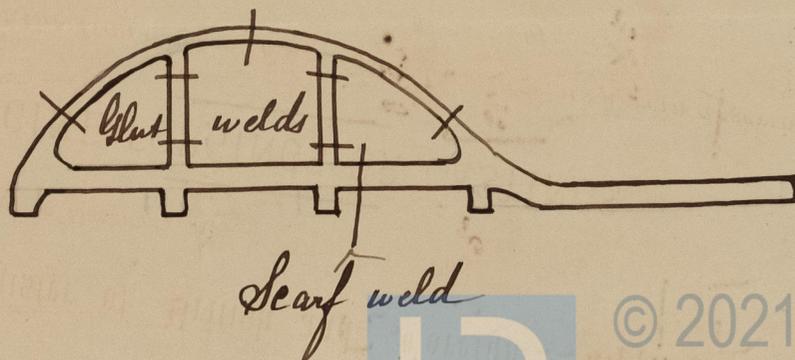

* If of Iron, state whether scrap or puddled Iron.



© 2021

Lloyd's Register Foundation