

Lloyd's Register of British and Foreign Shipping.

(Report on Vessel No. 12132 Port Glasgow)

No. 3707

SHIP FORGINGS OR CASTINGS

The words FORGINGS or CASTINGS, IRON or STEEL, should be struck out as may be required.

I have to report that the undermentioned Iron ~~or Steel~~ Forgings ~~or Castings~~, manufactured by The Kilmystown Forge Co. of Kilmarton. for the Vessel No. 272, being built by The London & Glasgow Eng & S. B. Co. of Glasgow. have been inspected by me as set forth below, and found to be, so far as can be seen, Sound.

Mark on Forgings.


Lloyd's
No. 3707
F.C.

Frank Cook.

Glasgow
1/9/92

	STERN FRAME.	RUDDER FRAME.	STEM.
Material*	<u>Scrap Iron</u>	/	<u>Scrap Iron.</u>
How made	<u>Forged</u>		<u>Forged.</u>
Dimensions	<u>11" x 6 3/4"</u>		<u>11" x 27/8"</u>
Progress on Inspection	<u>Forging & Smithing</u>		<u>Forging & Smithing</u>
Dates when Inspected	<u>26.3.15/92. 2.7.10.14.24</u> <u>30/6/92. 5.23.29/8/92. 1/9/92.</u>		<u>17.21.24/6/92. 7.12/7/92</u> <u>10/8/92.</u>

SKETCHES OF FRAMES SHOWING POSITION AND DESCRIPTION OF WELDS OF FORGINGS, OR PARTICULARS OF TESTS APPLIED TO CASTINGS.

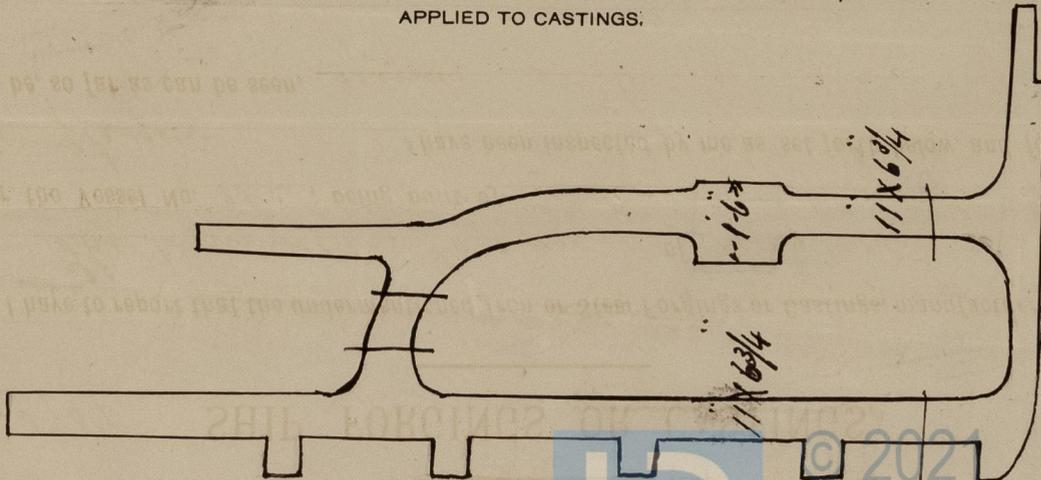

Glut Welds