


25.4.92.
30.5.92

LONGITUDINAL SECTION S.S.N^o 272.

Scale $\frac{1}{8}'' = 1'$

DIMENSIONS 360' x 44' x 29' 6" MID TO UPPER DECK

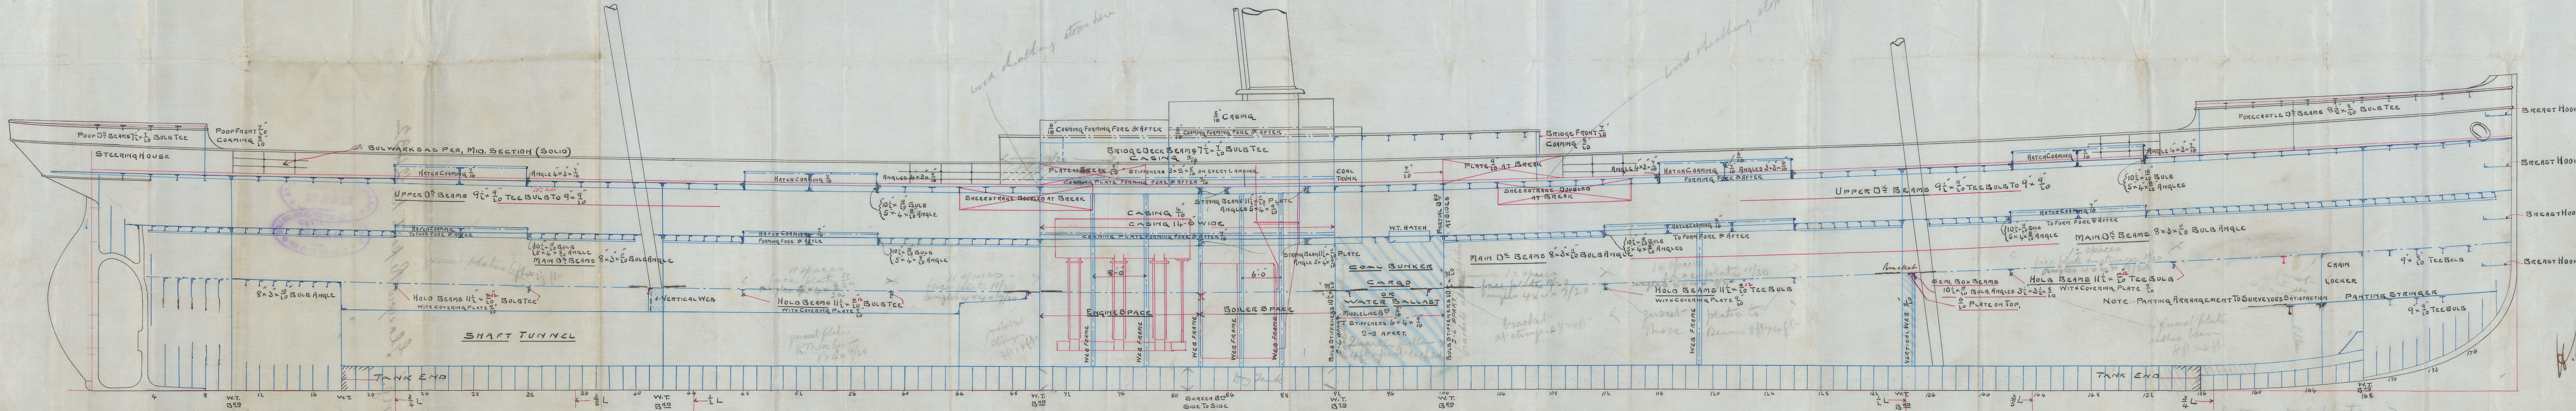

Intercastals
between floors

272
30/5/92


104

22

128

Intercastals
between floors

"Colong." Glasgow Report No. 12432.
Profile.

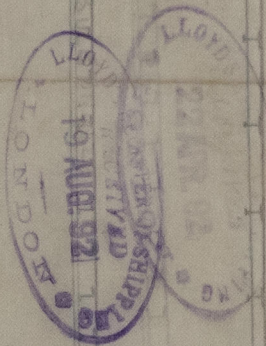

© 2021

Lloyd's Register
Foundation

GL9235-0122