


Dr: 7/6/92

UPPER DECK PLAN S.S. N° 242

SCALE  $\frac{1}{8}$  INCH = ONE FOOT

PLEASE NOTE STEEL D<sup>n</sup> IS REQUIRED FOR 1/2 LGTH ONLY BY RULES

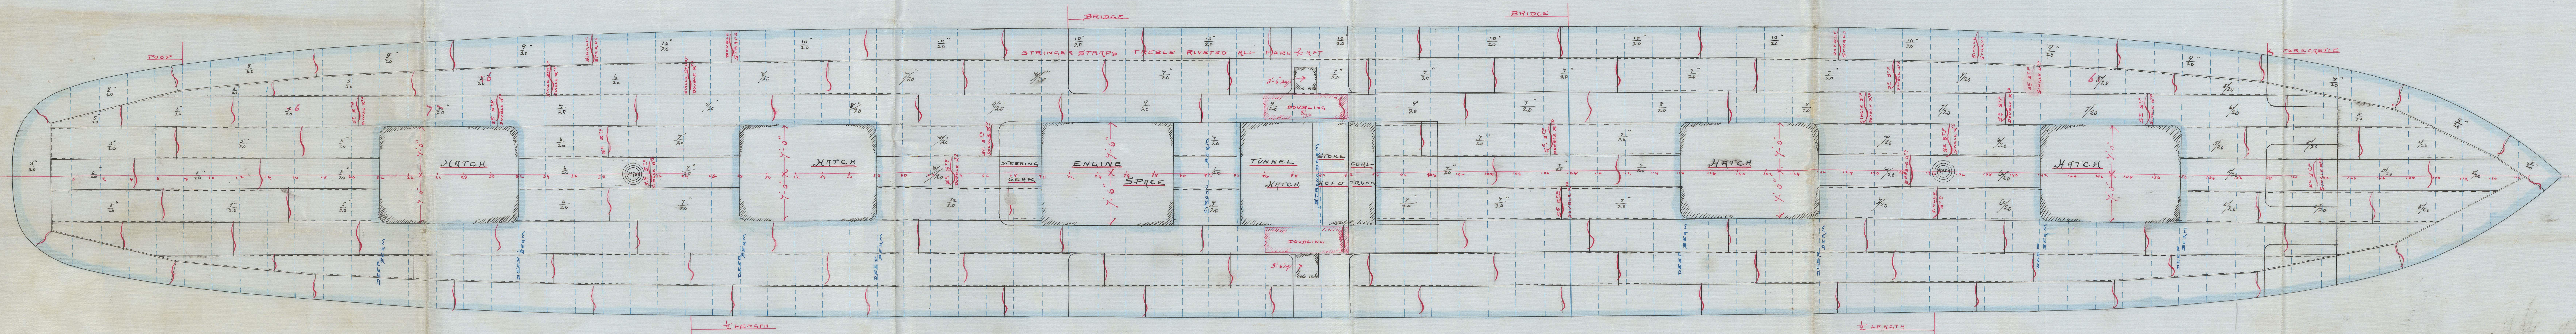


88 Watson " Glasgow Report 1914, 32.



SS "Colony"  
 Glasgow 12432.  
Upper Deck plan

Mr. J. A. / 18 / 1892

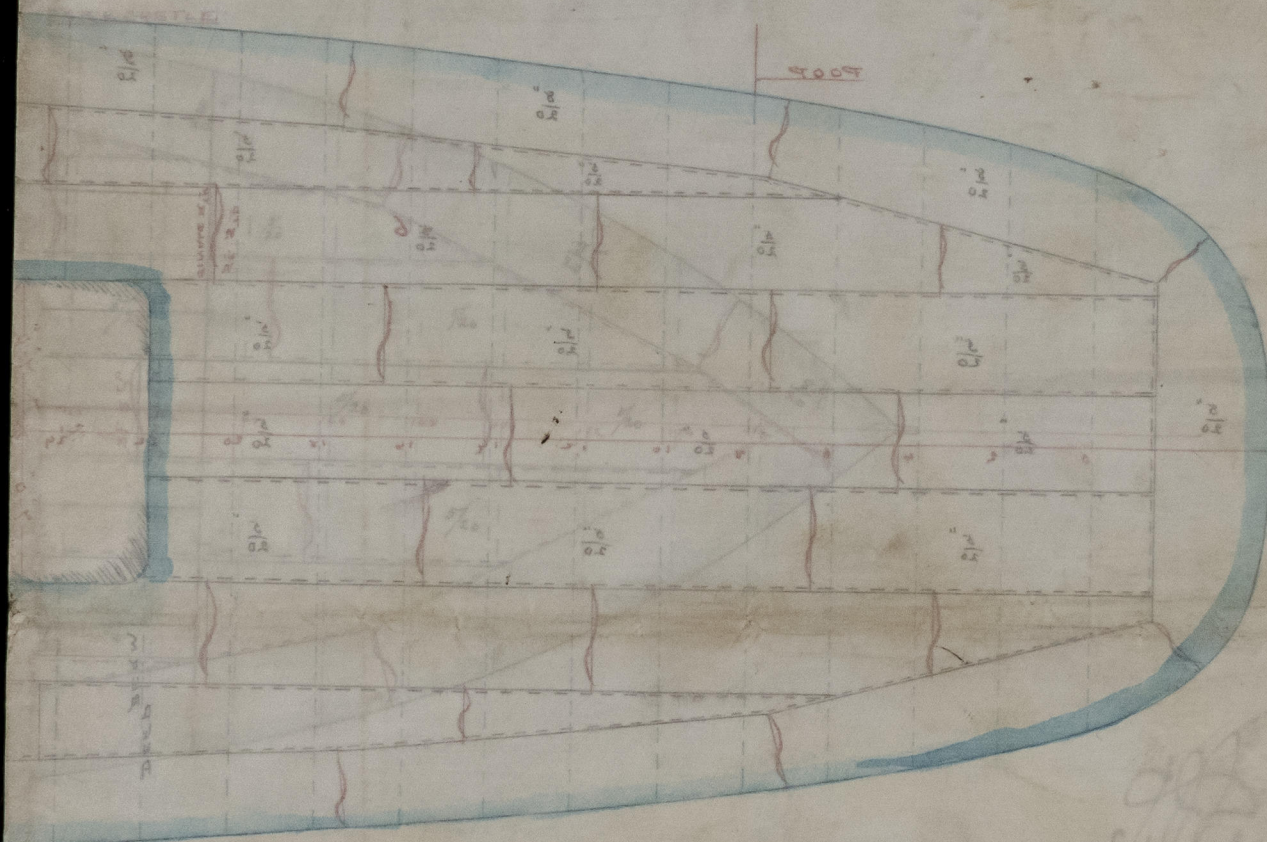

GLS235-0124

GLS235-0124



© 2021

Lloyd's Register  
 Foundation