




19: 8: 92

S.S. No. 242

Outline of Reg.


Scale 1/32 = 1 Foot

Handwritten text: "S.S. No. 242" and "Shipping Plan" in reverse.

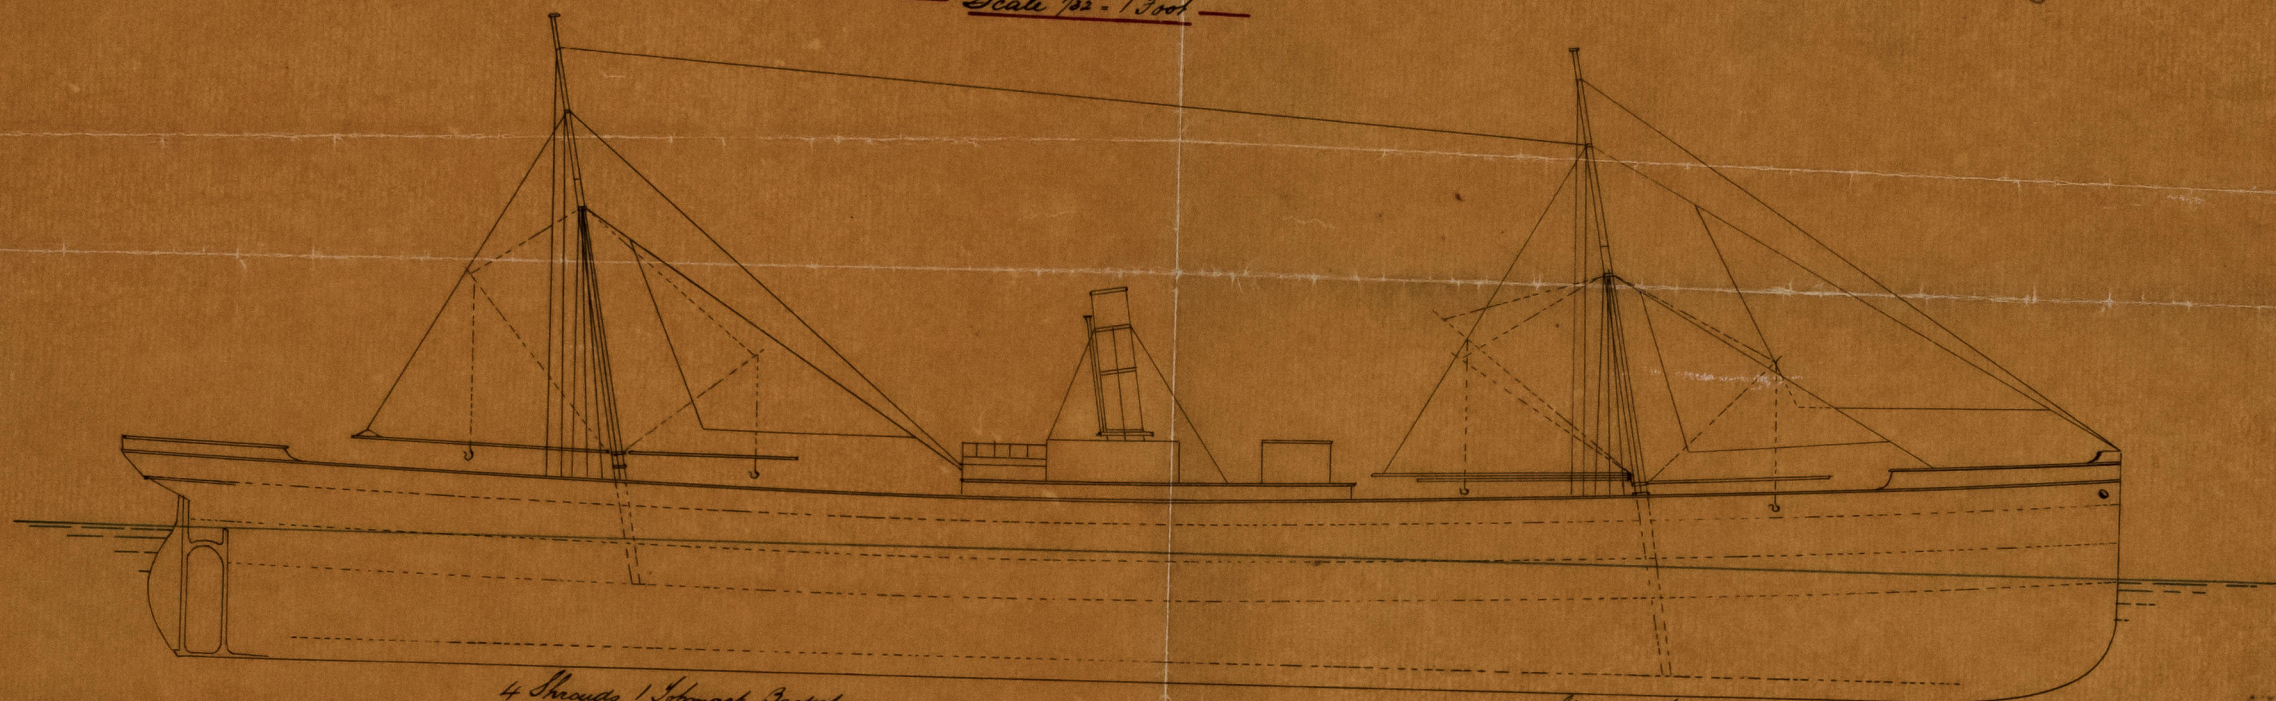

4 Shrouds 1 Topmast Backstay
+ 1 Topgallant Backstay

4 Shrouds 1 Topmast Backstay
+ 1 Topgallant Backstay

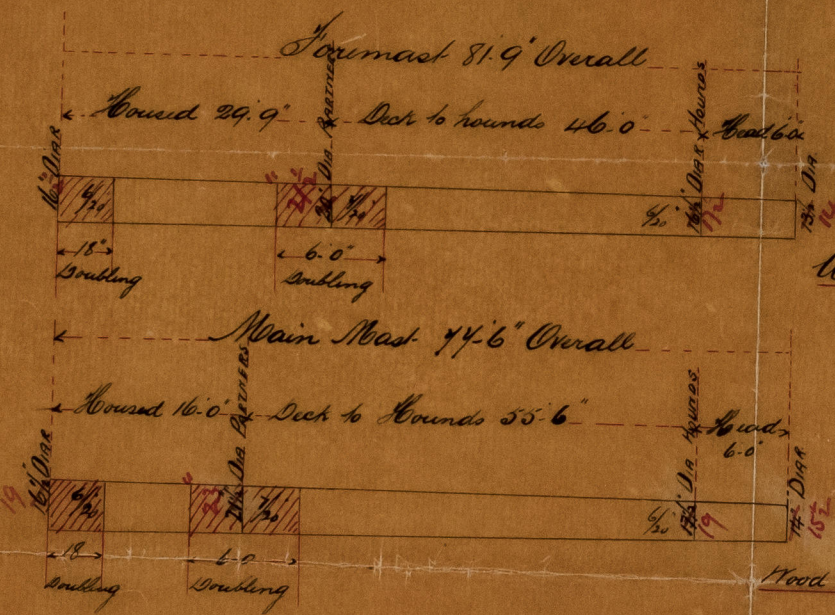

Foremast 81' 9" Overall


Deck to hounds 46' 0"

Head 6' 0"

Main Mast 74' 6" Overall


Deck to Hounds 55' 6"

Head 6' 0"

Wood telescopic topmast

Wood telescopic topmast

Steel Masts

Masts formed with two plates on the round
Seams single riveted throughout
Buttstraps from partners to hounds ^{head} triple riveted
+ 3/8" thicker than plates
Remainder double riveted + 1/2" thicker
than plate.




© 2021

Lloyd's Register
2097
Foundation

GLS235-0128

S S "Polong" Glasgow Report 12432 Rigging Plan.

19: 8: 01
 19: 8: 01
 19: 8: 01

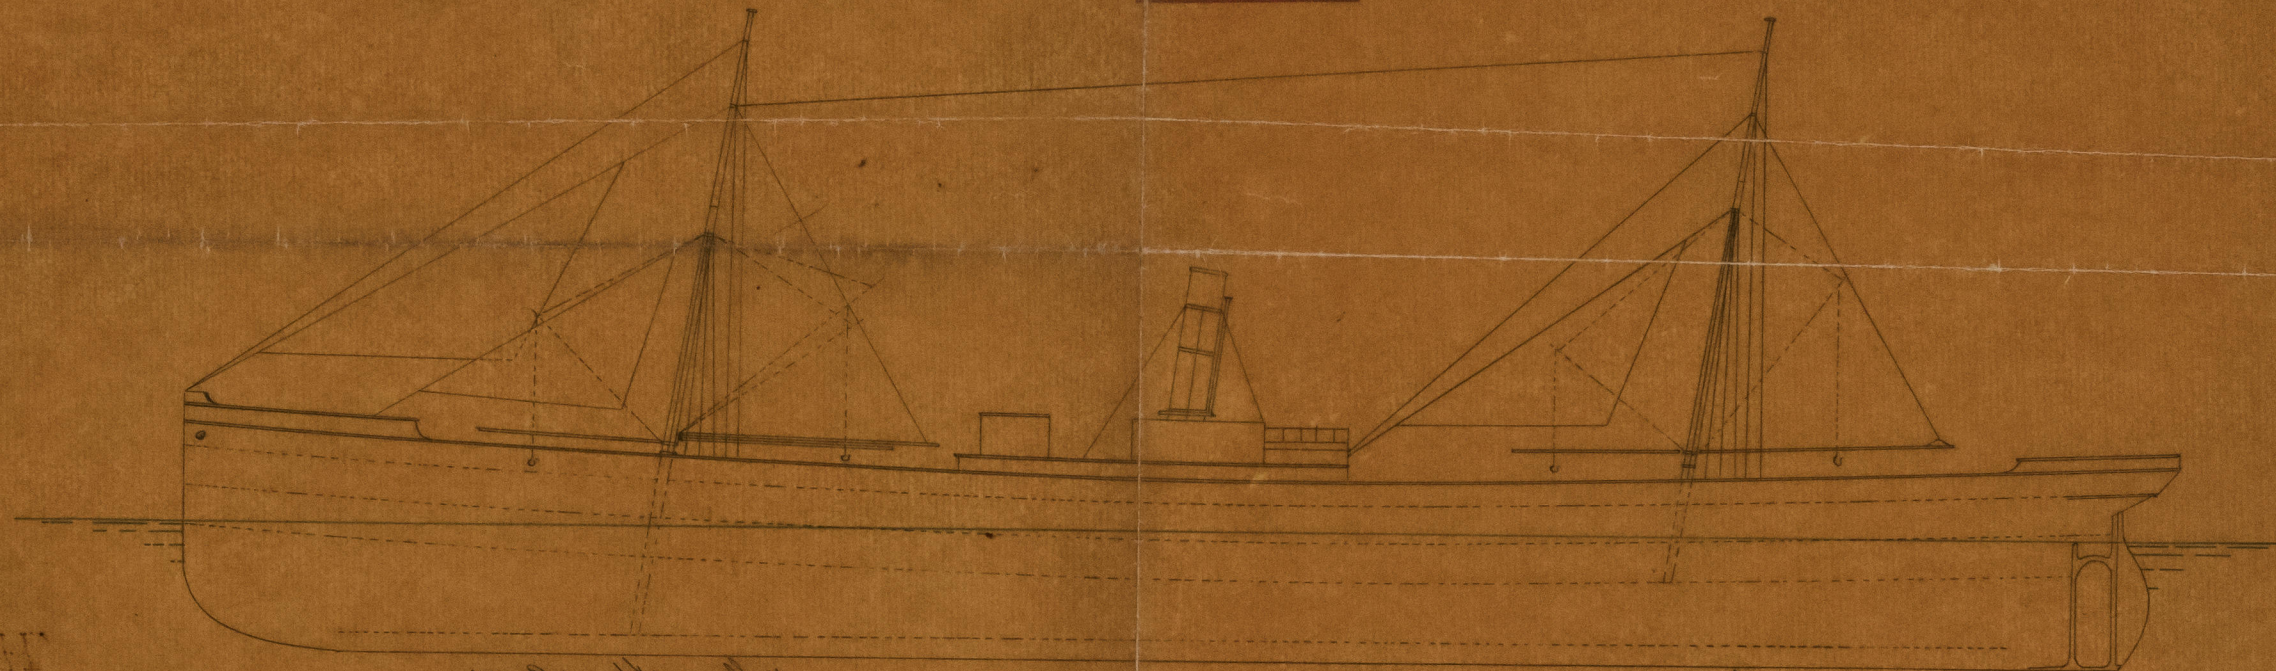






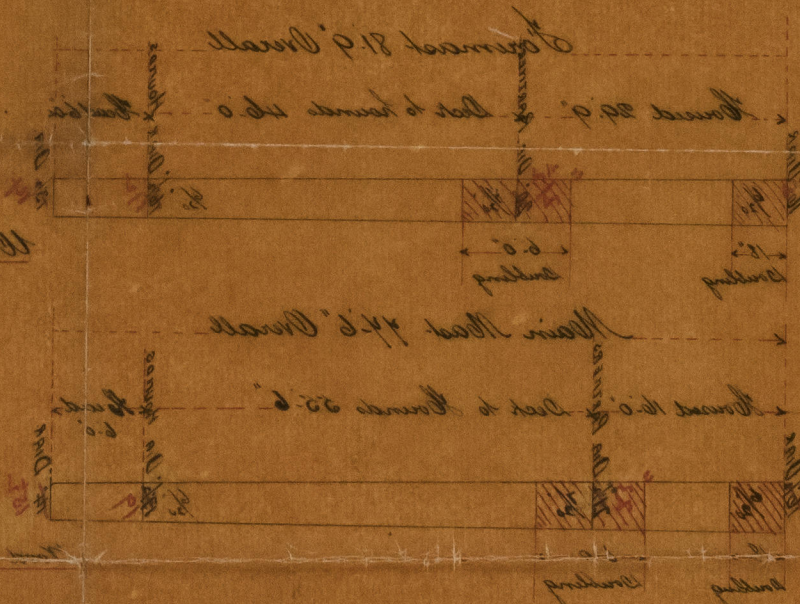

© 2021
 Lloyd's Register
 Foundation

19 11
 1905