

Lloyd's Register of British and Foreign Shipping.

(Report on Vessel No. 12140 Port Glasgow)

No. 4091

SHIP FORGINGS ~~OR CASTINGS~~

The words FORGINGS or CASTINGS, IRON or STEEL, should be struck out as may be required.

I have to report that the undermentioned Iron ~~or Steel~~ Forgings ~~or Castings~~,
manufactured by Messrs Robt Kerr & Sons
of Irvine for the Vessel No. 404, being built
by Messrs Lobnitz & Coy of Renfrew
have been inspected by me as set forth below, and found to be, so far as can be seen,

Mark on Forgings.

Lloyd's

No. 4091


W. H.

William Hamilton

Glasgow
20/5/93

	STERN FRAME.	RUDDER FRAME.	STEM.
Material*	<u>Scrap iron</u> <u>Forged</u> <u>4 1/2 to 2 3/4</u> <u>Forging & smithing</u> <u>18/4/93. 1. 16. 19/5/93.</u>		
How made			
Dimensions			
Progress on Inspection			
Date when Inspected			

SKETCHES OF FRAMES SHOWING POSITION AND DESCRIPTION OF WELDS OF FORGINGS, OR PARTICULARS OF TESTS APPLIED TO CASTINGS.

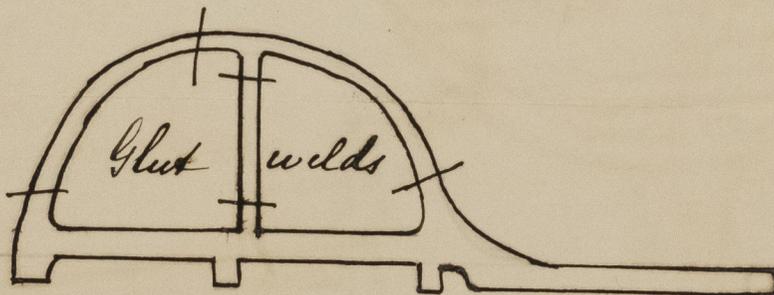

© 2021

Lloyd's Register
Foundation