

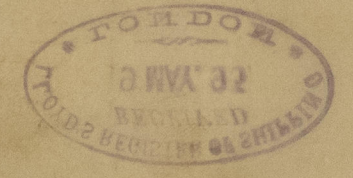


D. 5. 93  

- Profile and Deck Plan of S.S. N<sup>o</sup> 117. -  
 - Scale  $\frac{1}{4}$  Inch = 1 Foot. -

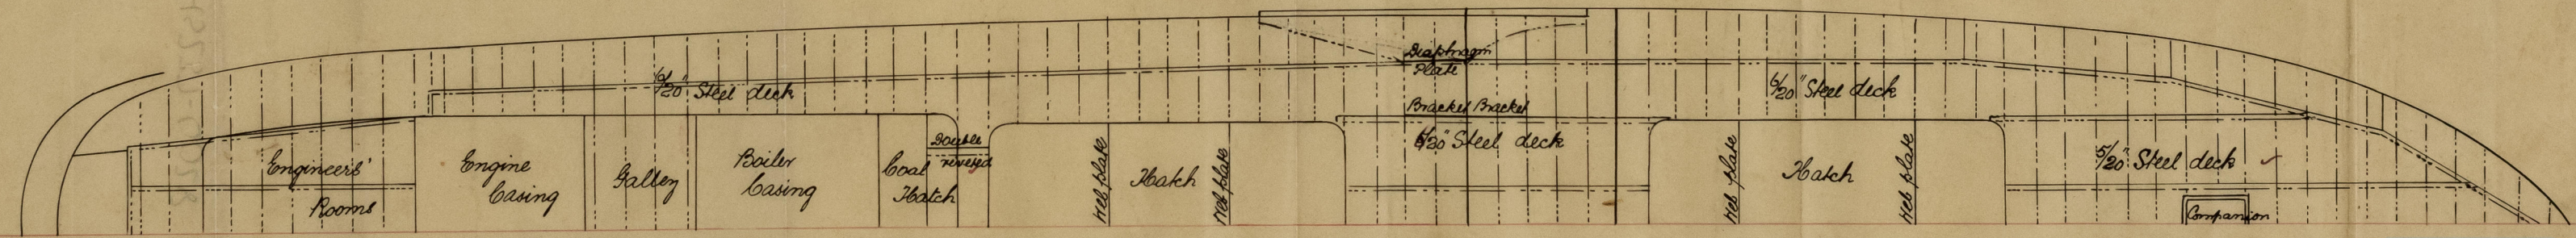


CL  
 875/93  
 GUTHRIE & CO.  
 2021  
 Shipbuilders  
 6 May '93  
 Lloyd's Register  
 Foundation  
 GLS 237-0028

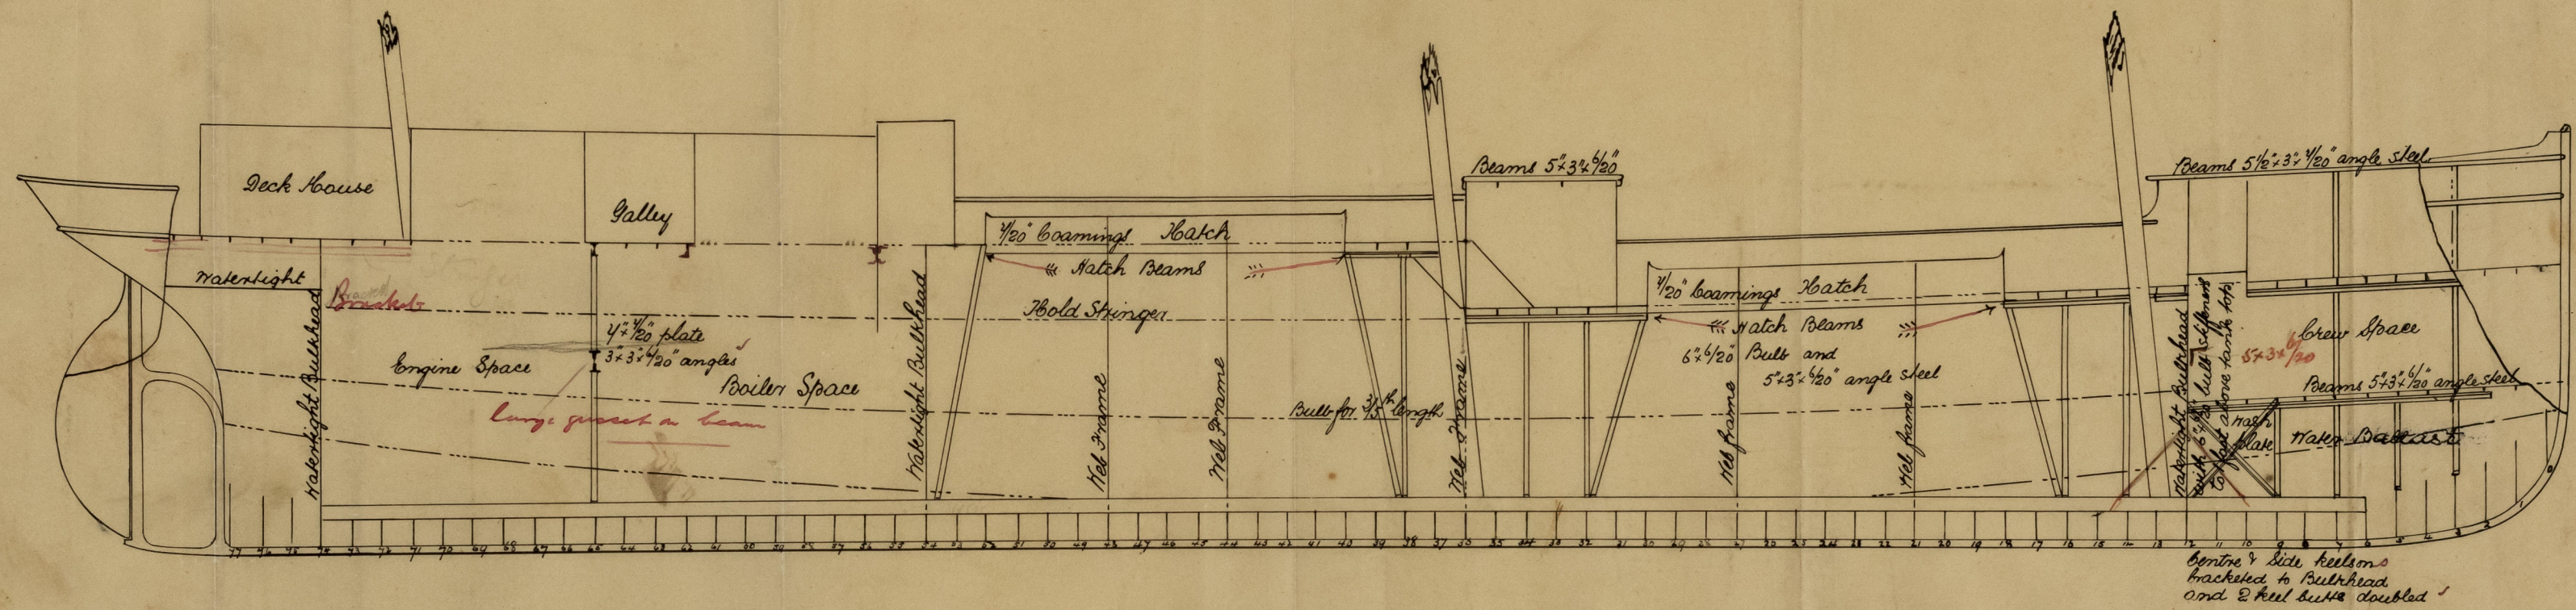


S. S. "Ringsend" Glasgow Report No. 12542

223

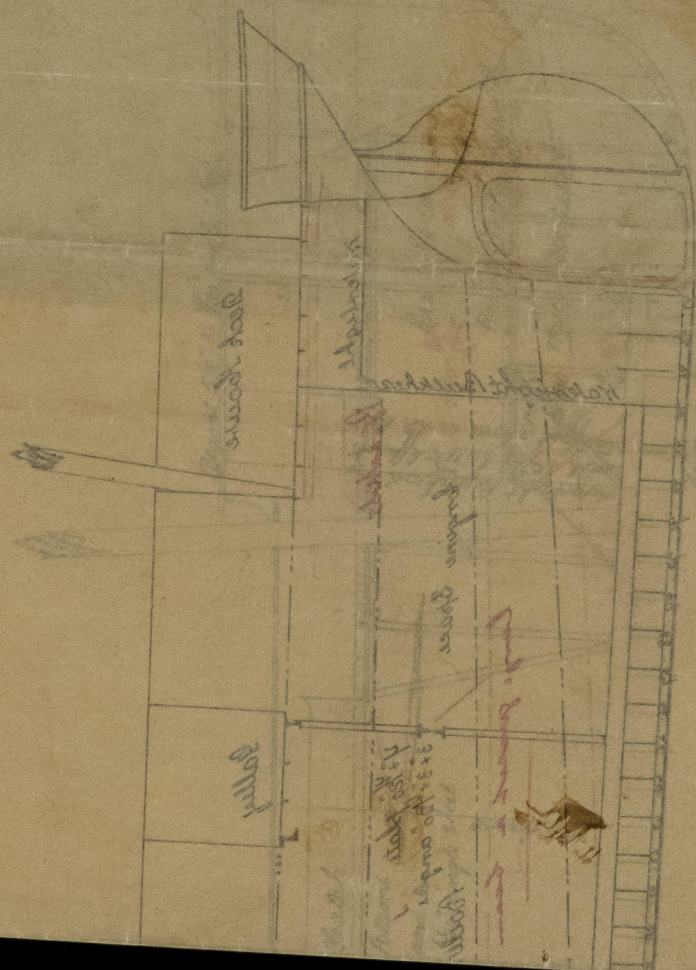

GLS237-0028

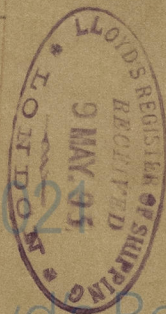

Lloyd's Register  
Foundation