


Dr: 11.8.93

PUMPING PLAN OF P.S N° 316
SCALE 1/8" = 1 FOOT

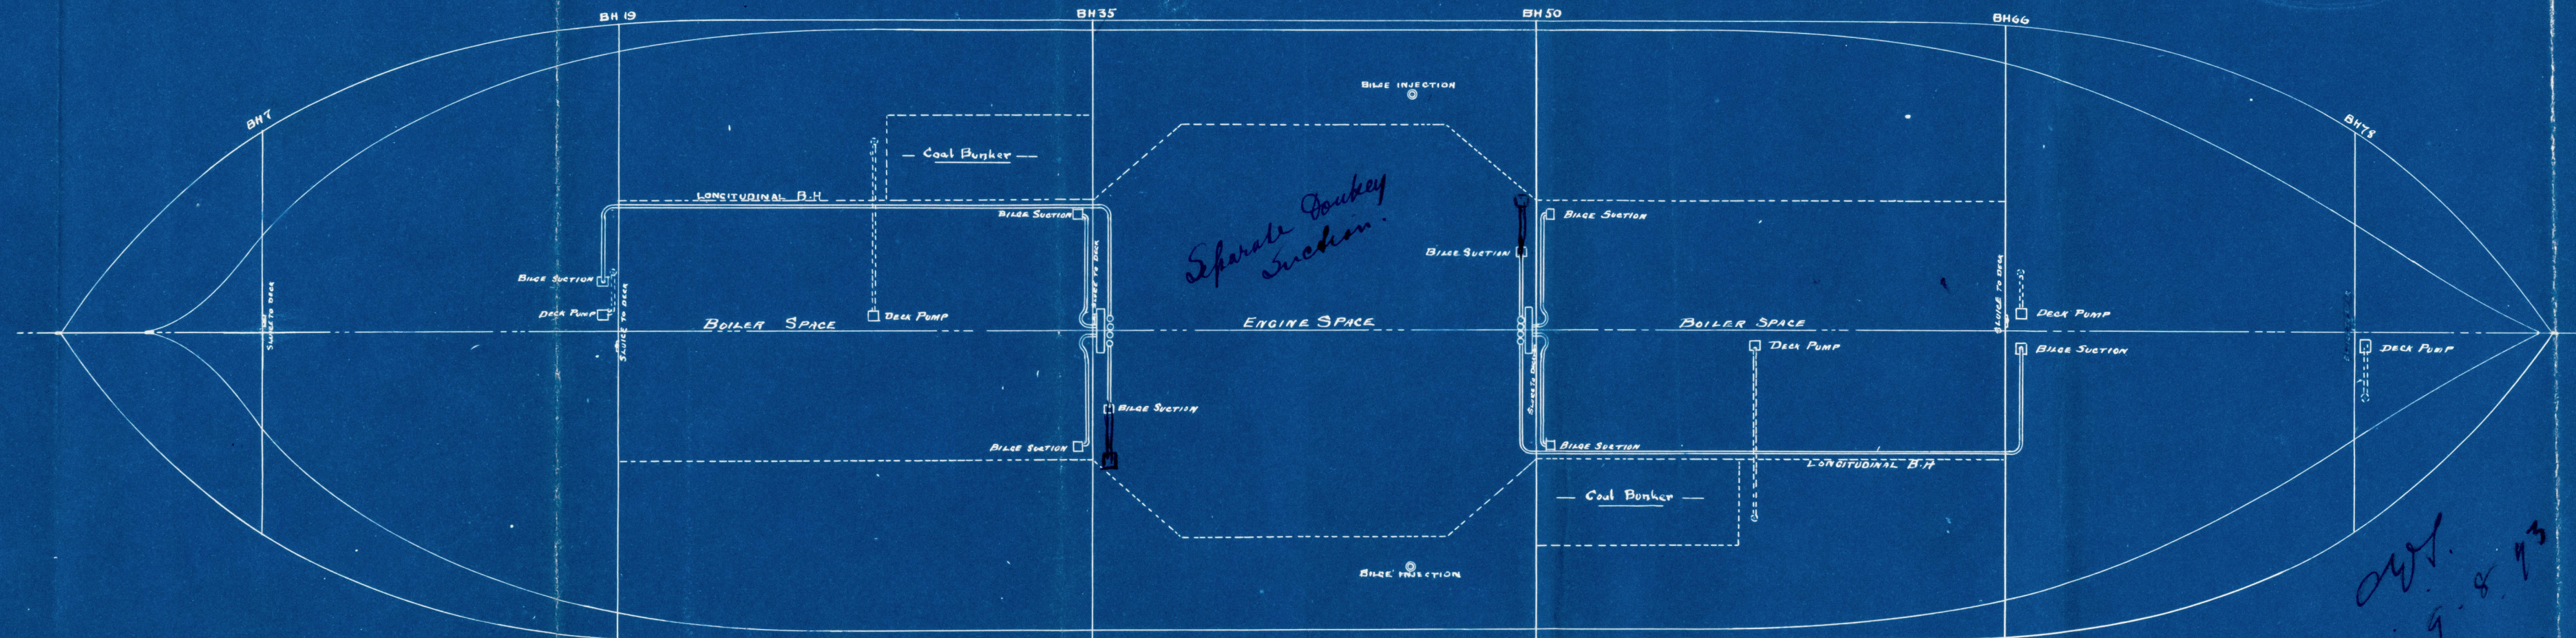

N.A.
11.8.93

W. SIMONS & CO
LONDON WORKS
RENFREW.

Oct.
9.8.93
C.E.
9.8.93



Lloyd's Register
Foundation
65251 006

P. S. "Hutton" Glasgow Report N^o 12566. —



© 2021

Lloyd's Register
Foundation

GLS237-0064