


MIDSHIP SECTION

No 490

DIMENSIONS 345' x 44' x 30' M²

TO CLASS 100 A.I. AT LLOYDS. 3 DECK RULE


SCALE 1/2" = 1 FT.
[BUILT OF STEEL.]

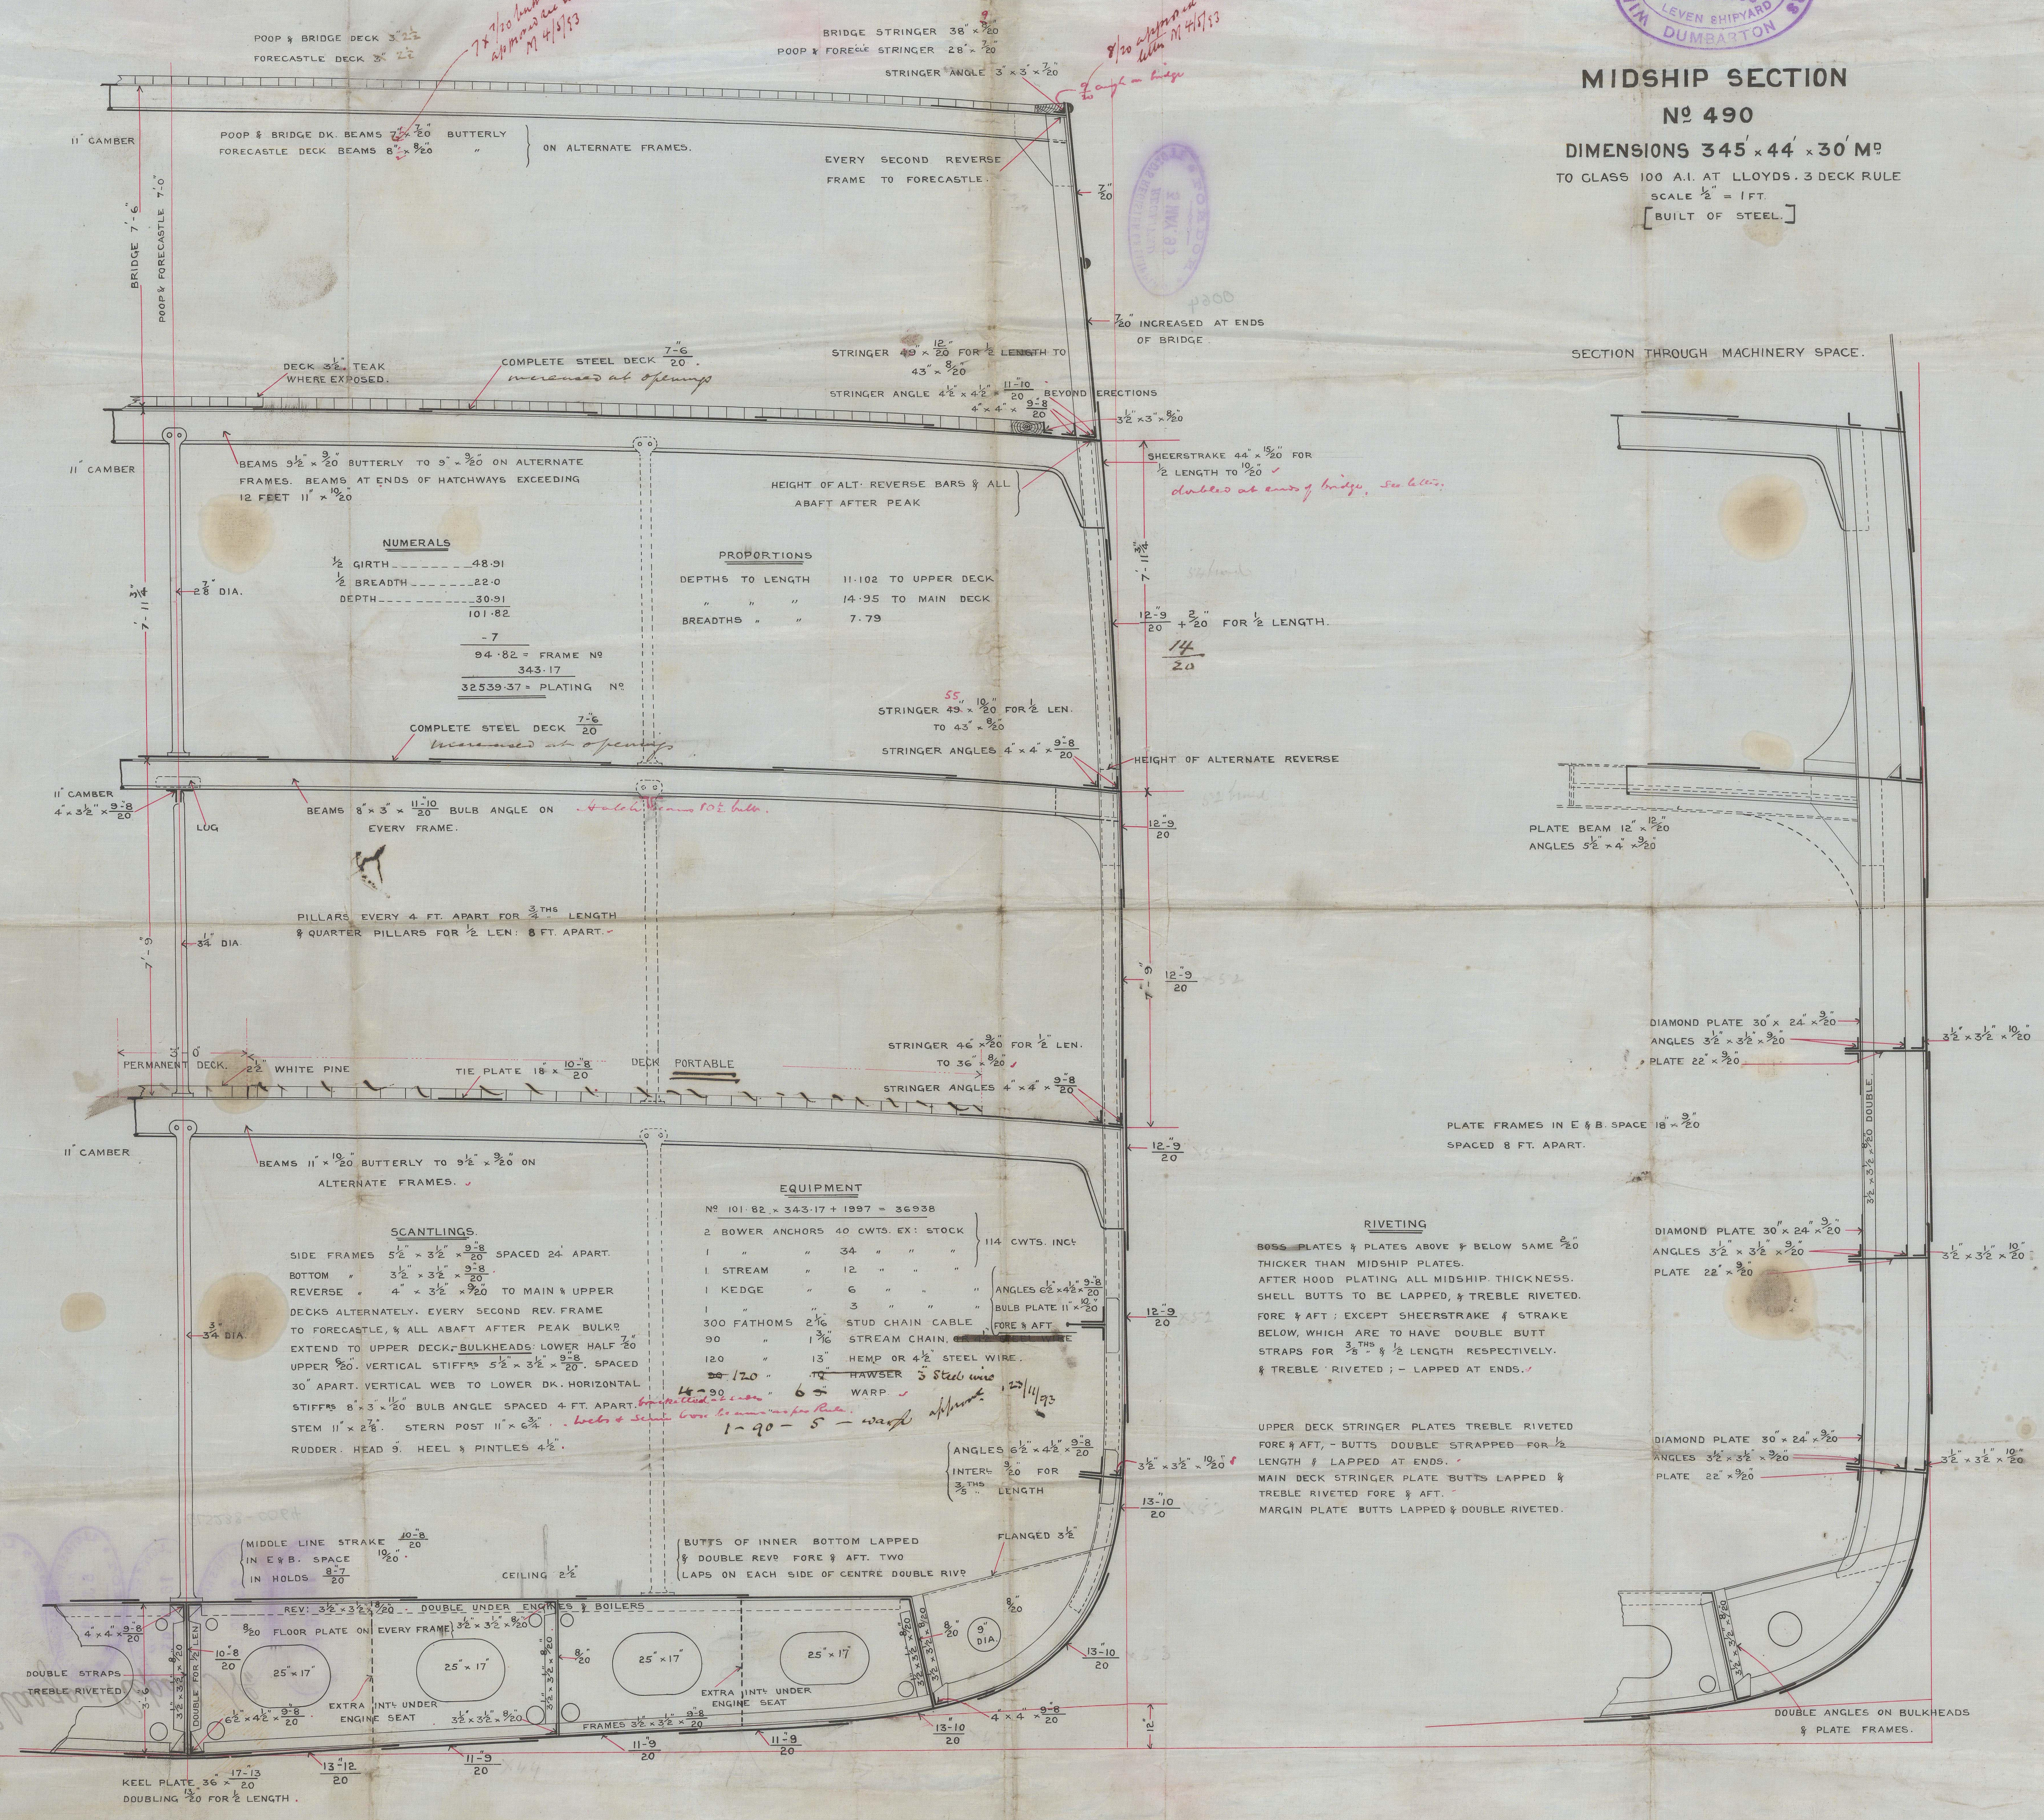

24.4.93
4.5.93
23.11.93.



7/20 bulk
approved
M 4/1/93

8/30 approved by
M 4/1/93

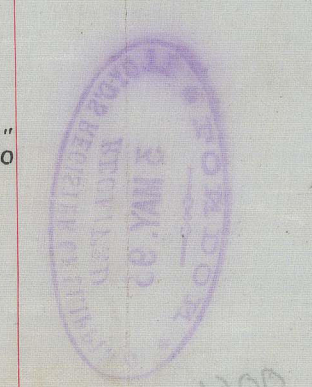


GLS238-0064

S.S. "Prometheus" Glasgow Report No.

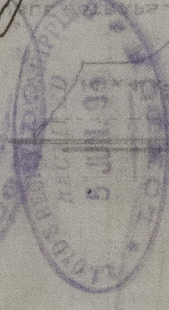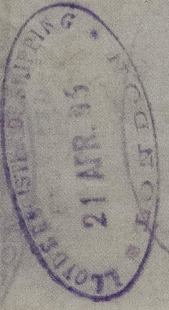

GLS238-0064

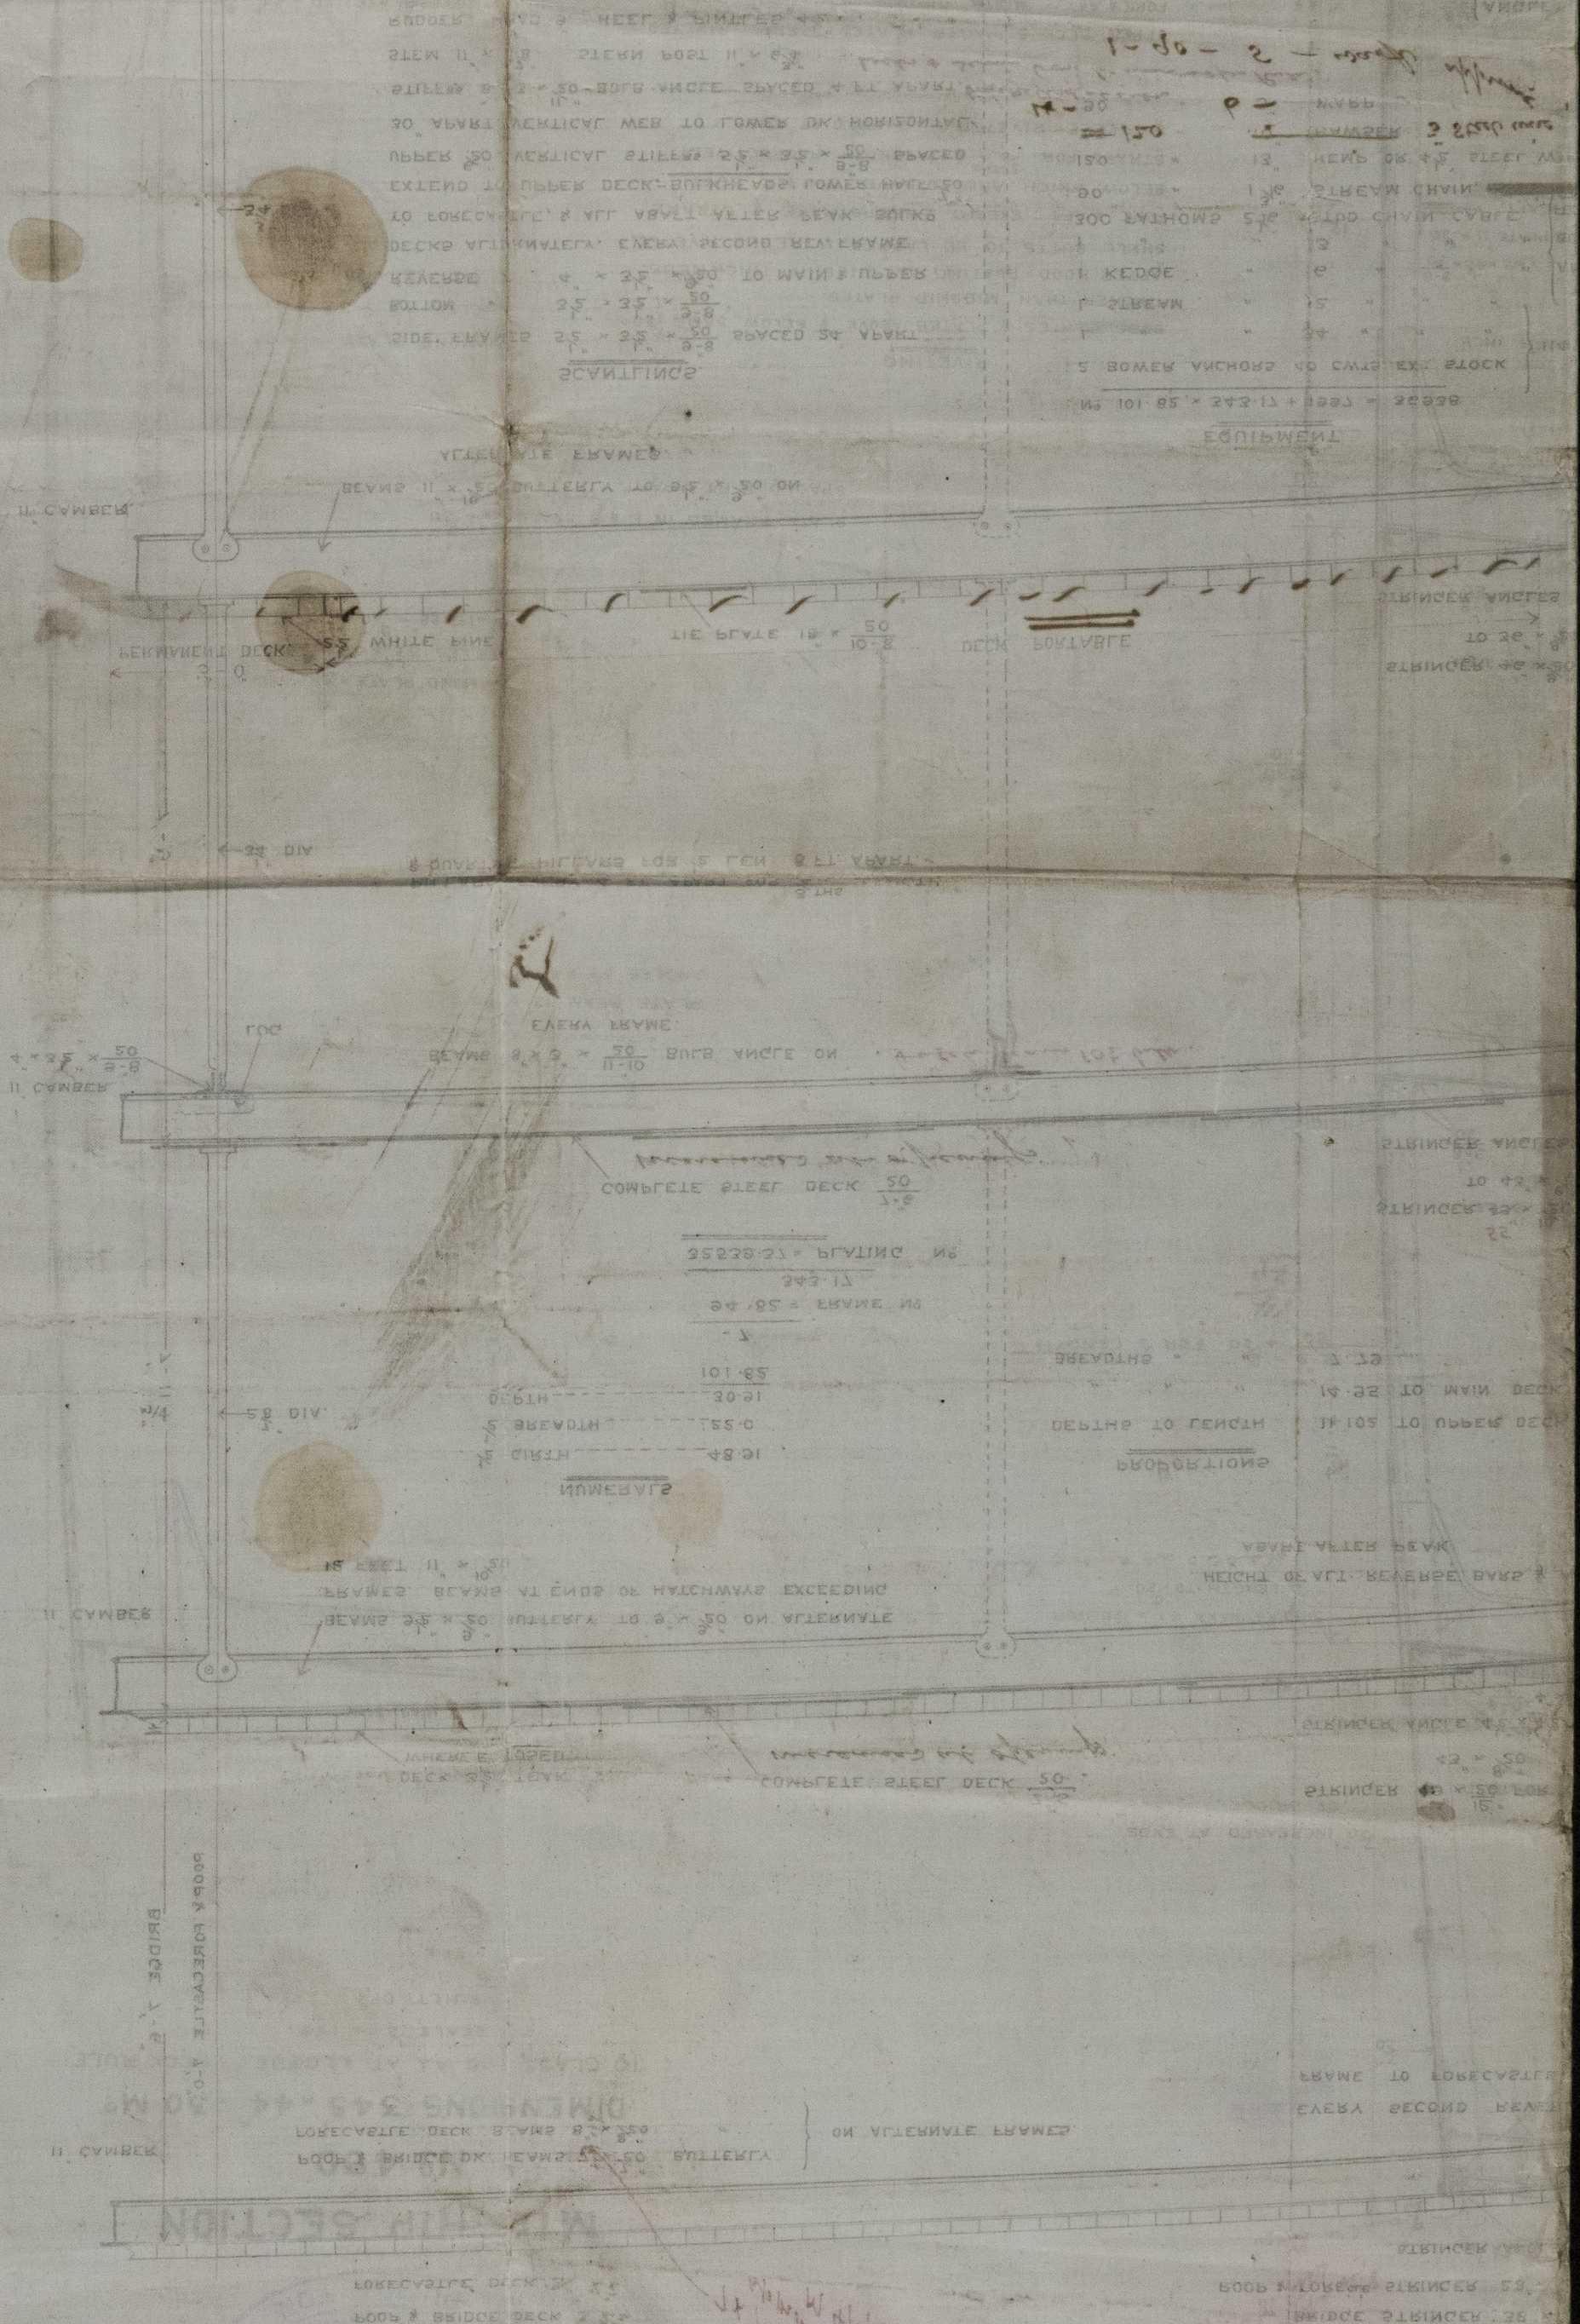

53.11.23
H. 2.23
M. 4.23

