

Lloyd's Register of British and Foreign Shipping.

(Report on Vessel No. 12684 Port Glasgow)"Angelot"No. 4318 SHIP FORGINGS ~~OR CASTINGS~~.

I have to report that the undermentioned Iron ~~or Steel~~ Forgings ~~or Castings~~,
 manufactured by The Irvine Forge Coy
 of Irvine for the Vessel No. 79, being built
 by Mess Mackie & Thomson of Glasgow
 have been inspected by me as set forth below, and found to be, so far as can be seen,
Sound & efficient


Mark on Forgings.

Lloyd's

No. 4318W. H.William HamiltonGlasgow20/10/93

	STERN FRAME.	RUDDER FRAME.	STEM.
Material*	Scrap iron		
How made	Forged		
Dimensions	542		
Progress on Inspection	Forging & smithing		
Date when Inspected	4. 12. 19. 20/10/93		

SKETCHES OF FRAMES SHOWING POSITION AND DESCRIPTION OF WELDS OF FORGINGS, OR PARTICULARS OF
 TESTS APPLIED TO CASTINGS.

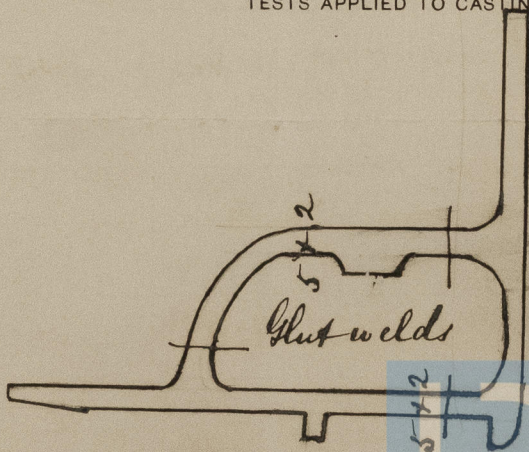

© 2021

Lloyd's Register
Foundation