



See H. to Gls.
12.10.93.

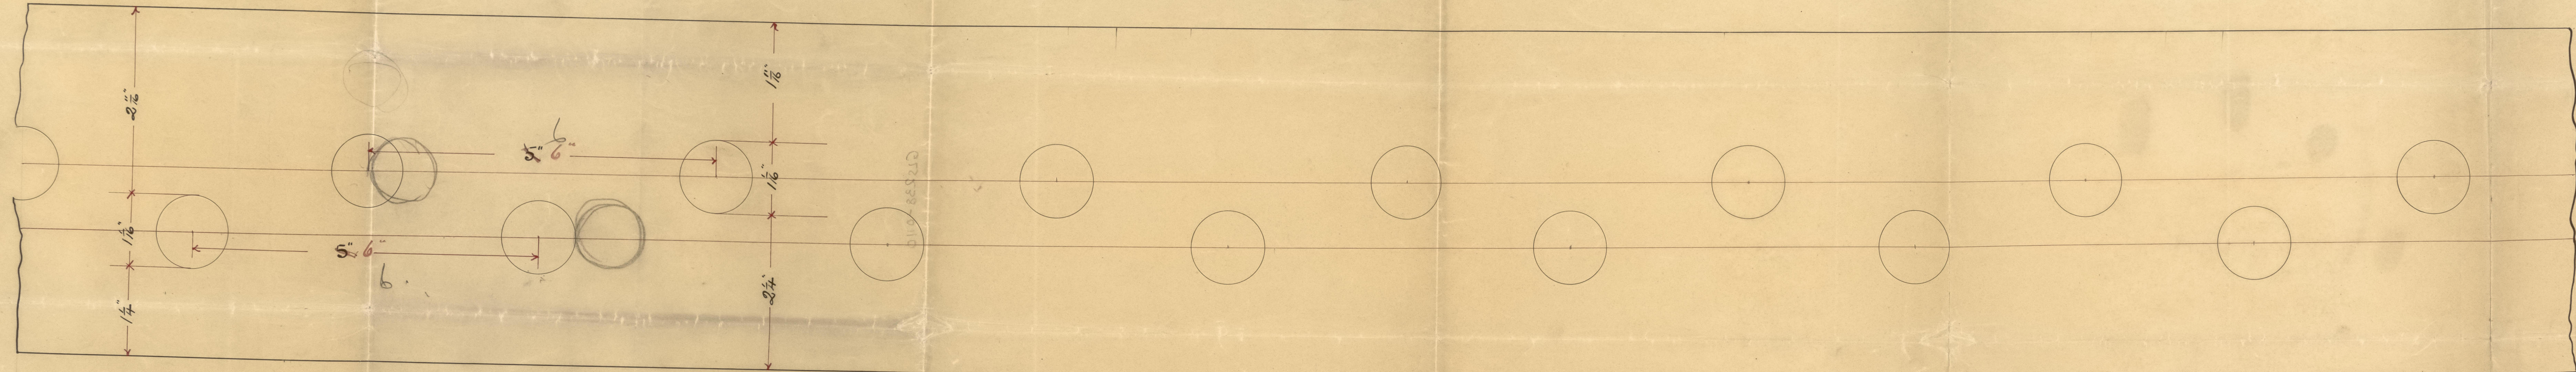

Model of keel
GLS 238-0110
12.10.93

No 79080
Sketch showing Arrangement of
Rivet Holes in Keel. - Full Size.

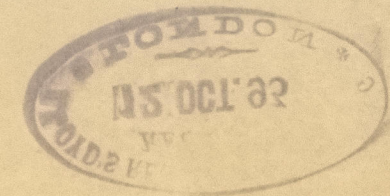

J. T. 11.10.93

S.S. "Angelo" Glasgow Report No 12684
S.S. "Buffalo" — do — " 12688

GLS 238-0110



Lloyd's Register
Foundation