

Lloyd's Register of British and Foreign Shipping.

(Report on Vessel No. 12684 Port Glasgow
"Angelo")

No. 4316

SHIP FORGINGS OR ~~CASTINGS~~.

The words FORGINGS or CASTINGS, IRON or STEEL, should be struck out as may be required.

I have to report that the undermentioned Iron ~~or Steel~~ Forgings ~~or Castings~~,
manufactured by The Irvine Forge Coy
of Irvine for the Vessel No. 79, being built
by Messrs Mackie & Thomson of Glasgow
have been inspected by me as set forth below, and found to be, so far as can be seen,
Sound & efficient


Mark on Forgings.

Lloyd's
No. 4316
W.H.

William Hamilton
Glasgow 5/12/93

	STERN FRAME.	RUDDER FRAME.	STEM.
Material*	<div style="display: flex; justify-content: space-around;"> <div style="text-align: center;"> <p>Scrap iron Forged 3 1/2 x 2</p> <p>Forging & smithing</p> <p>6.9.15.20.27.29/11/93 4/12/93</p> </div> <div style="text-align: center;"> <p>12.12.19.20</p> </div> </div>		
How made			
Dimensions			
Progress on Inspection			
Date when Inspected			

SKETCHES OF FRAMES SHOWING POSITION AND DESCRIPTION OF WELDS OF FORGINGS, OR PARTICULARS OF TESTS APPLIED TO CASTINGS.

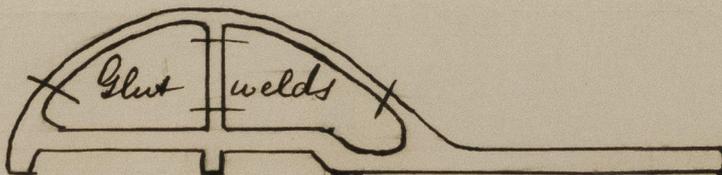

© 2021

Lloyd's Register
Foundation

* If of Iron, state whether scrap or puddled Iron.

4079



© 2021

Lloyd's Register
Foundation