


24270.

Nº 4-37

FLY TRACING SHEWING MODIFICATION TO AFT HOLD SUCTIONS ETC.

SCALE $\frac{1}{8}$ INCH TO ONE FOOT.

PLAN.

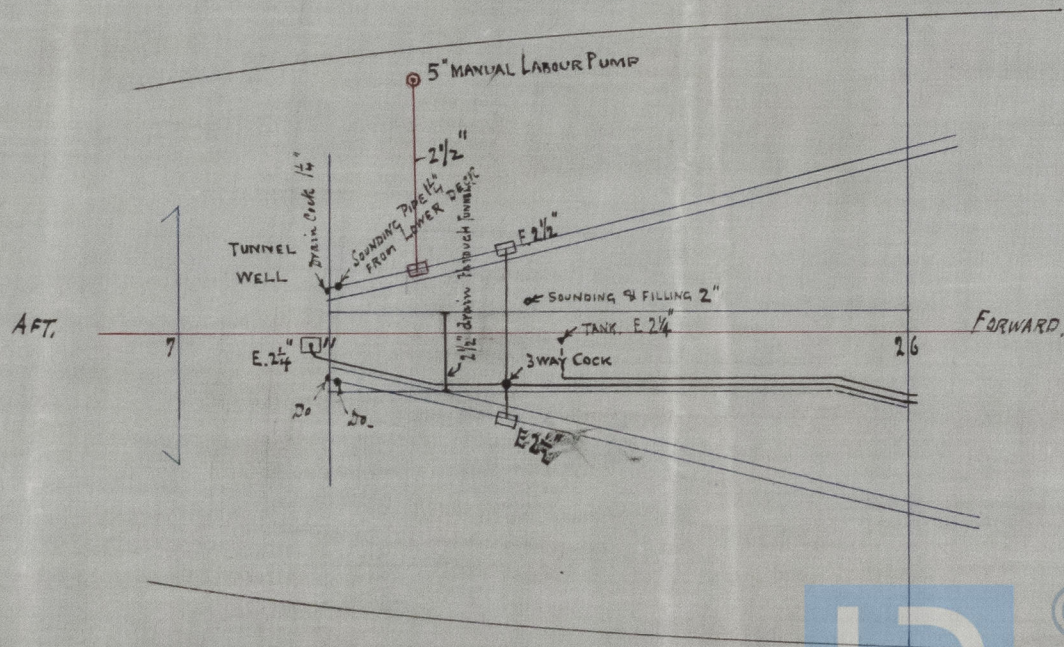

© 2021

Lloyd's Register
Foundation

GLS239-0016