


24191  
N<sup>o</sup> 437

See 9/10/93  
Ldr.

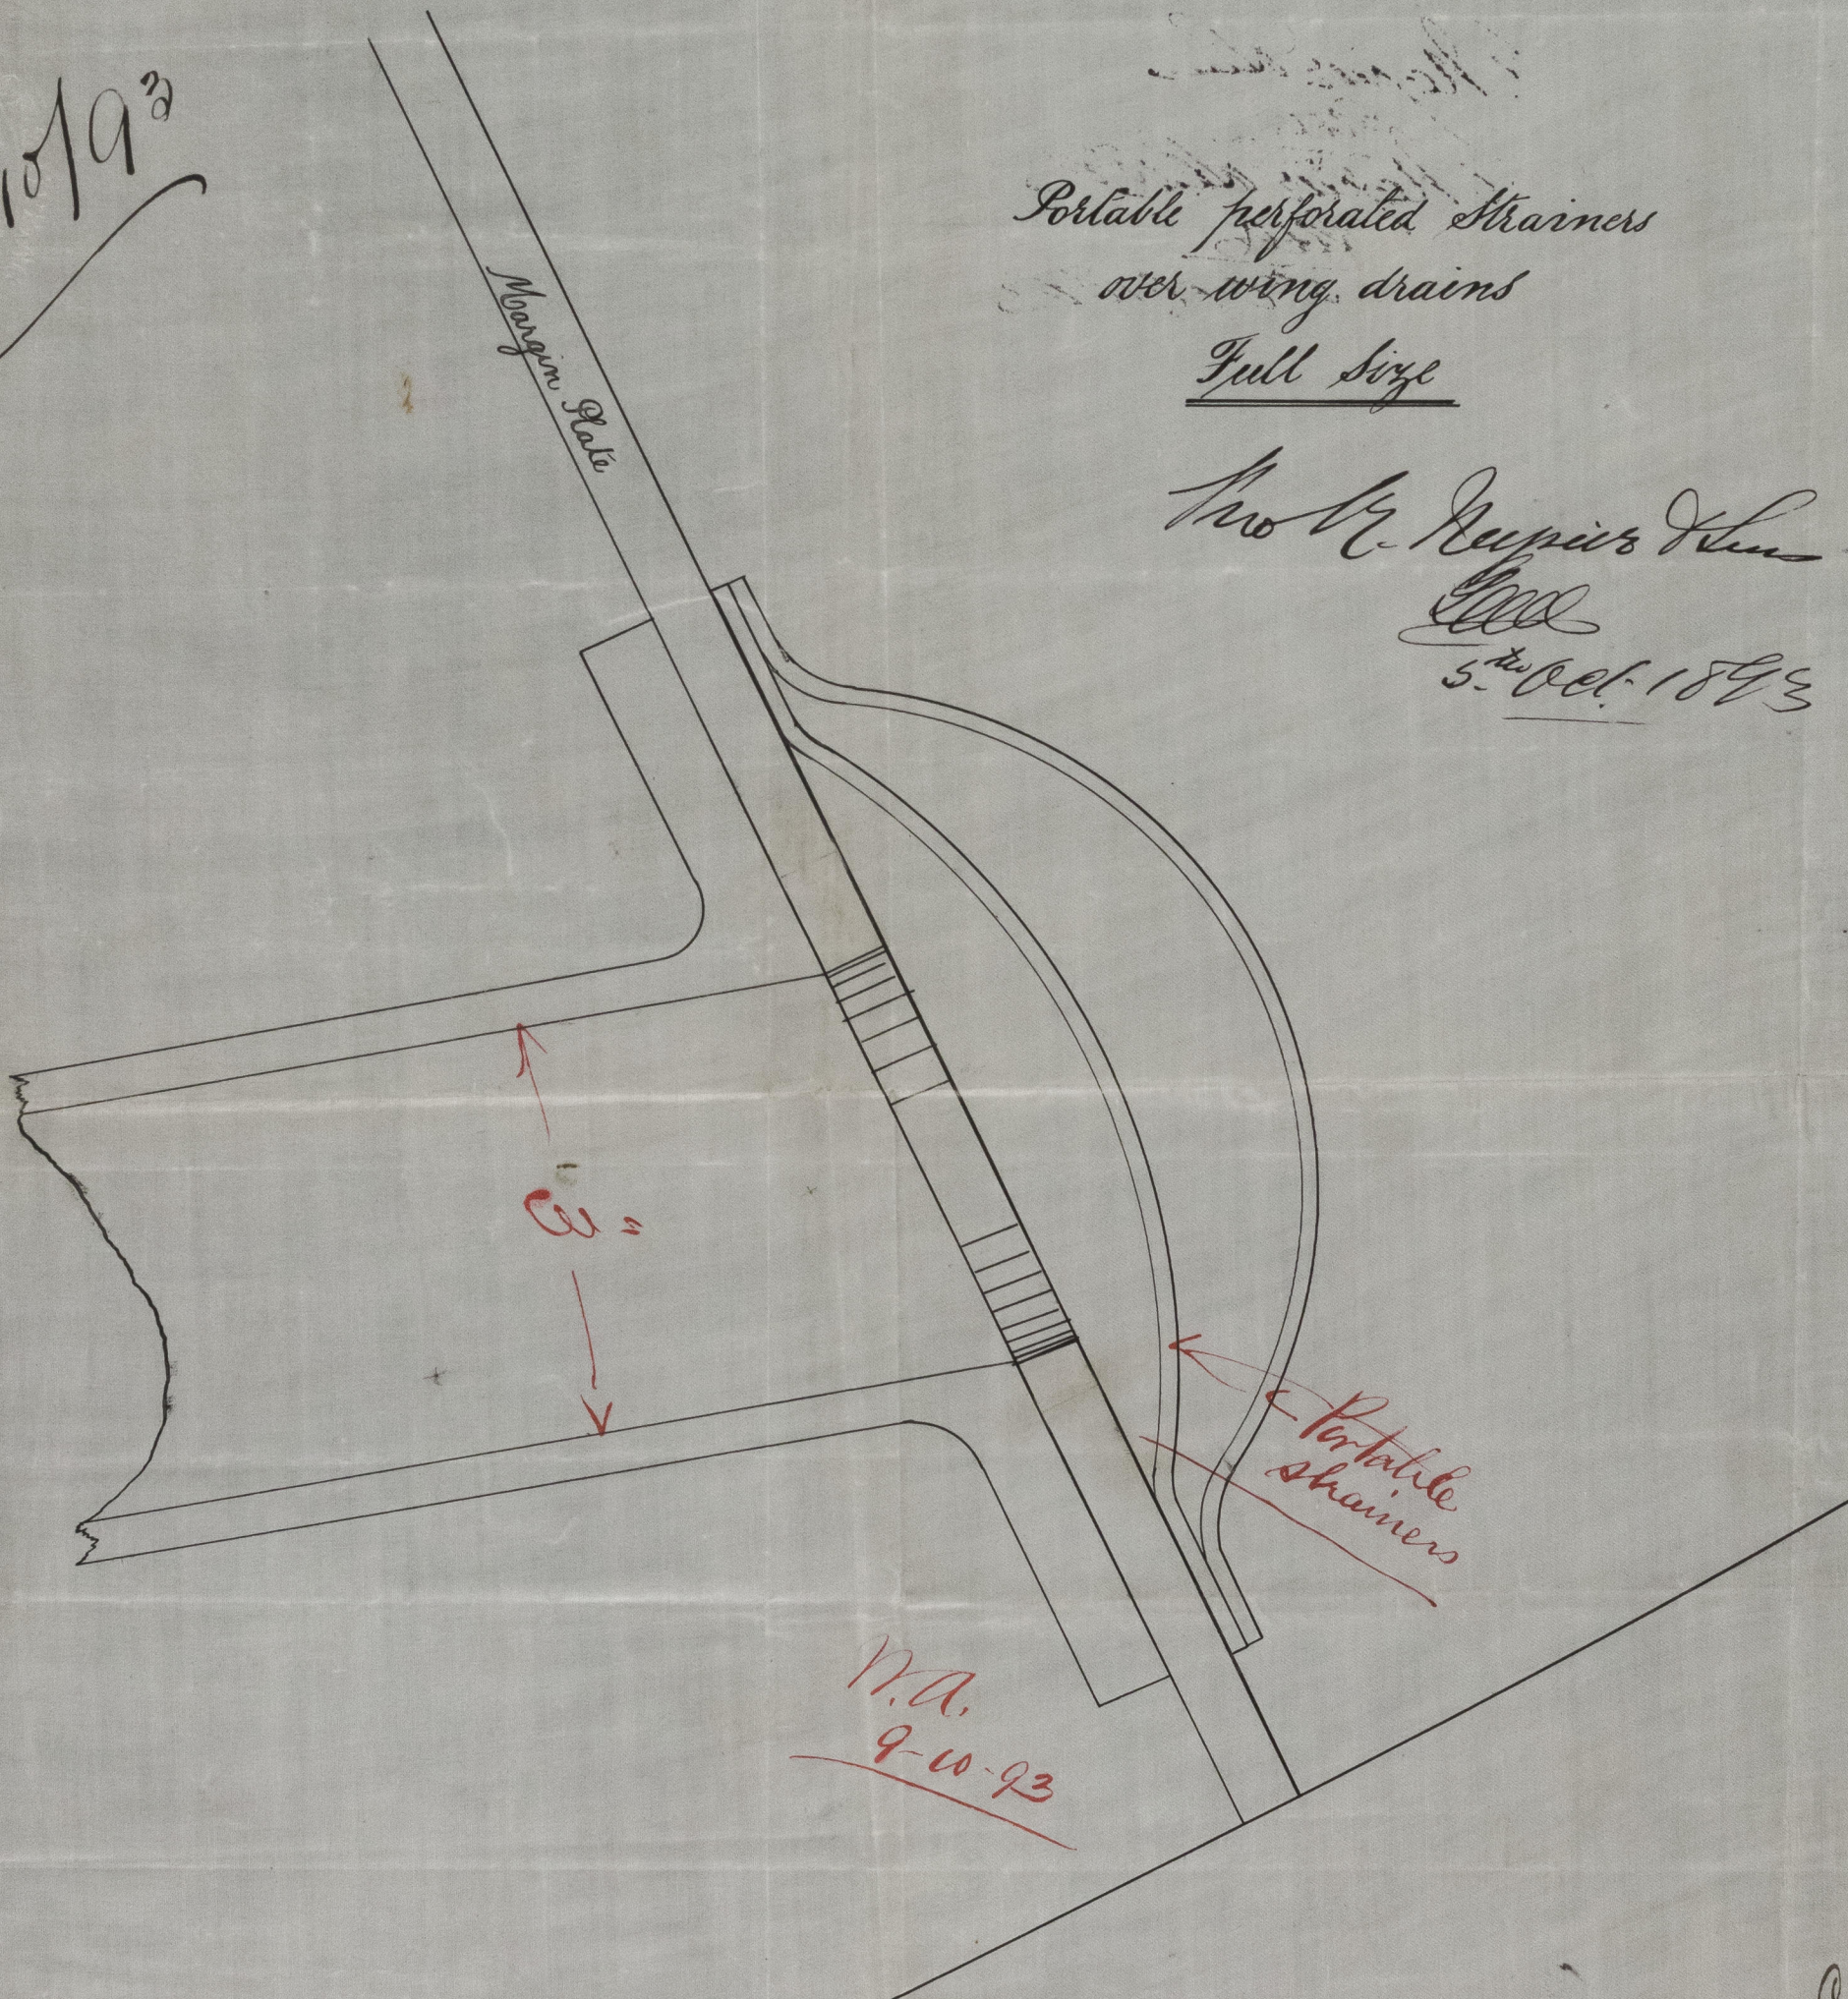

Portable perforated Strainers  
over wing drains  
Full Size





© 2021

Lloyd's Register  
Foundation

GLS239-0019