

Lloyd's Register of British and Foreign Shipping.

(Report on Vessel No. 12445 Port Glasgow
"John Williams.")

No. 4219

SHIP FORGINGS OR CASTINGS.

The words FORGINGS or CASTINGS, IRON or STEEL, should be struck out as may be required.

I have to report that the undermentioned Iron or Steel Forgings or Castings, manufactured by The Dennytown Forge & Co. of Blumbarton for the Vessel No. 437, being built by Messrs. Robt. Napier & Son of Glasgow, have been inspected by me as set forth below, and found to be, so far as can be seen, Sound.

Mark on Forgings.

Lloyd's
No. 4219
F.C

Frank Cook.

Glasgow 20/10/93

STERN FRAME.


RUDDER FRAME.

STEM.

Material* ...
How made ...
Dimensions ...
Progress on Inspection ...
Date when Inspected ...

	STERN FRAME.	RUDDER FRAME.	STEM.
Material*	<u>Scrap Iron</u> <u>Forged</u> <u>5" to 2 3/4"</u> <u>Forged & smithed</u> <u>18.26/9/93.6.10.12.17</u> <u>20/10/93</u>		
How made			
Dimensions			
Progress on Inspection			
Date when Inspected			

SKETCHES OF FRAMES SHOWING POSITION AND DESCRIPTION OF WELDS OF FORGINGS, OR PARTICULARS OF TESTS APPLIED TO CASTINGS.

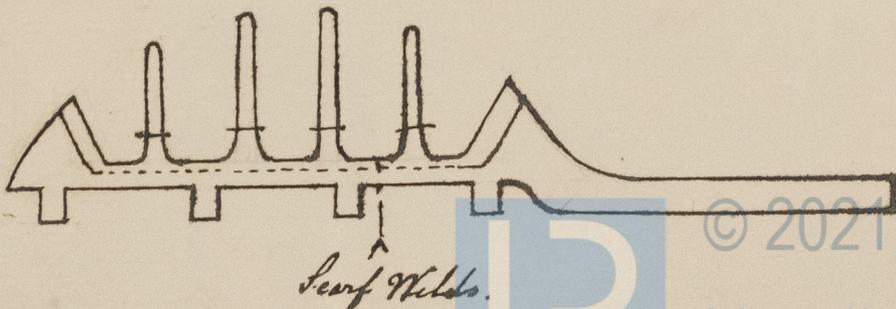

* If of Iron, state whether scrap or puddled Iron.

