

Lloyd's Register of British and Foreign Shipping.

(Report on Vessel No. 12445 Port

Glasgow)

John Williams, —

No. 4219

SHIP FORGINGS ~~OR CASTINGS~~.

I have to report that the undermentioned Iron ~~or Steel~~ Forgings ~~or Castings~~,
manufactured by *The Klenyestown Forge Co.*

of *Kumbarton.*

for the Vessel No. 487, being built

by *Messrs. Robt. Napier & Sons.* of *Glasgow.*

have been inspected by me as set forth below, and found to be, so far as can be seen,
Sound.

Mark on Forgings.

Lloyd's

No. 4219


F.C.

Frank Cook.

Glasgow 5/9/93

	STERN FRAME.	RUDDER FRAME.	STEM.
Material* ...	<i>Scrap Iron</i>	/	<i>Scrap Iron</i>
How made ...	<i>Forged.</i>		<i>Forged</i>
Dimensions ...	<i>7 x 4 1/4</i>		<i>7 x 2 1/2</i>
Progress on Inspection	<i>Forged & Smithed</i>		<i>Forged & Smithed</i>
Date when Inspected	<i>4.16.18.22.29/8/93.1.</i> <i>5/9/93</i>		<i>2-12/8/93</i>

SKETCHES OF FRAMES SHOWING POSITION AND DESCRIPTION OF WELDS OF FORGINGS, OR PARTICULARS OF
TESTS APPLIED TO CASTINGS.

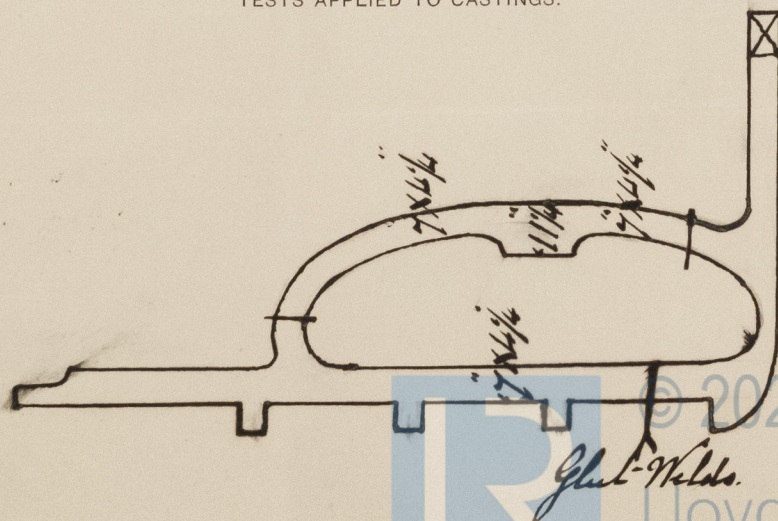

* If of Iron, state whether scrap or puddled Iron.