


12. 7. 93.

 8th July 1893

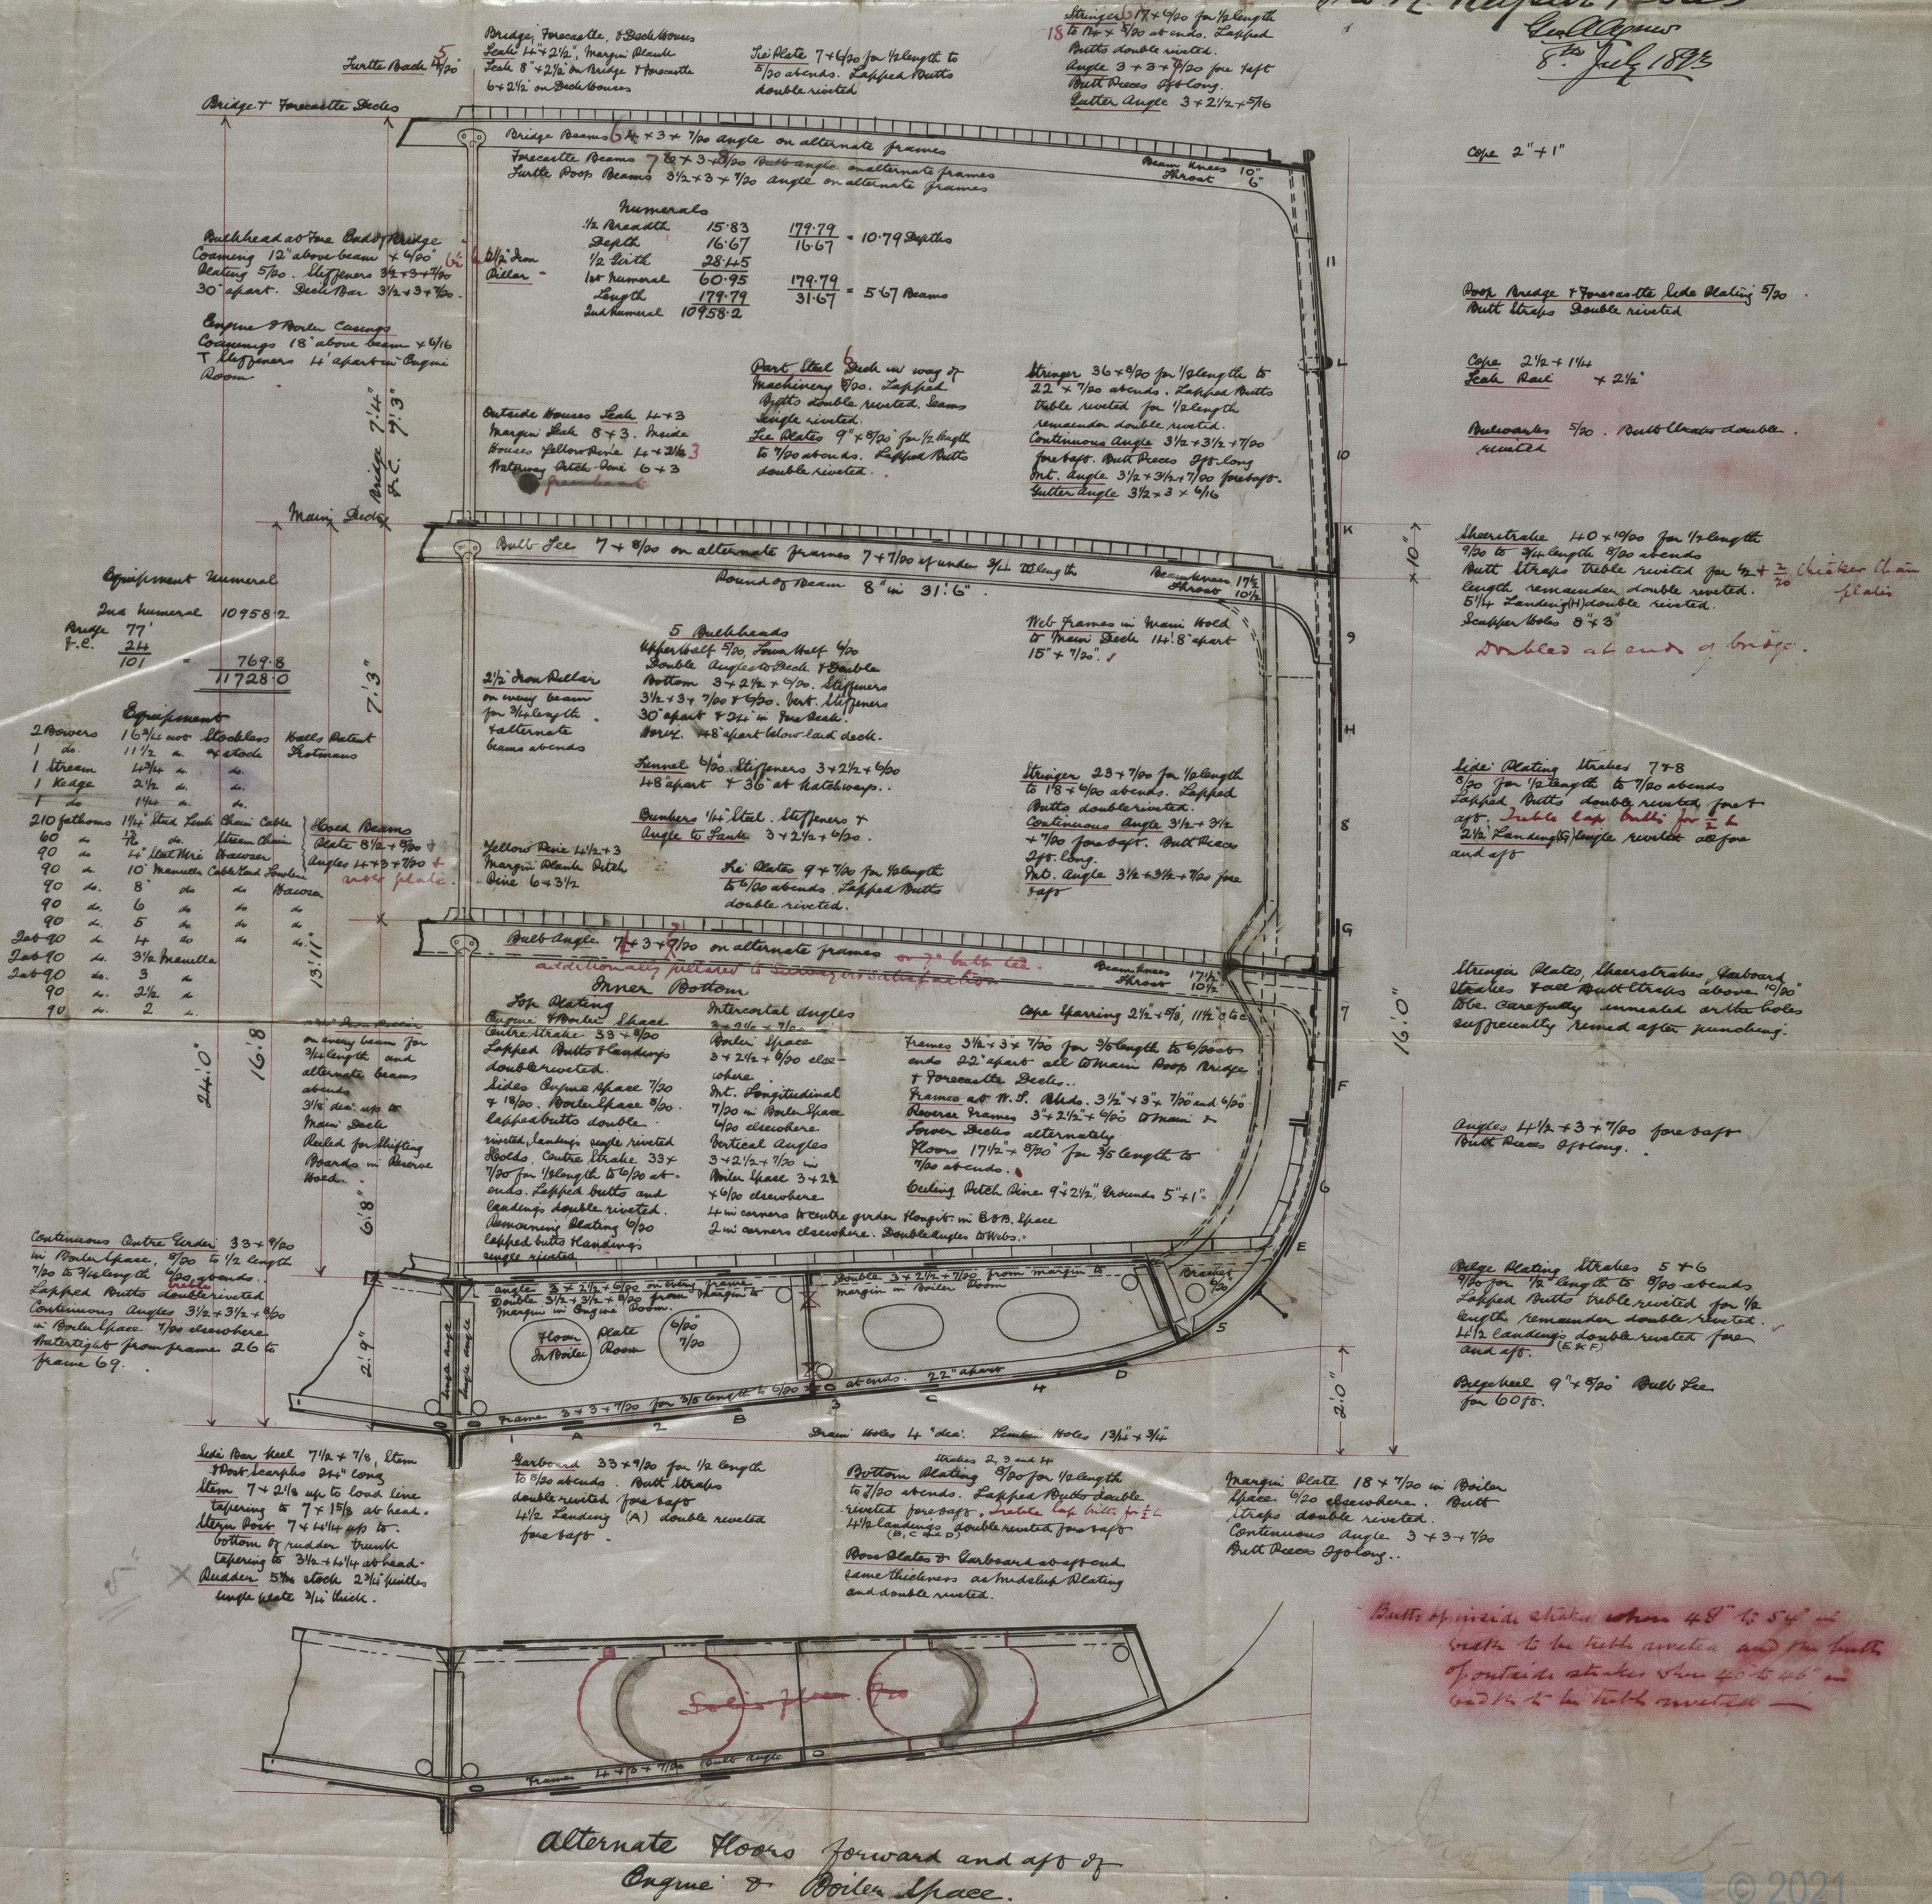

S. S. John Williams "Glasgow Report" No. ¹²⁴⁴⁵ ~~122~~

GLS239-0026



© 2021

Lloyd's Register
Foundation