


See
Arr 9:2:94


AMENDED ARRANGEMENT, S.S. NO. 15.



5/2/94.

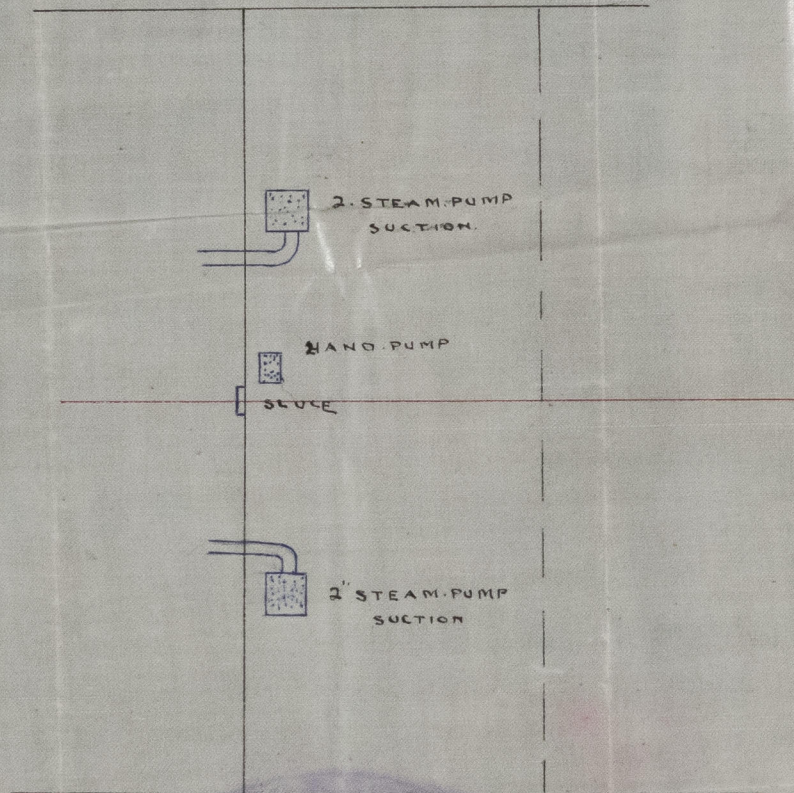

Additional hand
pump forward
J.M.
5/2/94.
Lloyd's Register
Foundation

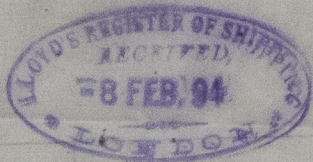






© 2021

Lloyd's Register
Foundation

GL5240-0058.1