


24. 31. 1. 94

PLAN OF PUMPING ARRANGEMENT

S. S. No 15.

14/1/94

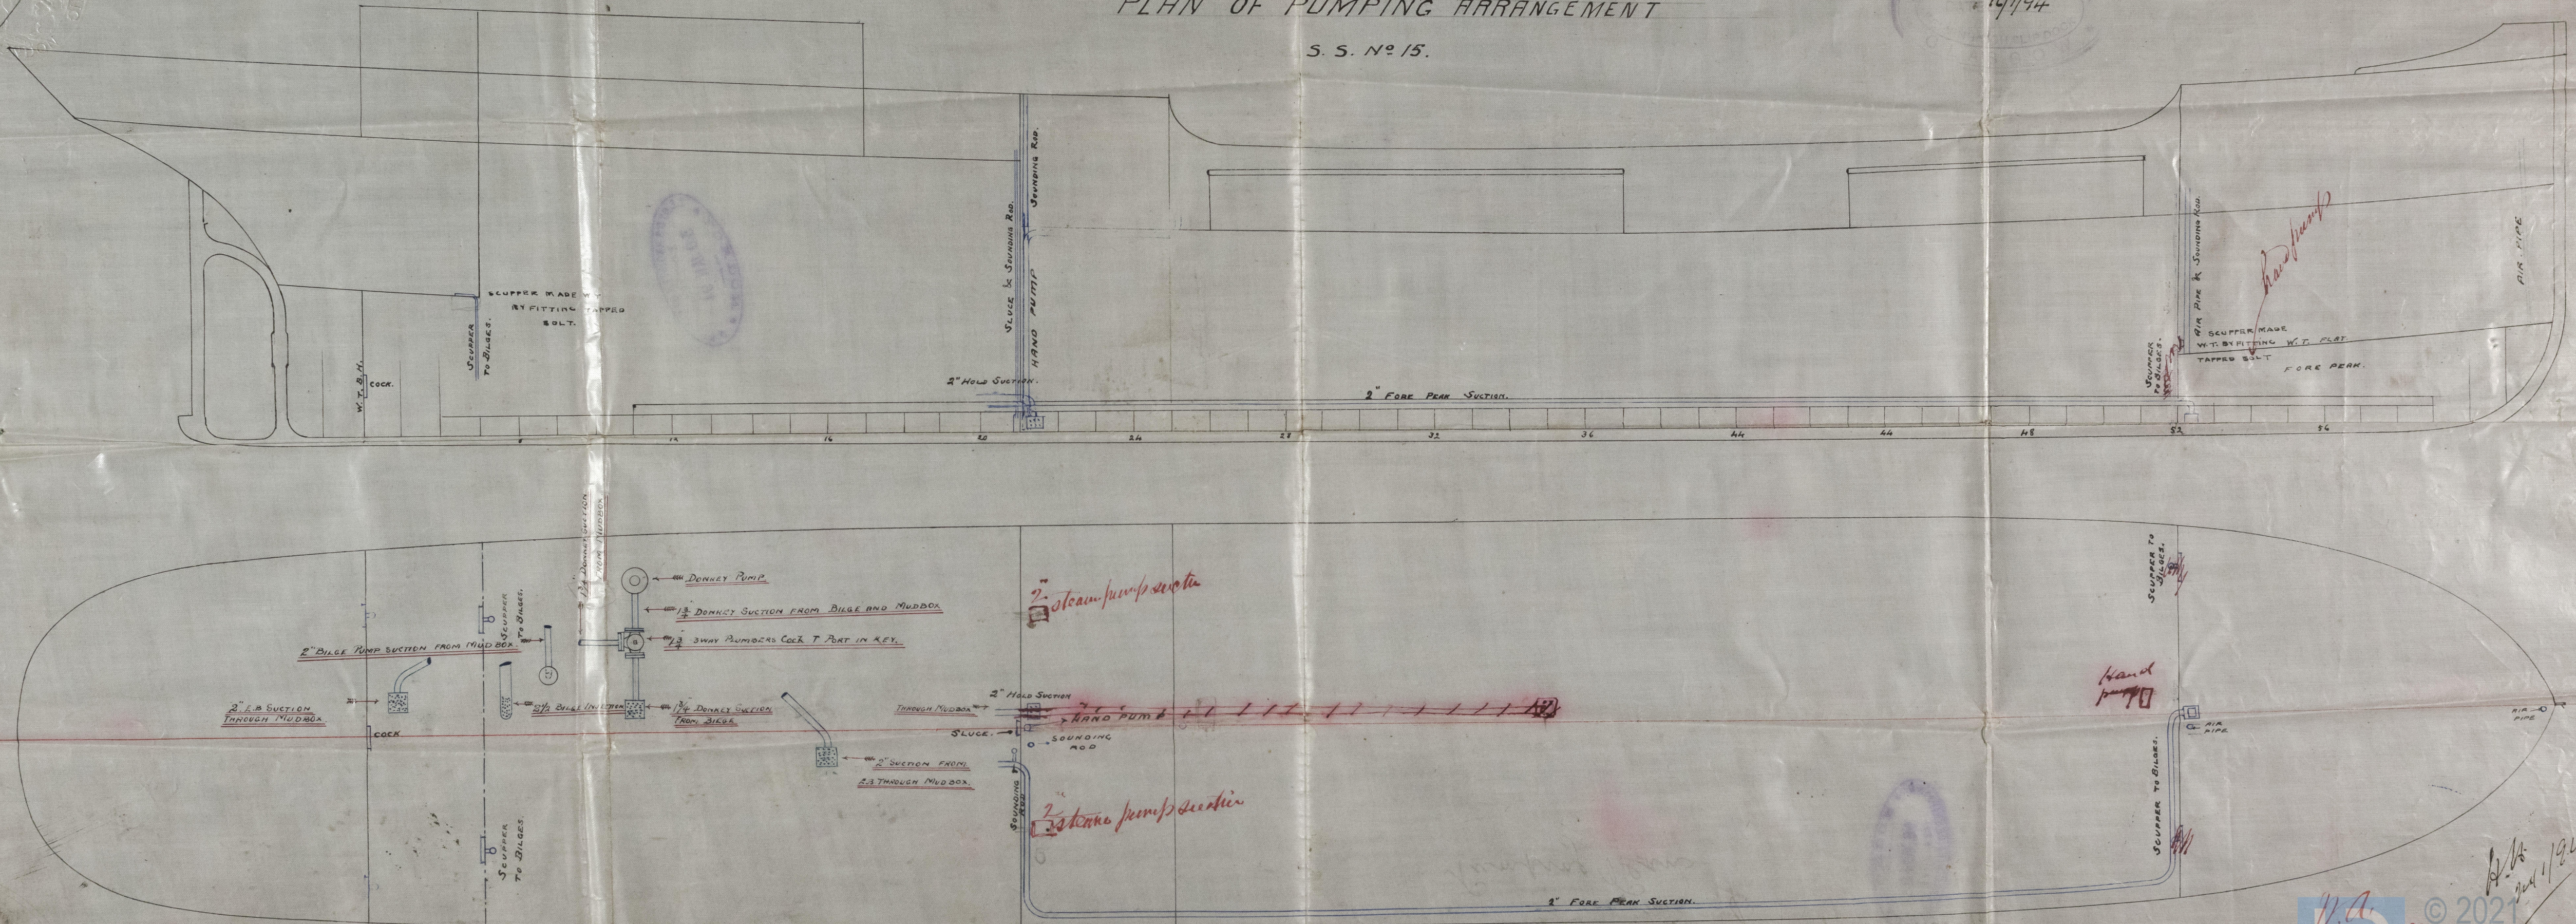

S.S. "Shanes Castle" Glasgow Report No. 12887.
Pumping Plan

