
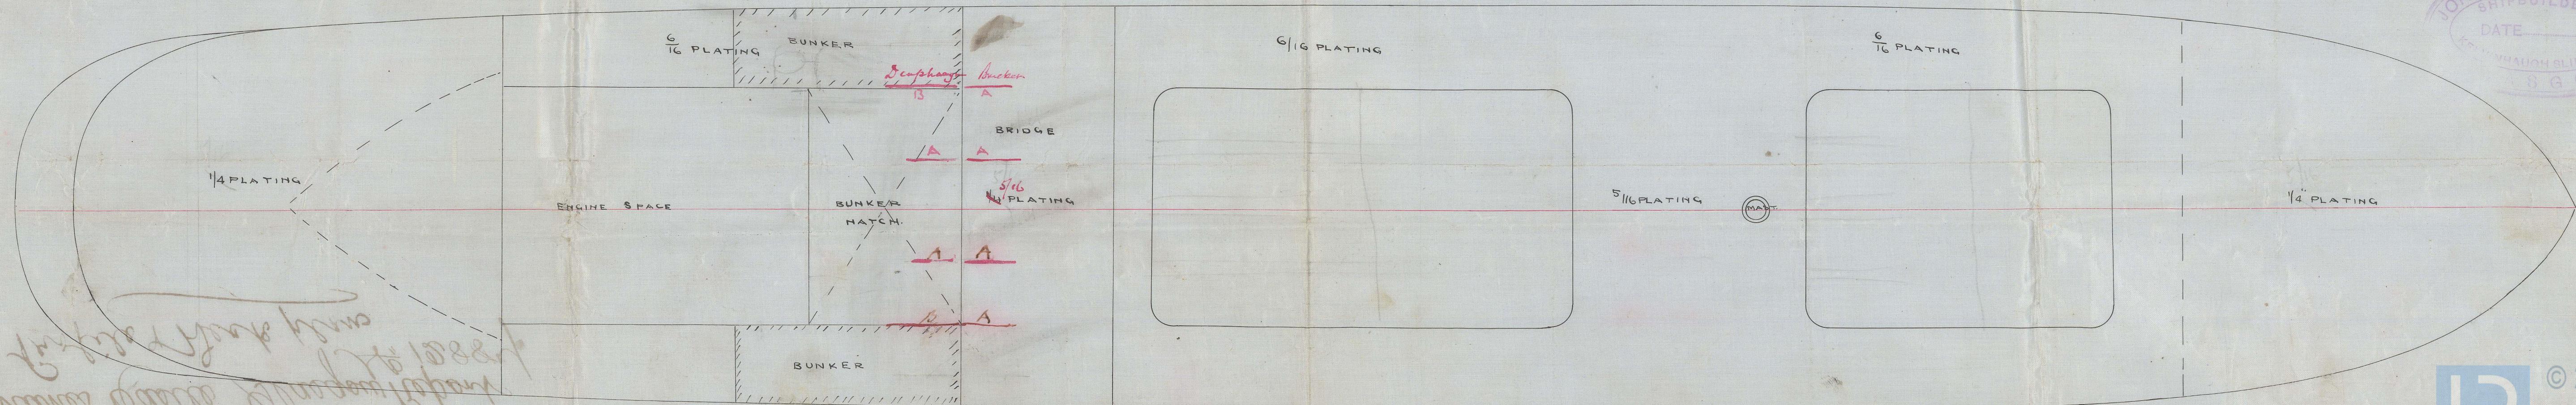


23.10.93.

(Amended Profile)

PROFILE & DECK PLAN S.S. NO 15

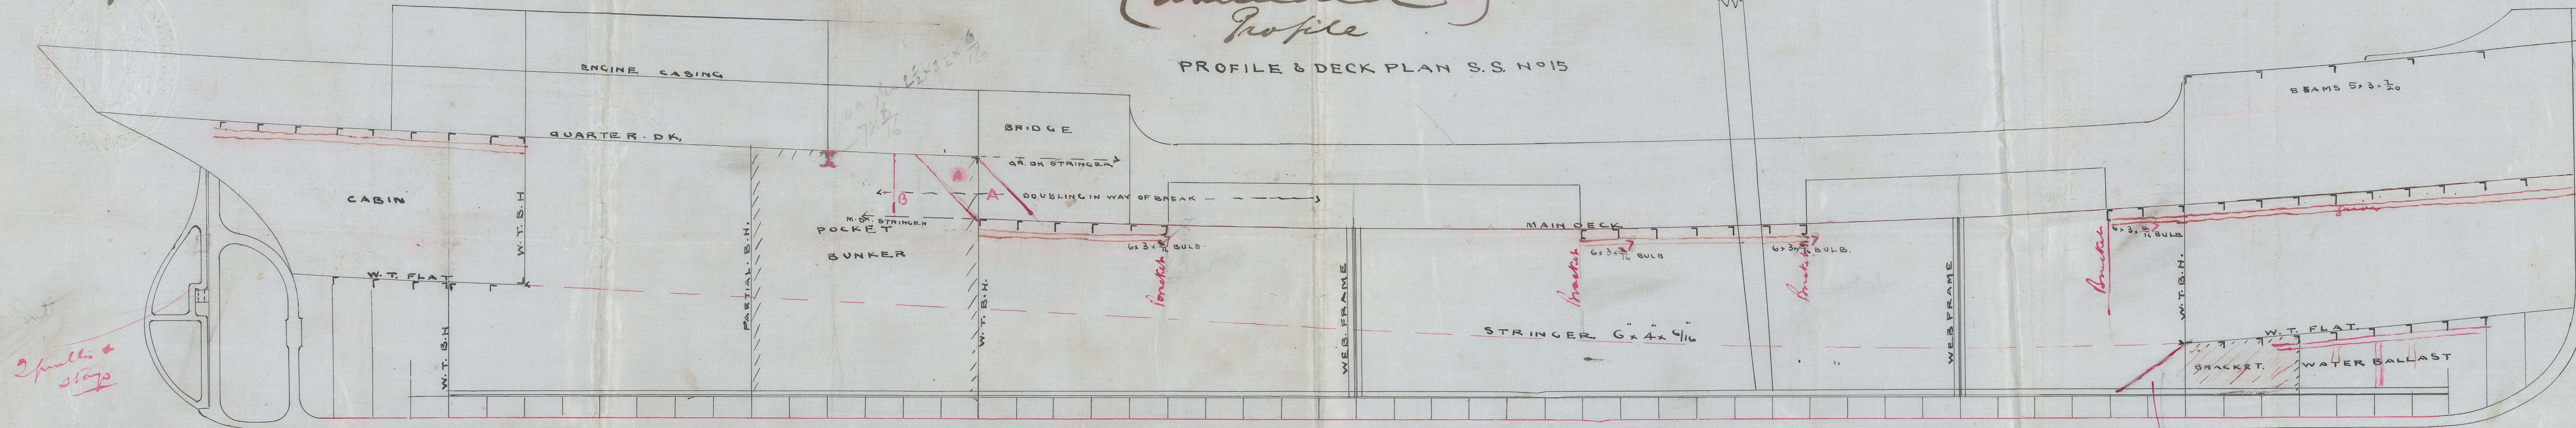

JOHN SHEARER & SON
SHIPBUILDERS
DATE
1890



© 2021
Lloyd's Register
Foundation

S.S. "Shanes Castle" Glasgow Report
Profile & Deck plan No 12884

6500-04240-0059



© 2021

Lloyd's Register
Foundation