

Lloyd's Register of British and Foreign Shipping.

(Report on Vessel No. 12931 Port Glasgow
"Maurn.")No. 4380 SHIP FORGINGS ~~OR CASTINGS~~.

I have to report that the undermentioned Iron ~~or Steel~~ Forgings ~~or Castings~~,
 manufactured by The Irvine Forge Coy
 of Irvine for the Vessel No. 118, being built
 by Messrs John Fullerton & Co of Paisley
 have been inspected by me as set forth below, and found to be, so far as can be seen,
Sound & efficient

Mark on Forgings.


Lloyd's

No. 4380
W.H.

William Hamilton
Glasgow
12/1/94

	STERN FRAME.	RUDDER FRAME.	STEM.
Material*	Scrap iron		
How made	Forged		
Dimensions	6 x 2½		
Progress on Inspection	Forging & smithing		
Date when Inspected	12.29/11/93. 4. 19 25.27.29/12/93. 5/1/94		

SKETCHES OF FRAMES SHOWING POSITION AND DESCRIPTION OF WELDS OF FORGINGS, OR PARTICULARS OF
 TESTS APPLIED TO CASTINGS.

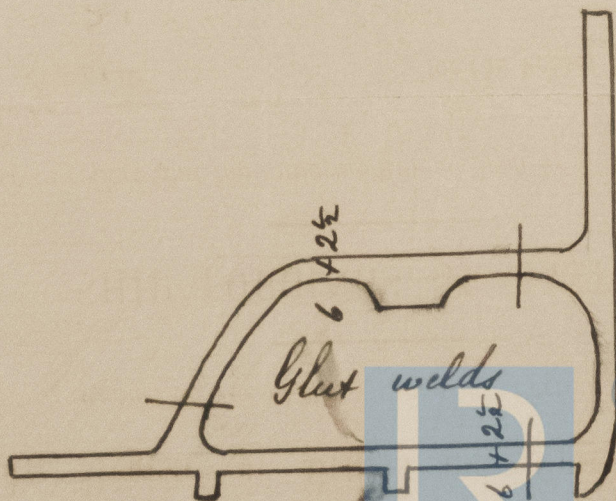

* If of Iron, state whether scrap or puddled Iron.