

Lloyd's Survey

Shell Riveting Scale 3-1 Foot.

Outer Rivet Straps $\frac{1}{4}$ " thick inner straps $\frac{3}{16}$ "


All holes drilled in place

Shell Rivets $\frac{1}{2}$ " dia. finished. Shell plates $\frac{1}{4}$ " thick

Working Press 100 lbs

Tested to 200 lbs

Give Lams all Lugs finished
Shell rivets $\frac{1}{4}$ " dia finished

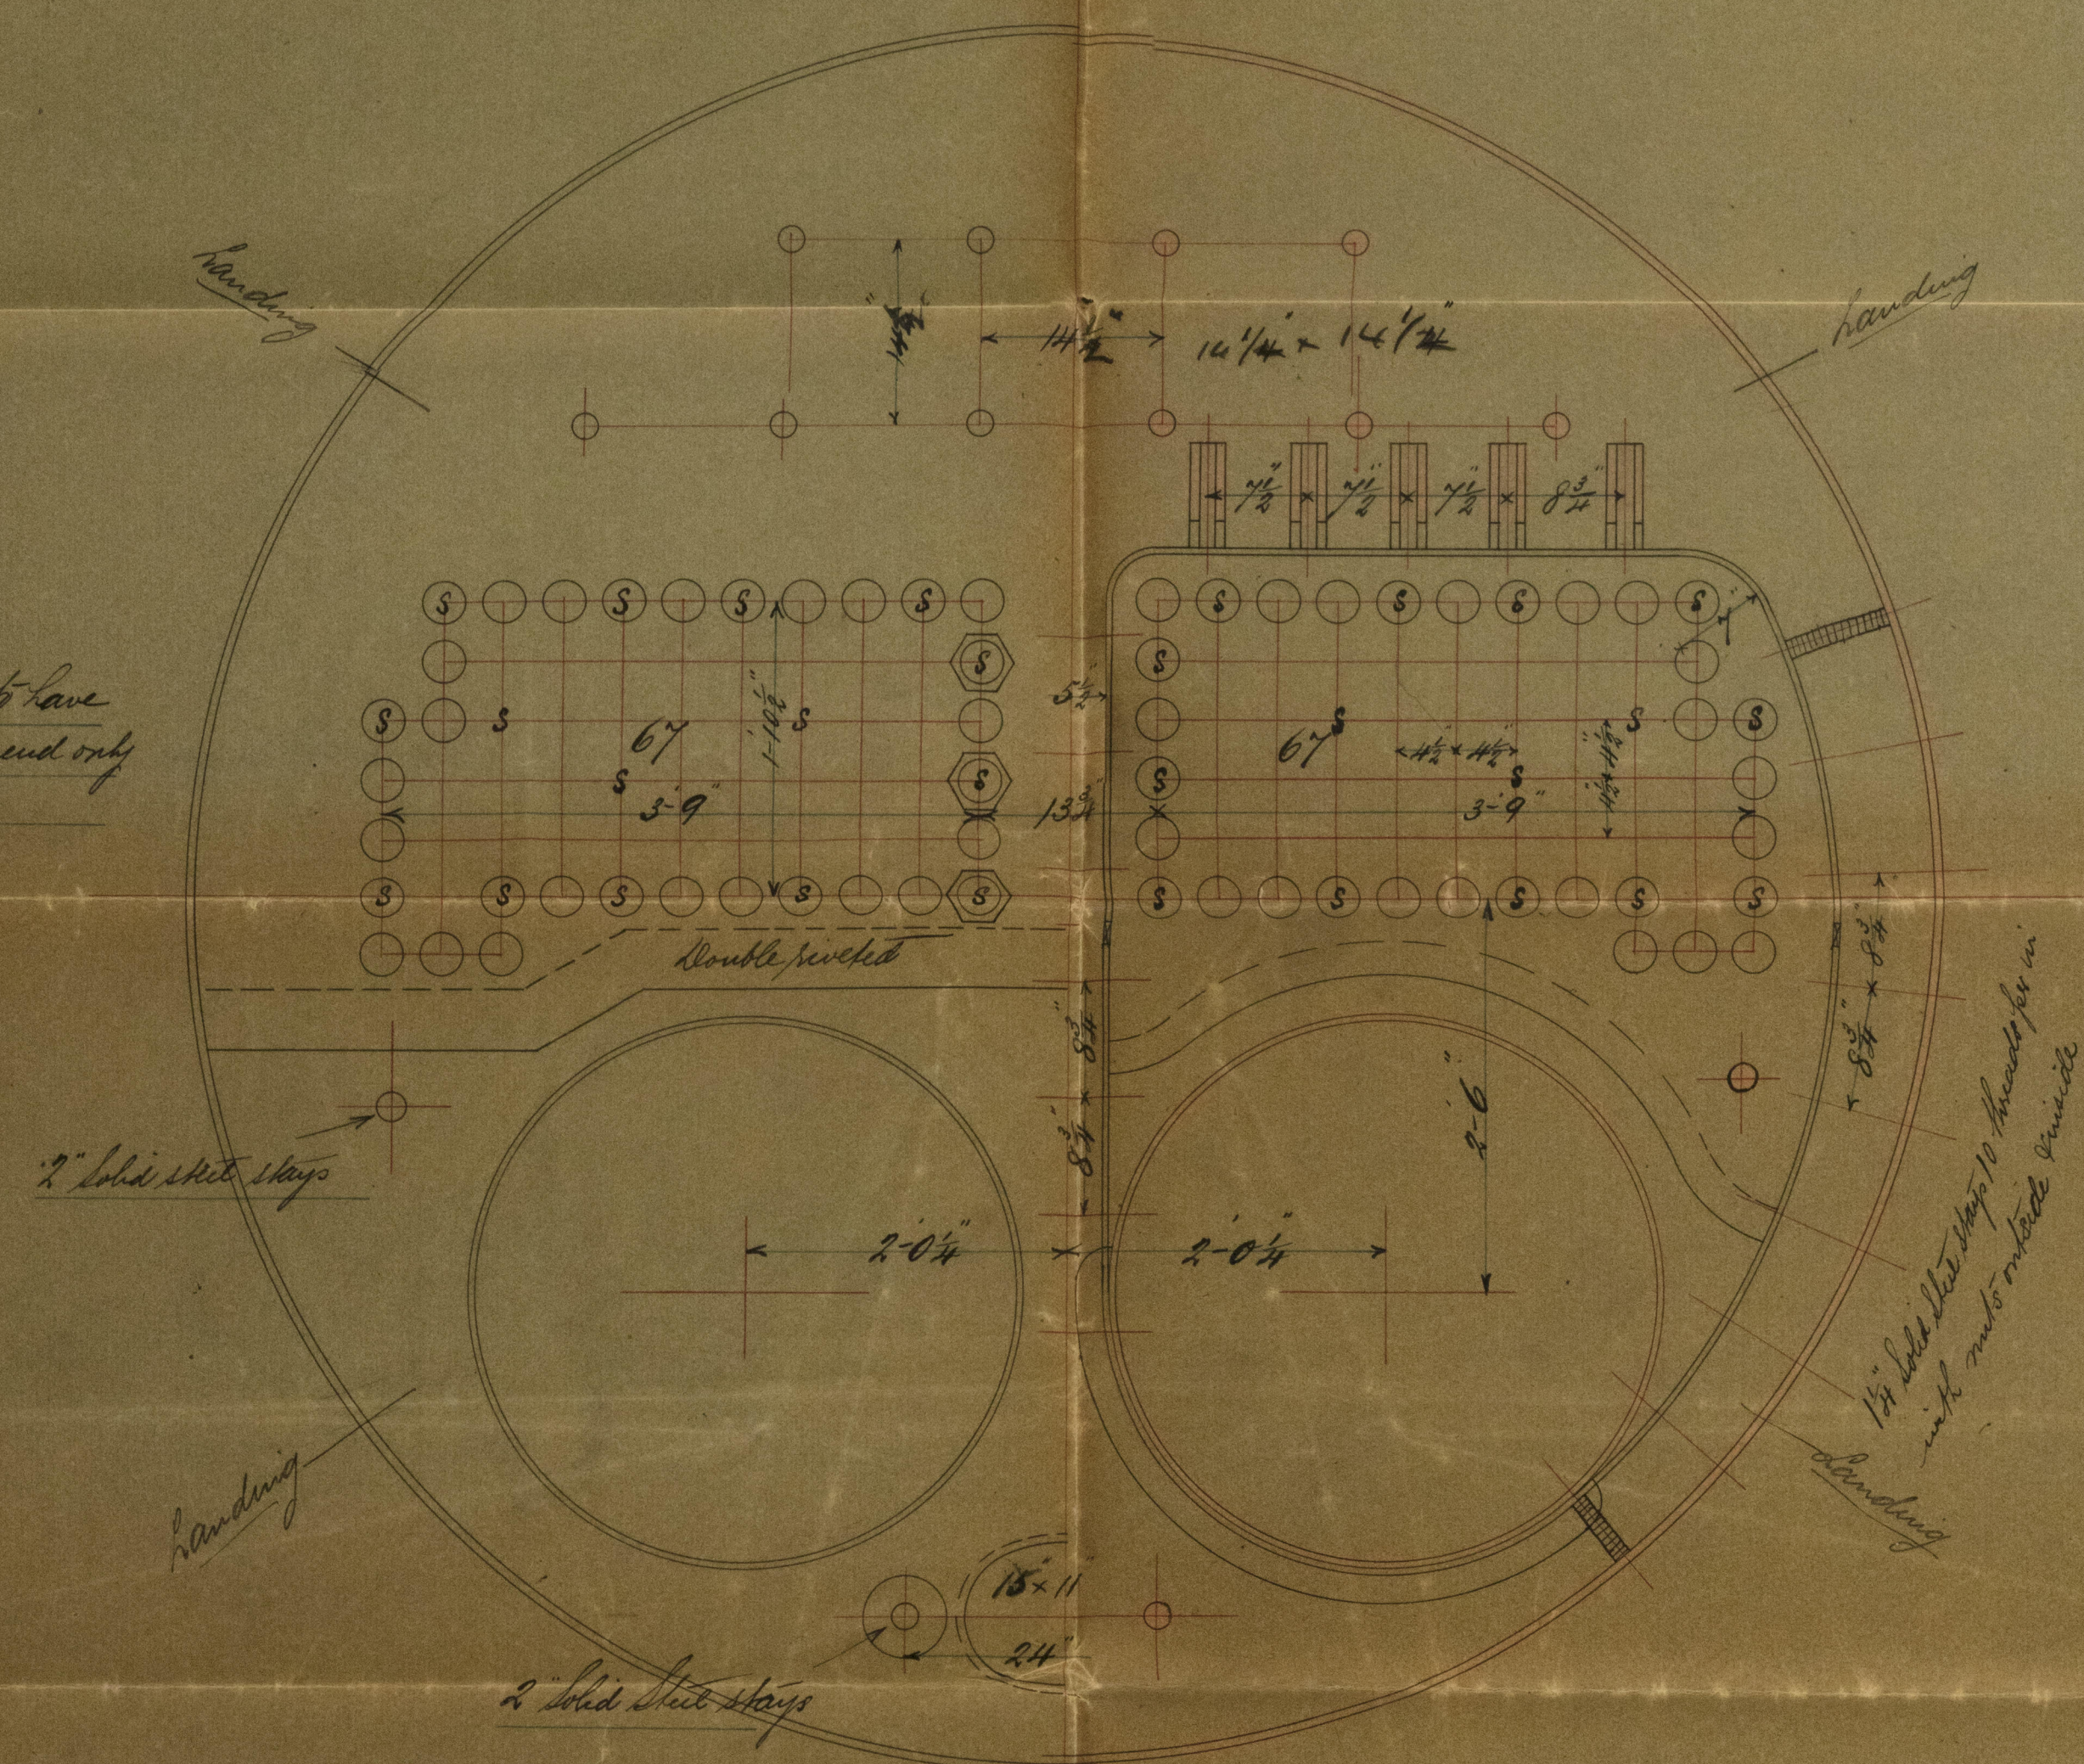


6 Stay Tubes to have
nuts on front end only
as shown

14 Solid Shell Stays 10 threads per in.
with nuts outside outside

Mild Steel throughout.
Lugs of Hot Iron

Boiler & Machinery Engineering Co. Ltd.
182, 184, 186,1000

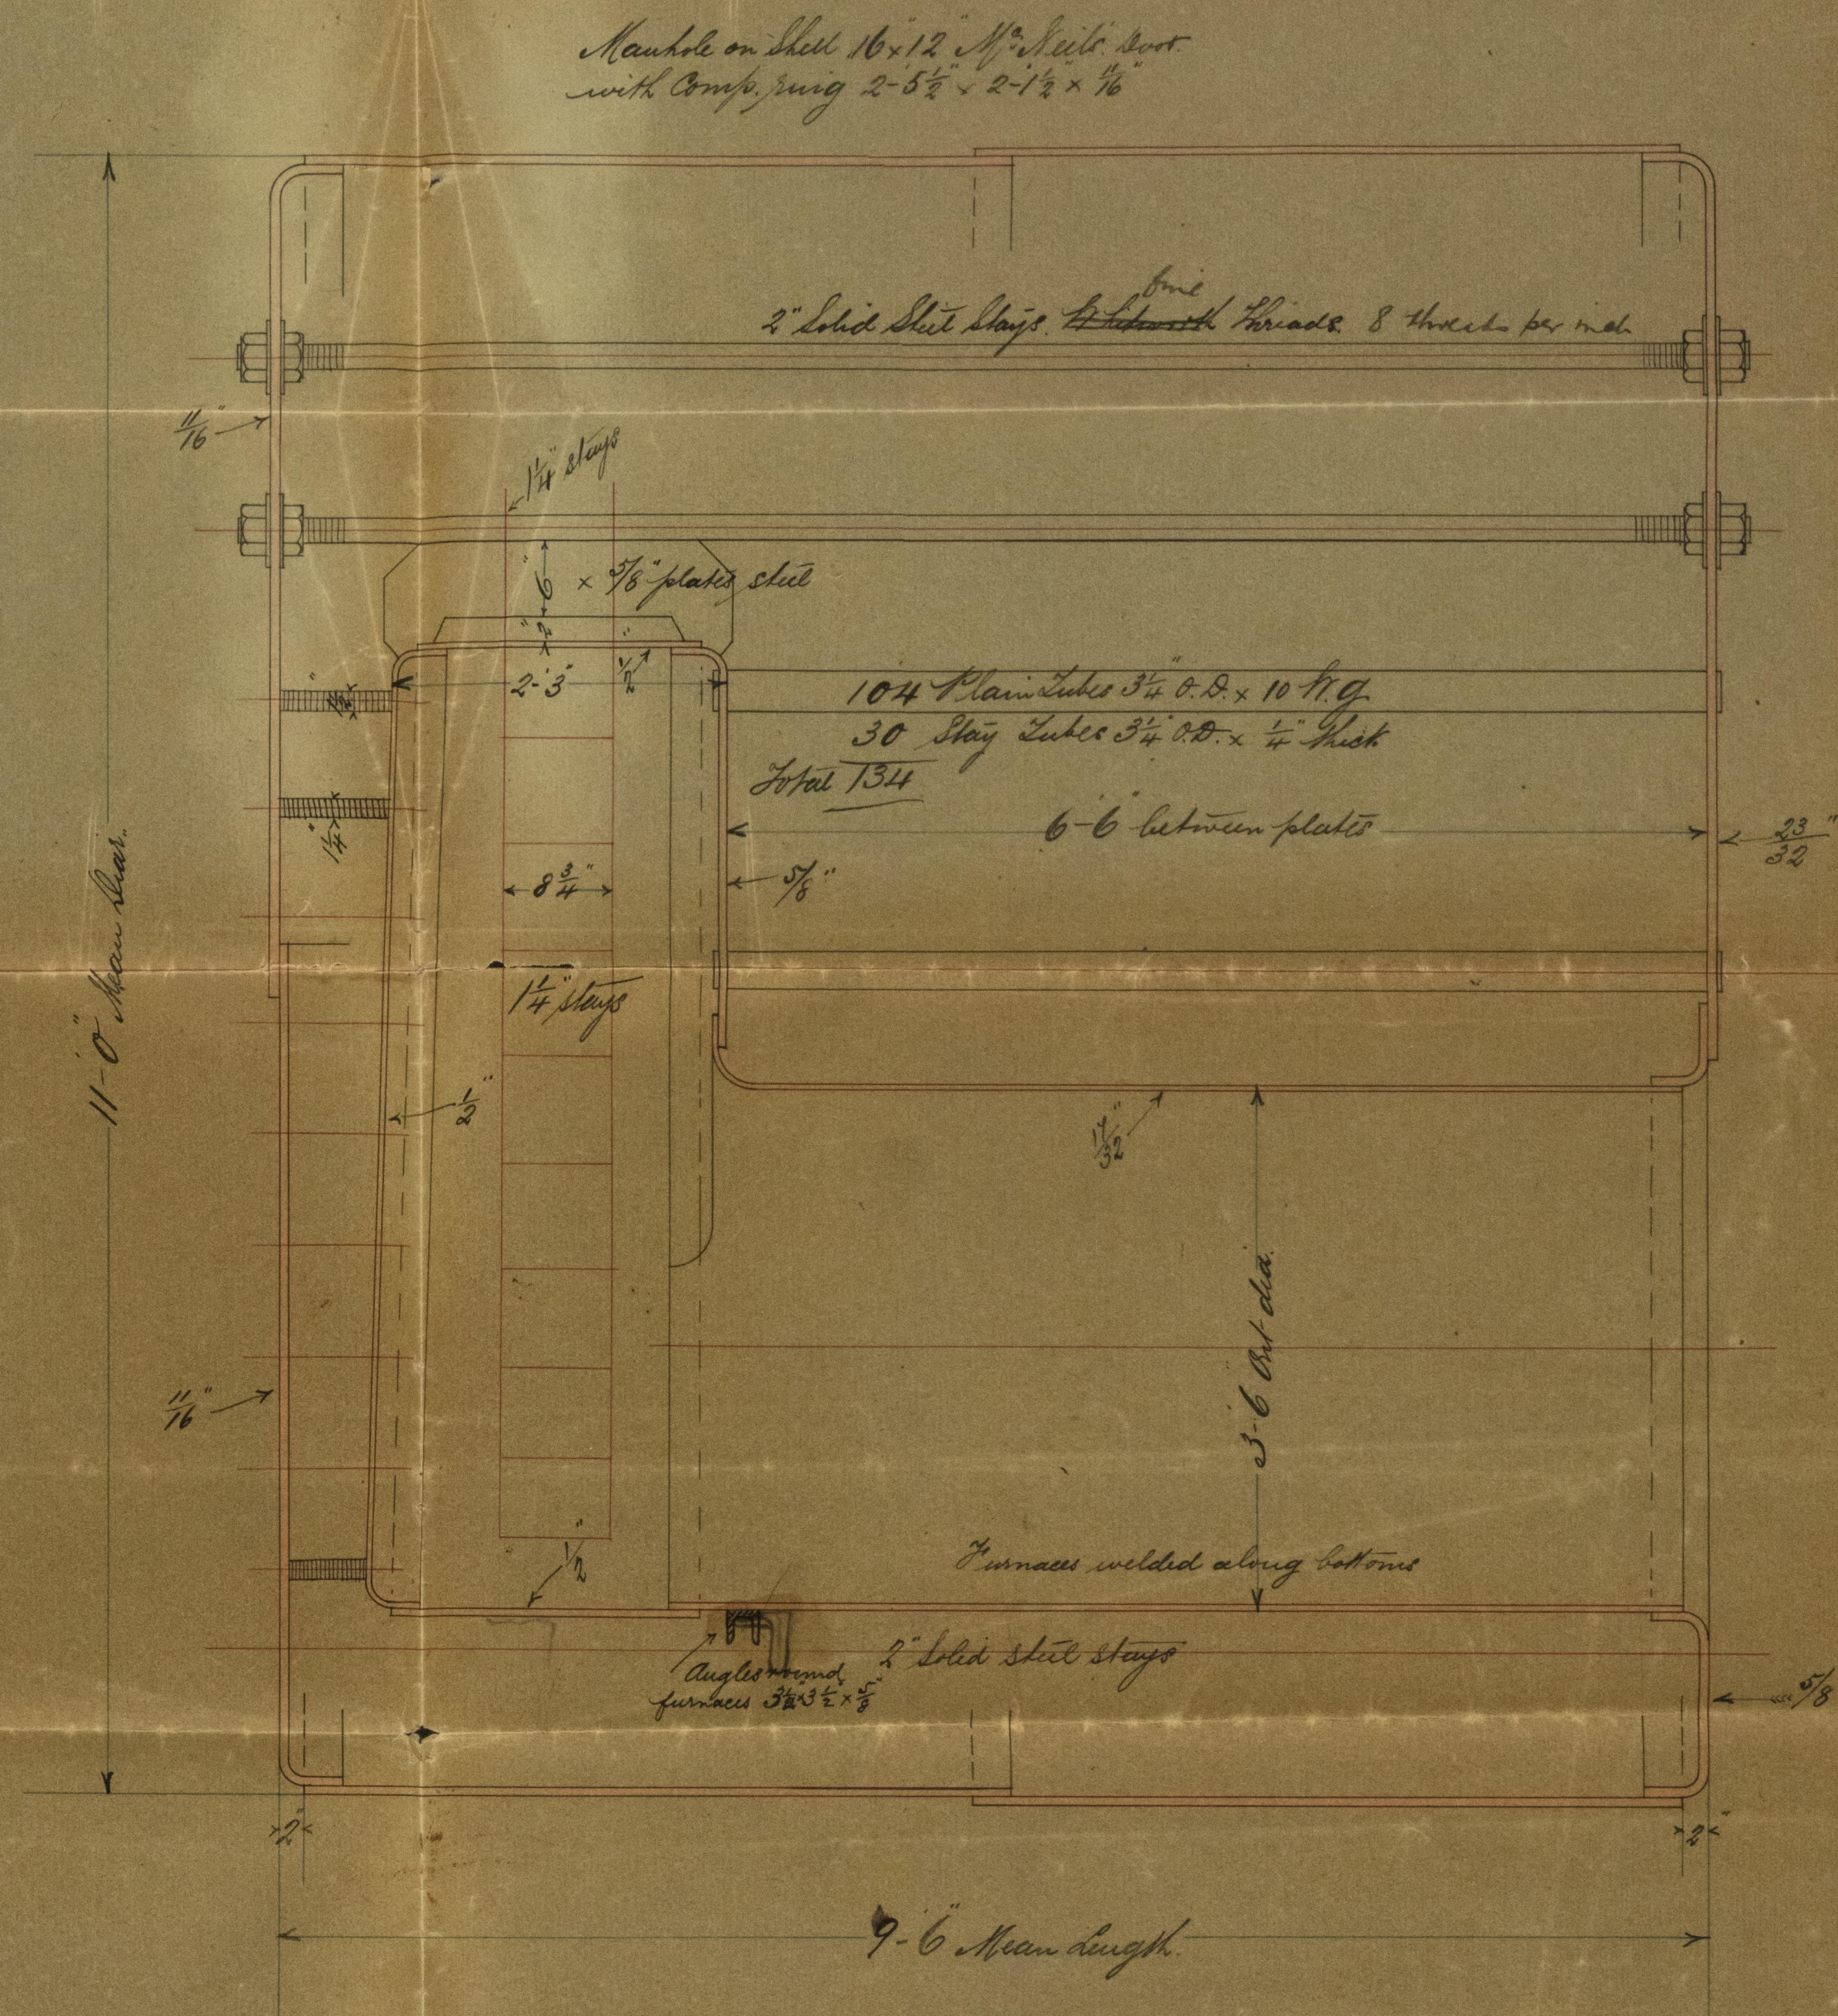




104 Plain Tubes 3/4" O.D. x 10 ft. G.


6-6 between plates

14 Stays

3/8" dia

3/8" dia

5, 7, 9,1001

Boiler No. 743

Scale 1" = 1 Foot.

To Lloyd's for 100 lbs W.P.

11'-0" dia x 9'-6" long



Lloyd's Register
of Shipping

GLS240-0124

Bailer

S. S. "Mourne" Glasgow Report No. 12931.-



© 2021

Lloyd's Register
Foundation