

Lloyd's Register of British and Foreign Shipping.

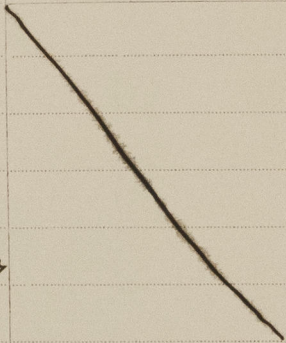
(Report on Vessel No. 12948 Port Glasgow)"Envoy"No. 2043

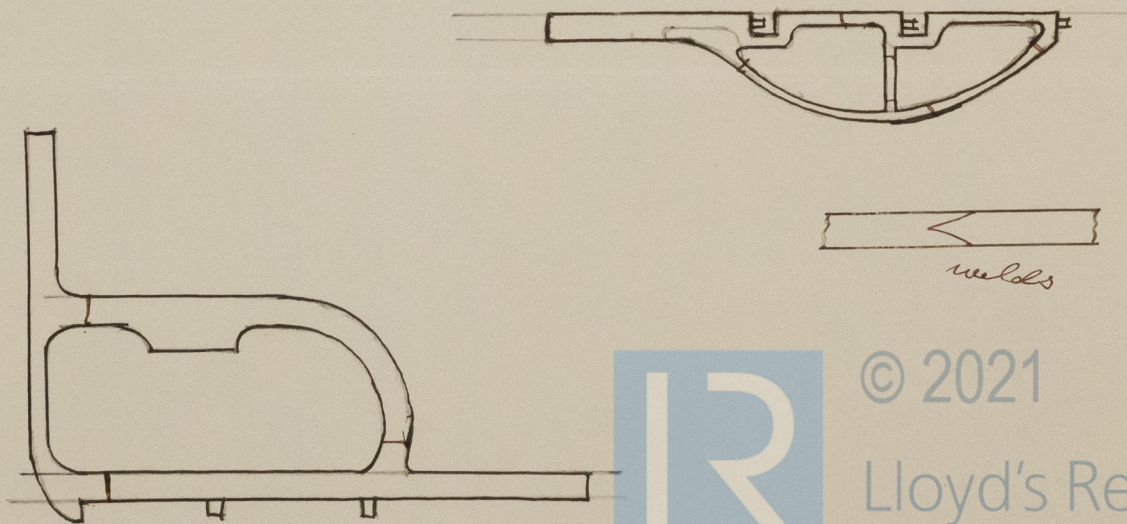
SHIP FORGINGS OR CASTINGS.

I have to report that the undermentioned Iron ~~or Steel~~ Forgings ~~or Castings~~,
 manufactured by Messrs Emmerson Walker & Thompson
 of Dunston for the Vessel No. 86, being built
 by Messrs Mackie & Thompson of Glasgow
 have been inspected by me as set forth below, and found to be, so far as can be seen,
Sound

Mark on Forgings.

 Lloyd's
 No. 3237B
86
John C Craig
Newcastle

	STERN FRAME.	RUDDER FRAME.	STEM.
Material* ...	<u>Scrap Iron</u>	<u>Scrap Iron</u>	
How made ...	<u>Forged</u>	<u>Forged</u>	
Dimensions ...	<u>6 1/2 - 2 1/2</u>	<u>3 1/2 - 2 1/4</u>	
Progress on Inspection	<u>Forged & Smithed</u>	<u>Forged & Smithed</u>	
Date when Inspected	<u>January 10-23 February 6-13/94</u>	<u>March 16 April 10-17 26/94</u>	

 SKETCHES OF FRAMES SHOWING POSITION AND DESCRIPTION OF WELDS OF FORGINGS, OR PARTICULARS OF
 TESTS APPLIED TO CASTINGS.


* If of Iron, state whether scrap or puddled Iron.