
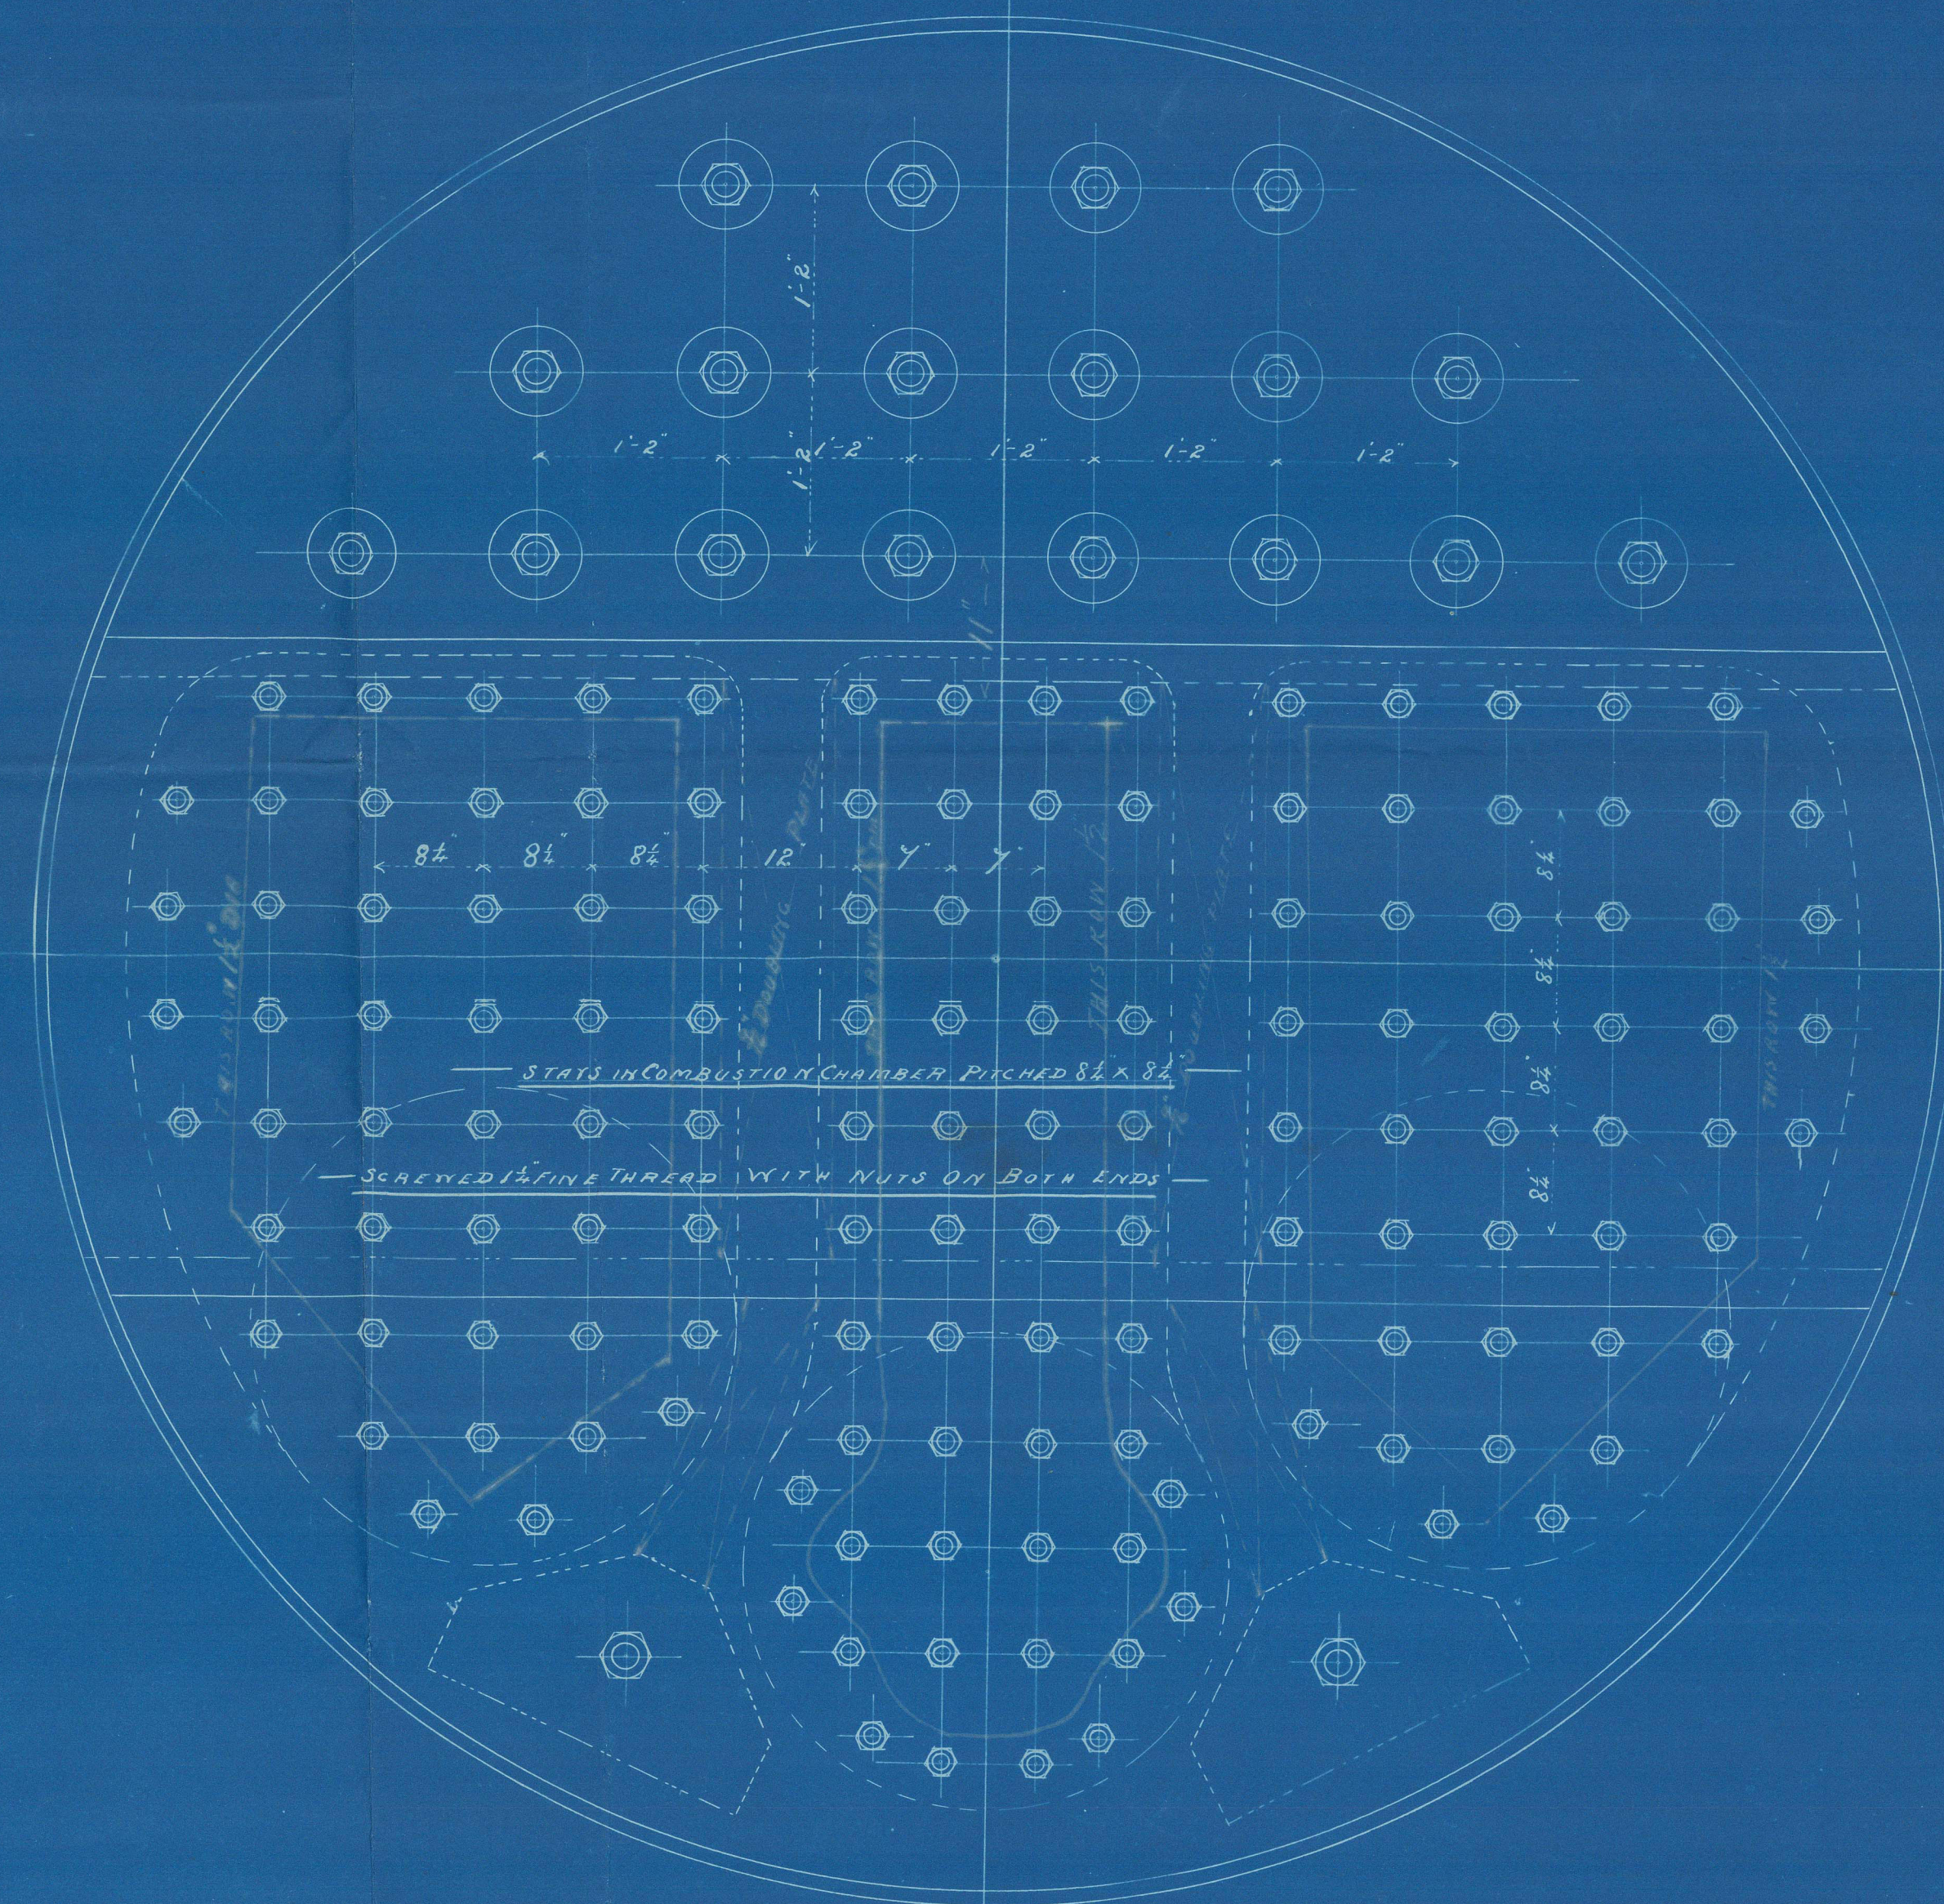
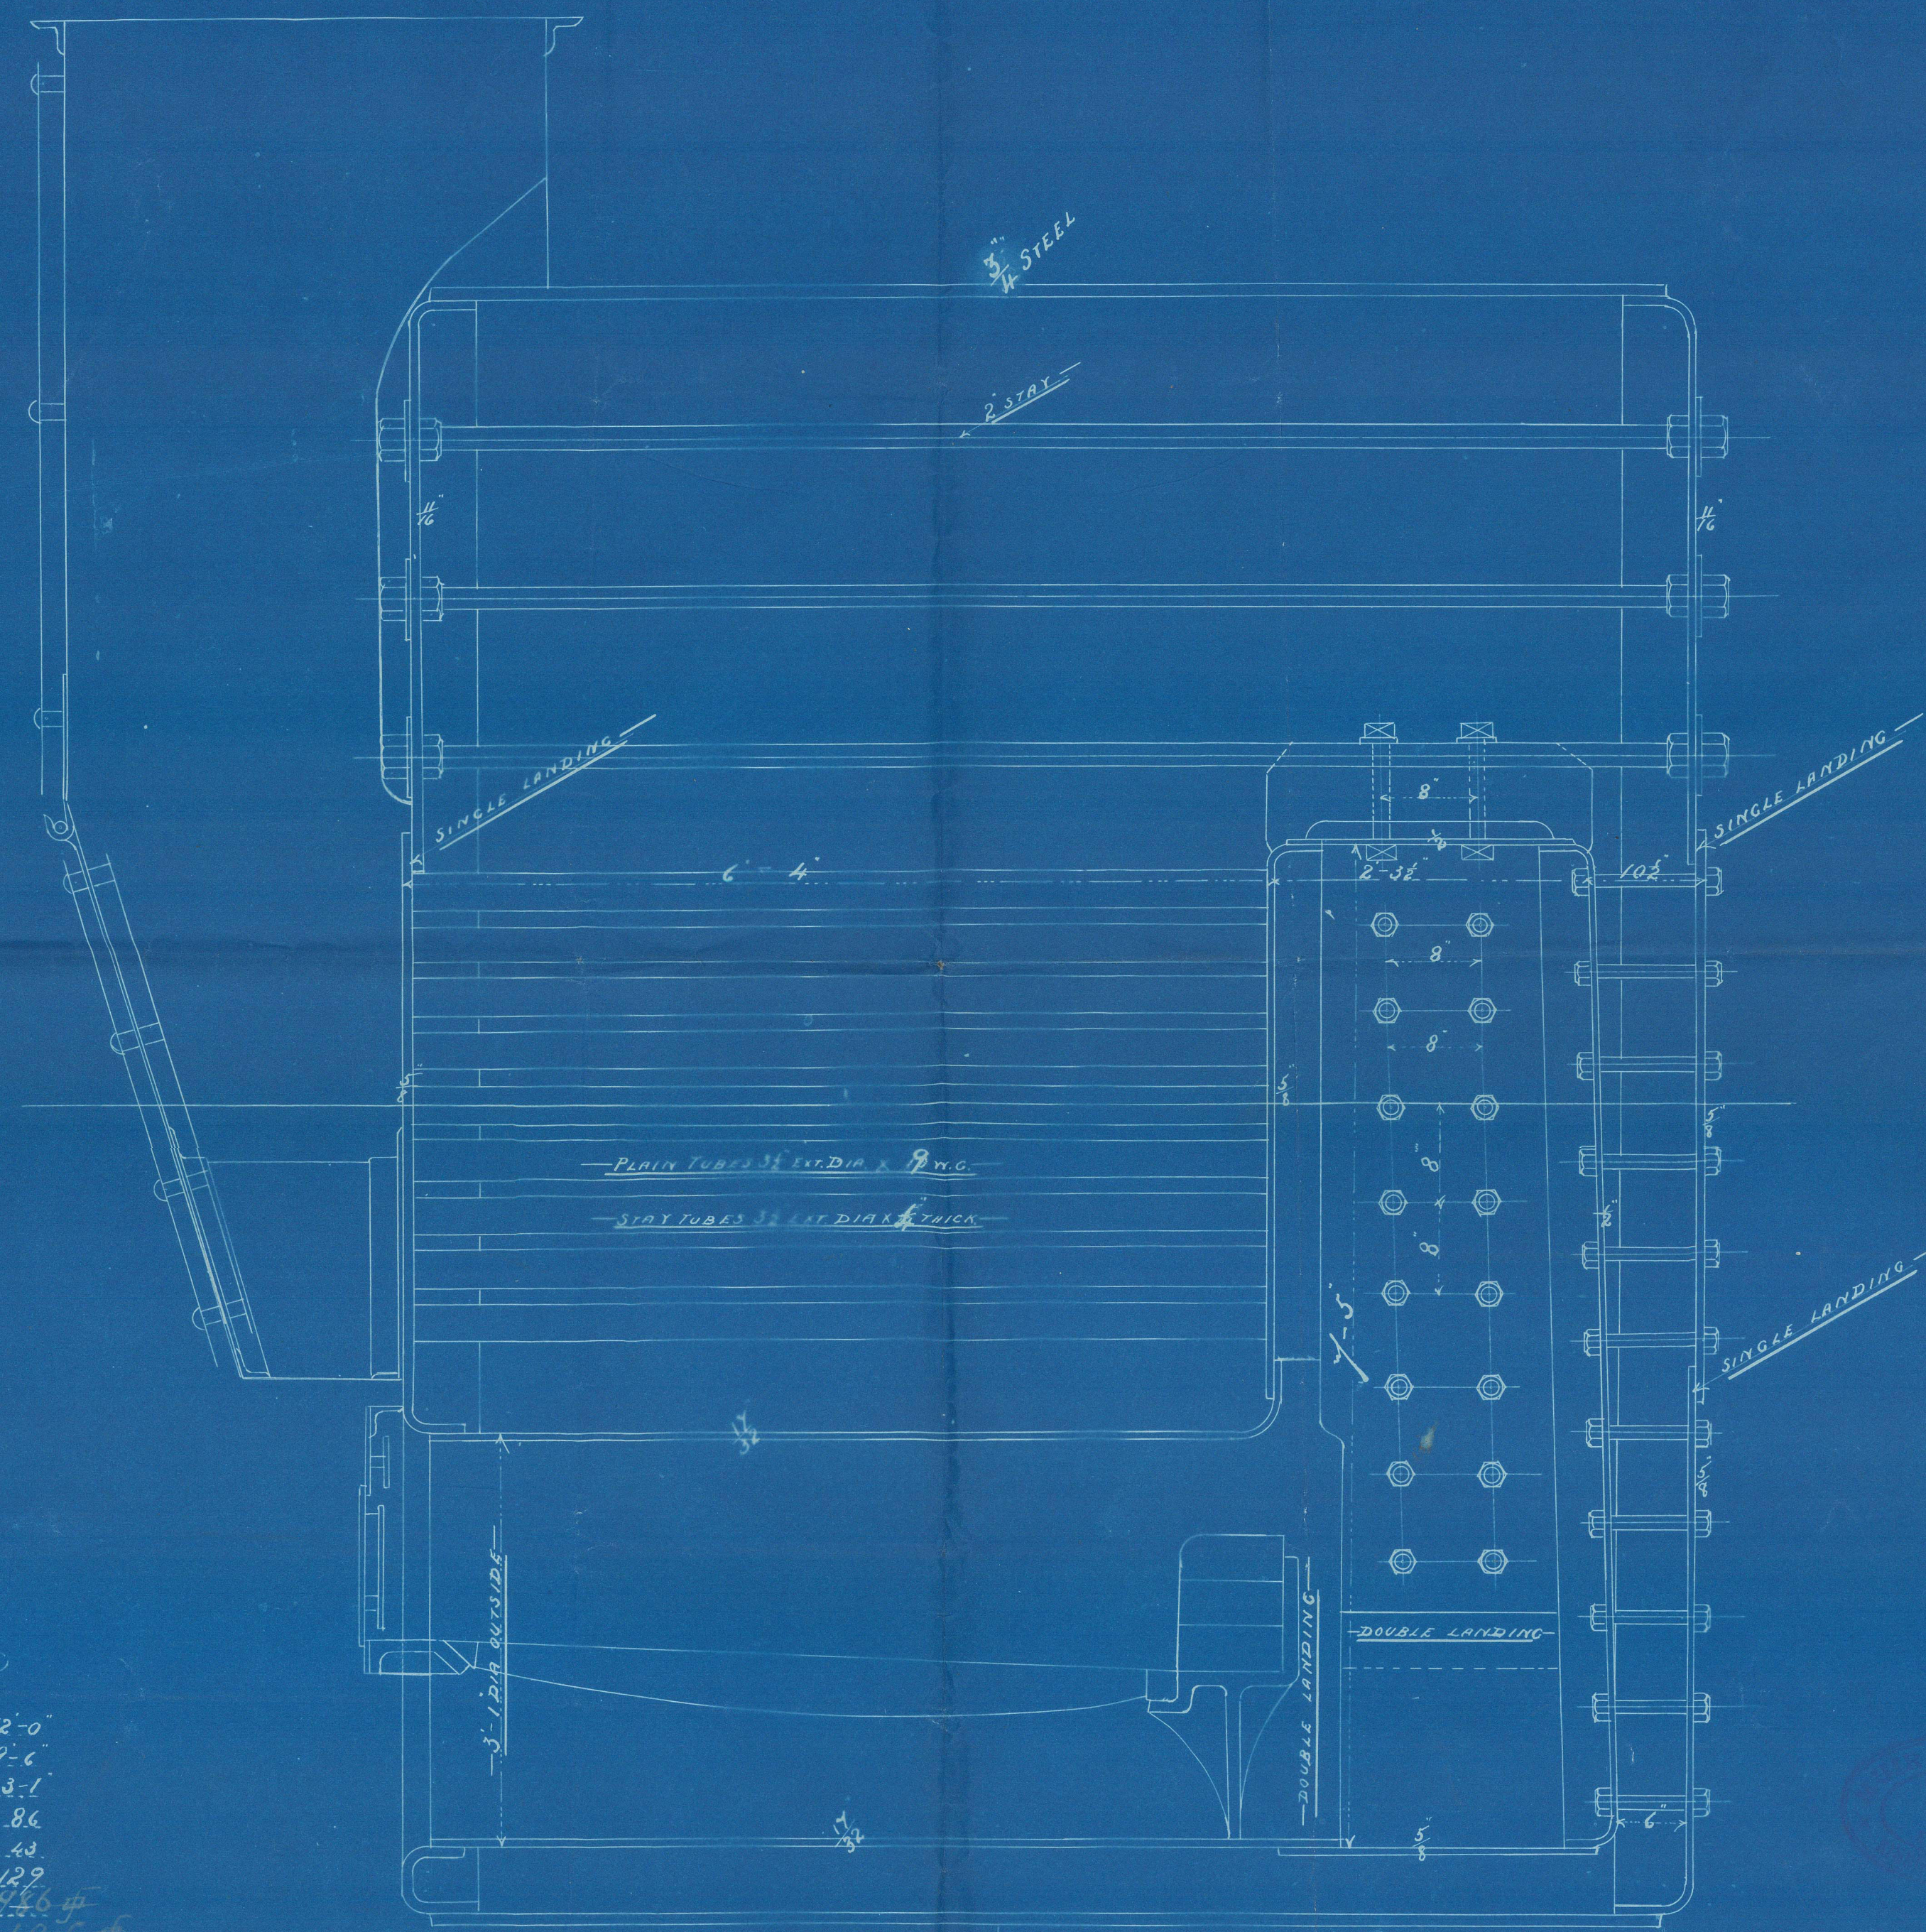



MARINE BOILER No 216

SCALE 1 INCH = ONE FOOT

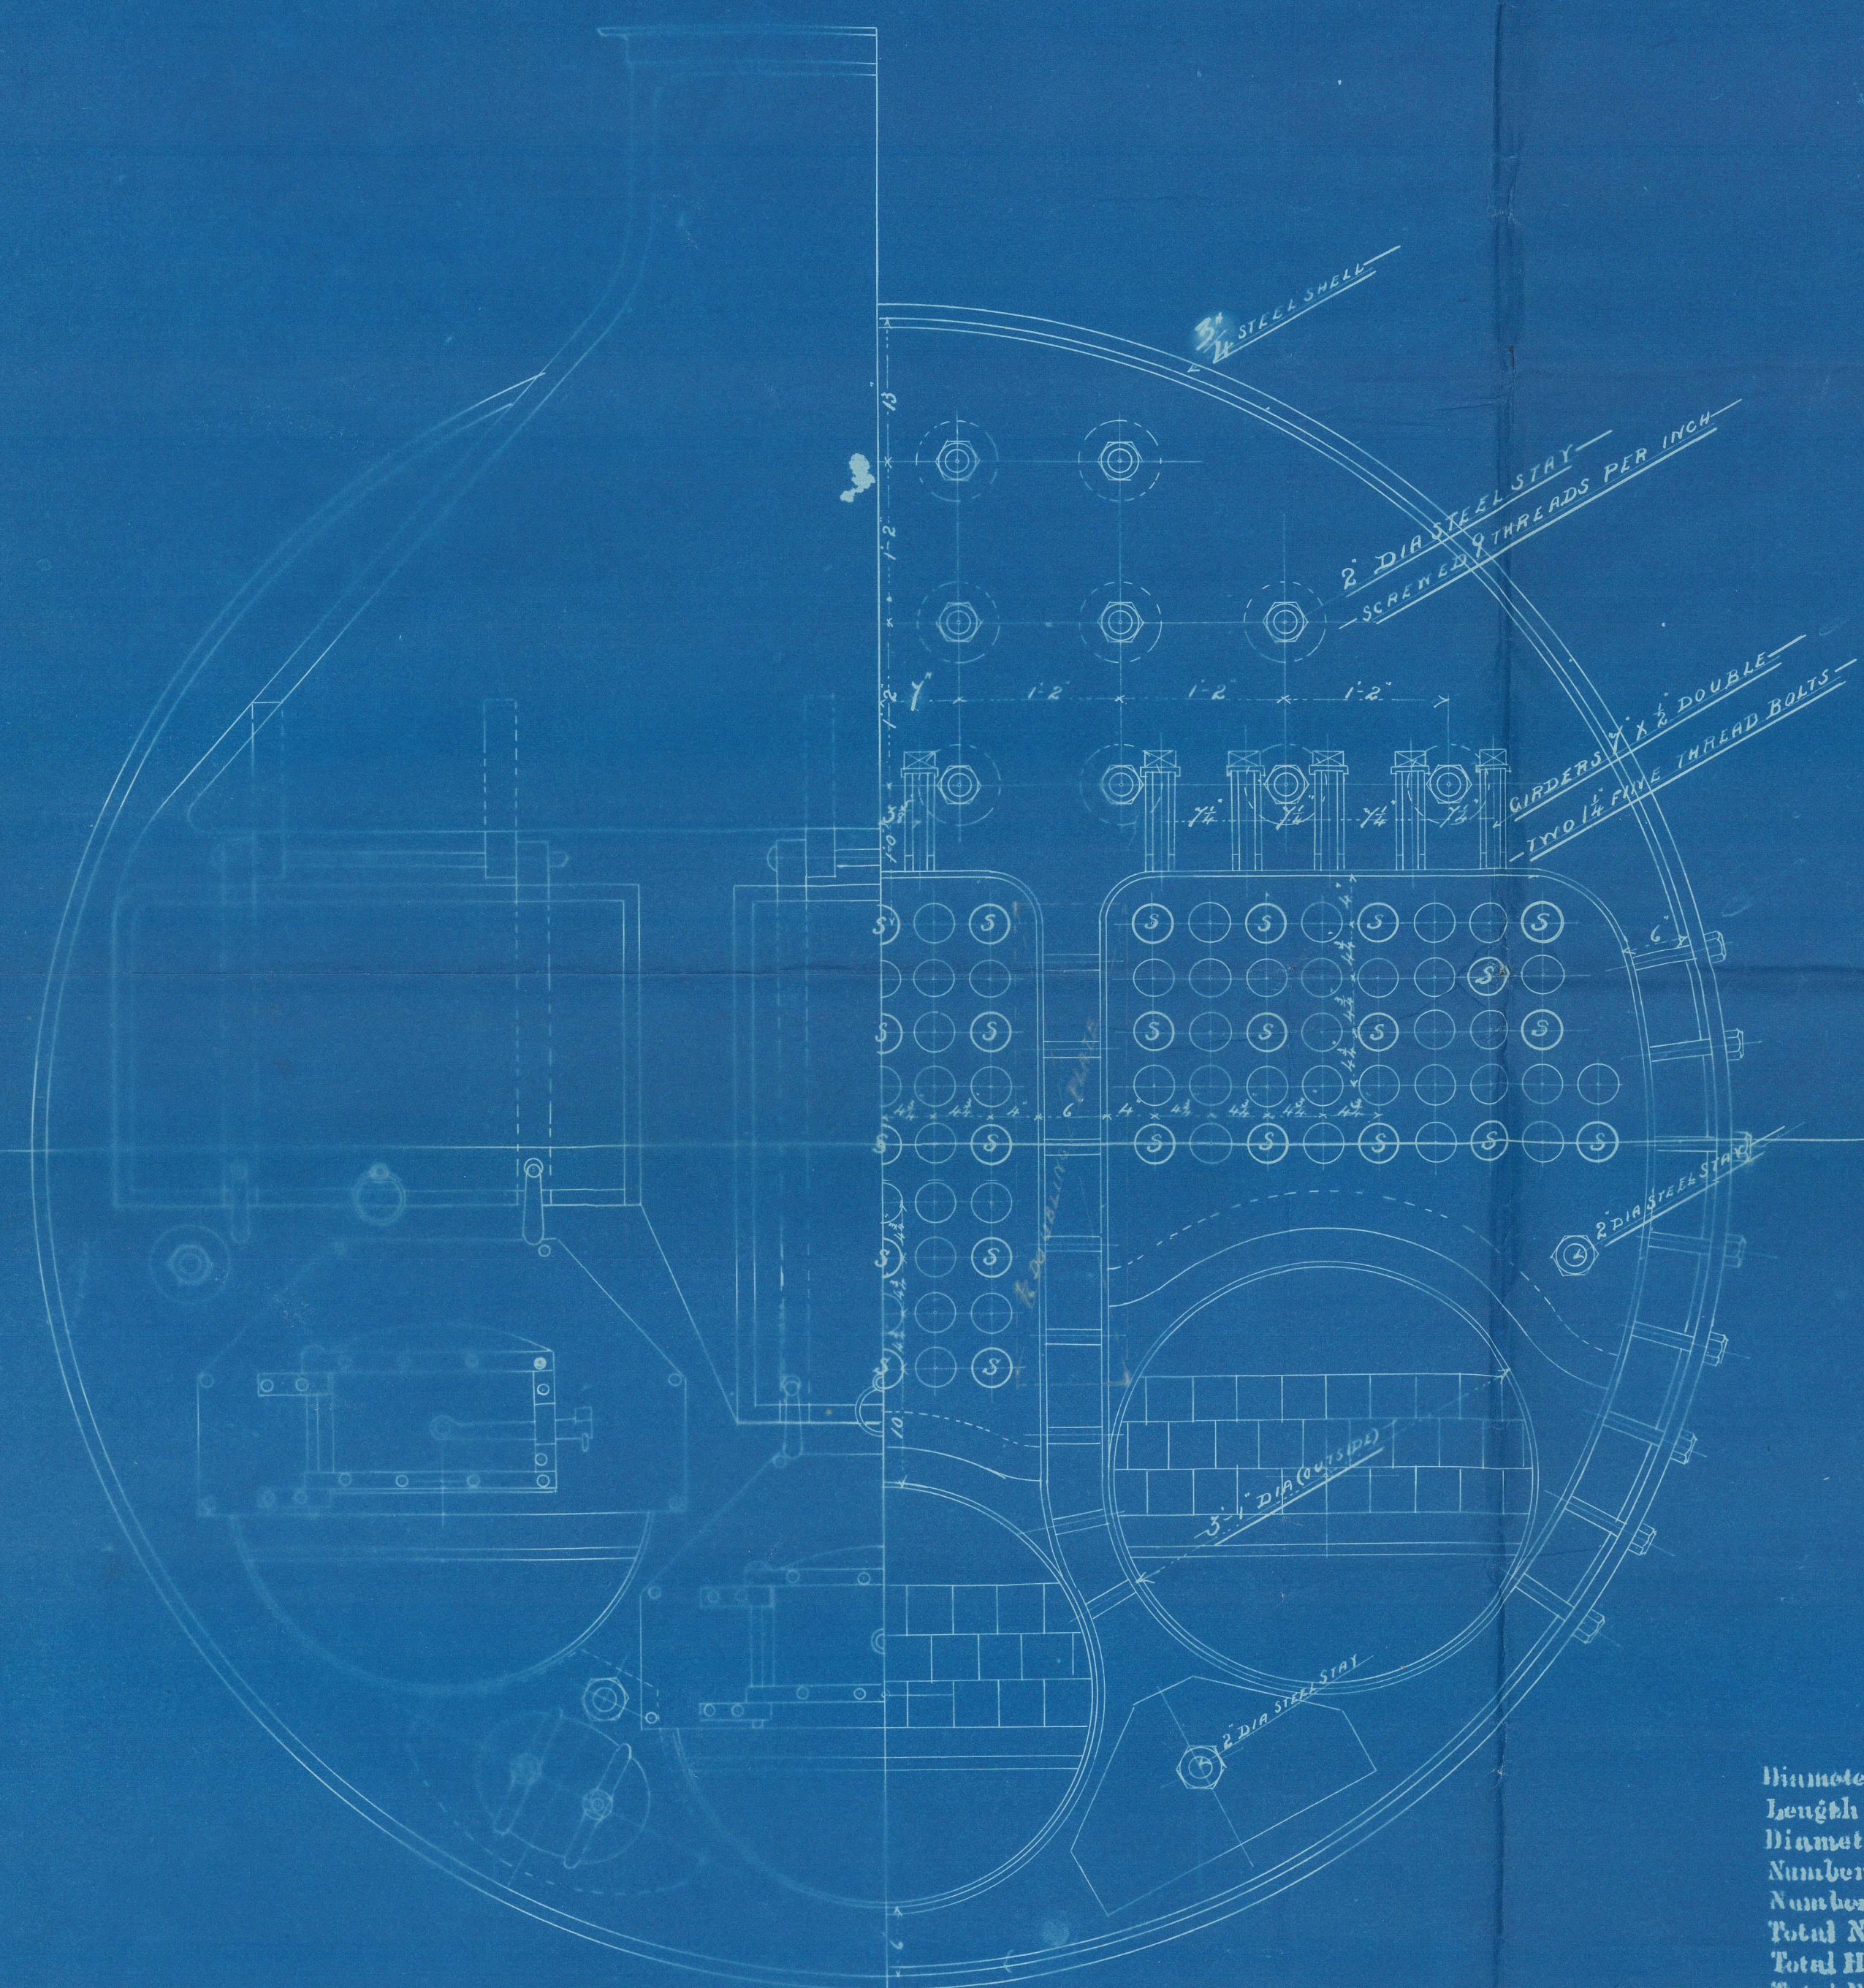

DIMENSIONS

Diameter of Boiler... 12'-0"
 Length of Boiler... 9'-6"
 Diameter of Furnaces... 3'-1"
 Number of Plain Tubes... 86
 Number of Stay Tubes... 40
 Total Number of Tubes... 126
 Total Heating Surface... 1166 #
 Total Firegrate Area... 149.5 #
 Working Pressure... 110 lbs

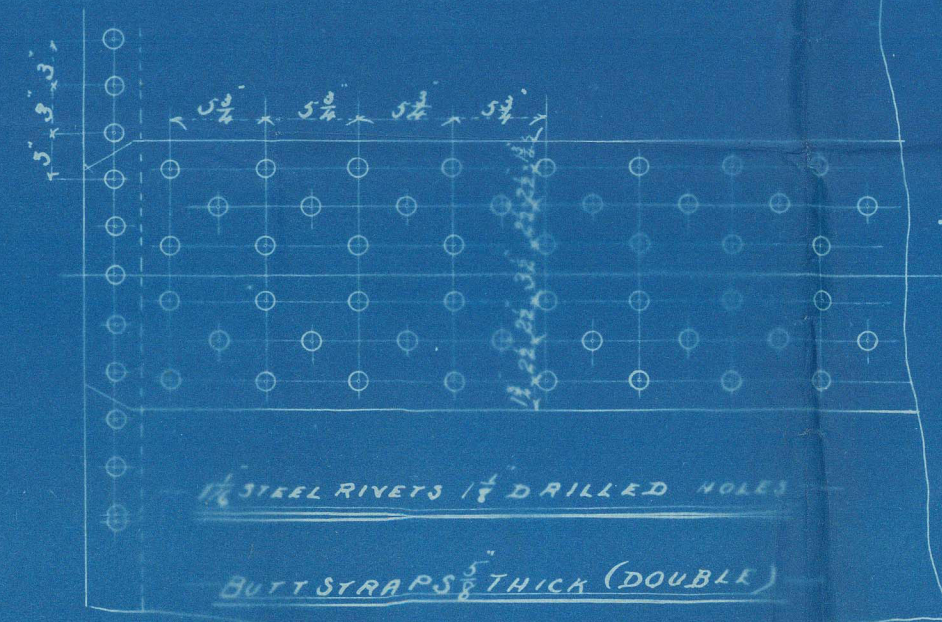

916

GLS241 - 0150

~~Gilman & Co~~

Muir & Houston

Main Boiler N^o 216.

Lbs 110 ~~100 lbs.~~

~~Fuel & Oil N^o 110.~~

S. S. "Progress"
Glasgow Report
N^o 13008.



© 2021

Lloyd's Register
Foundation