

6:94


















— № 44 —

SCALE  $\frac{1}{4}$  INCH = 1 FOOT

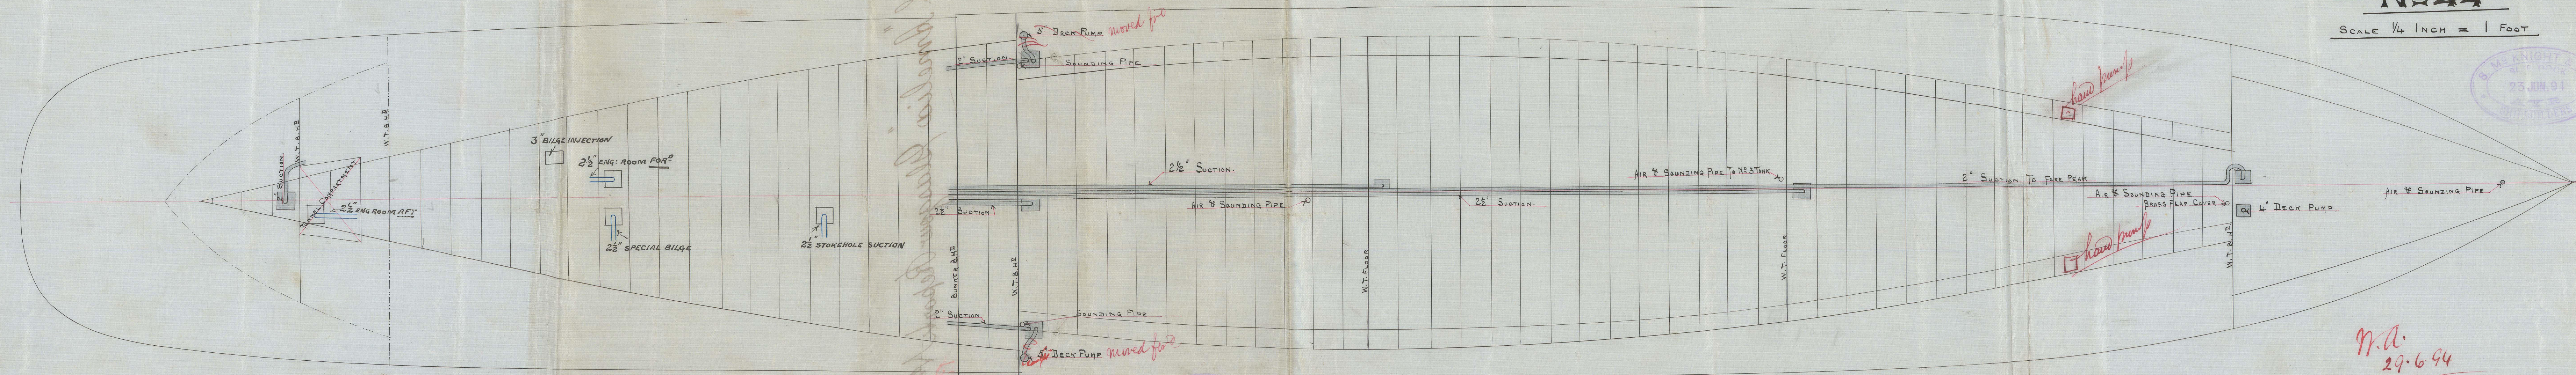

N.A.  
29.6.94



10  
18  
50  
15





S.S. "Amelia" Glasgow Report No 13160.-  
Pumping plan



© 2021

Lloyd's Register Foundation



625243-0088