


*Ref. H. 1: 94*

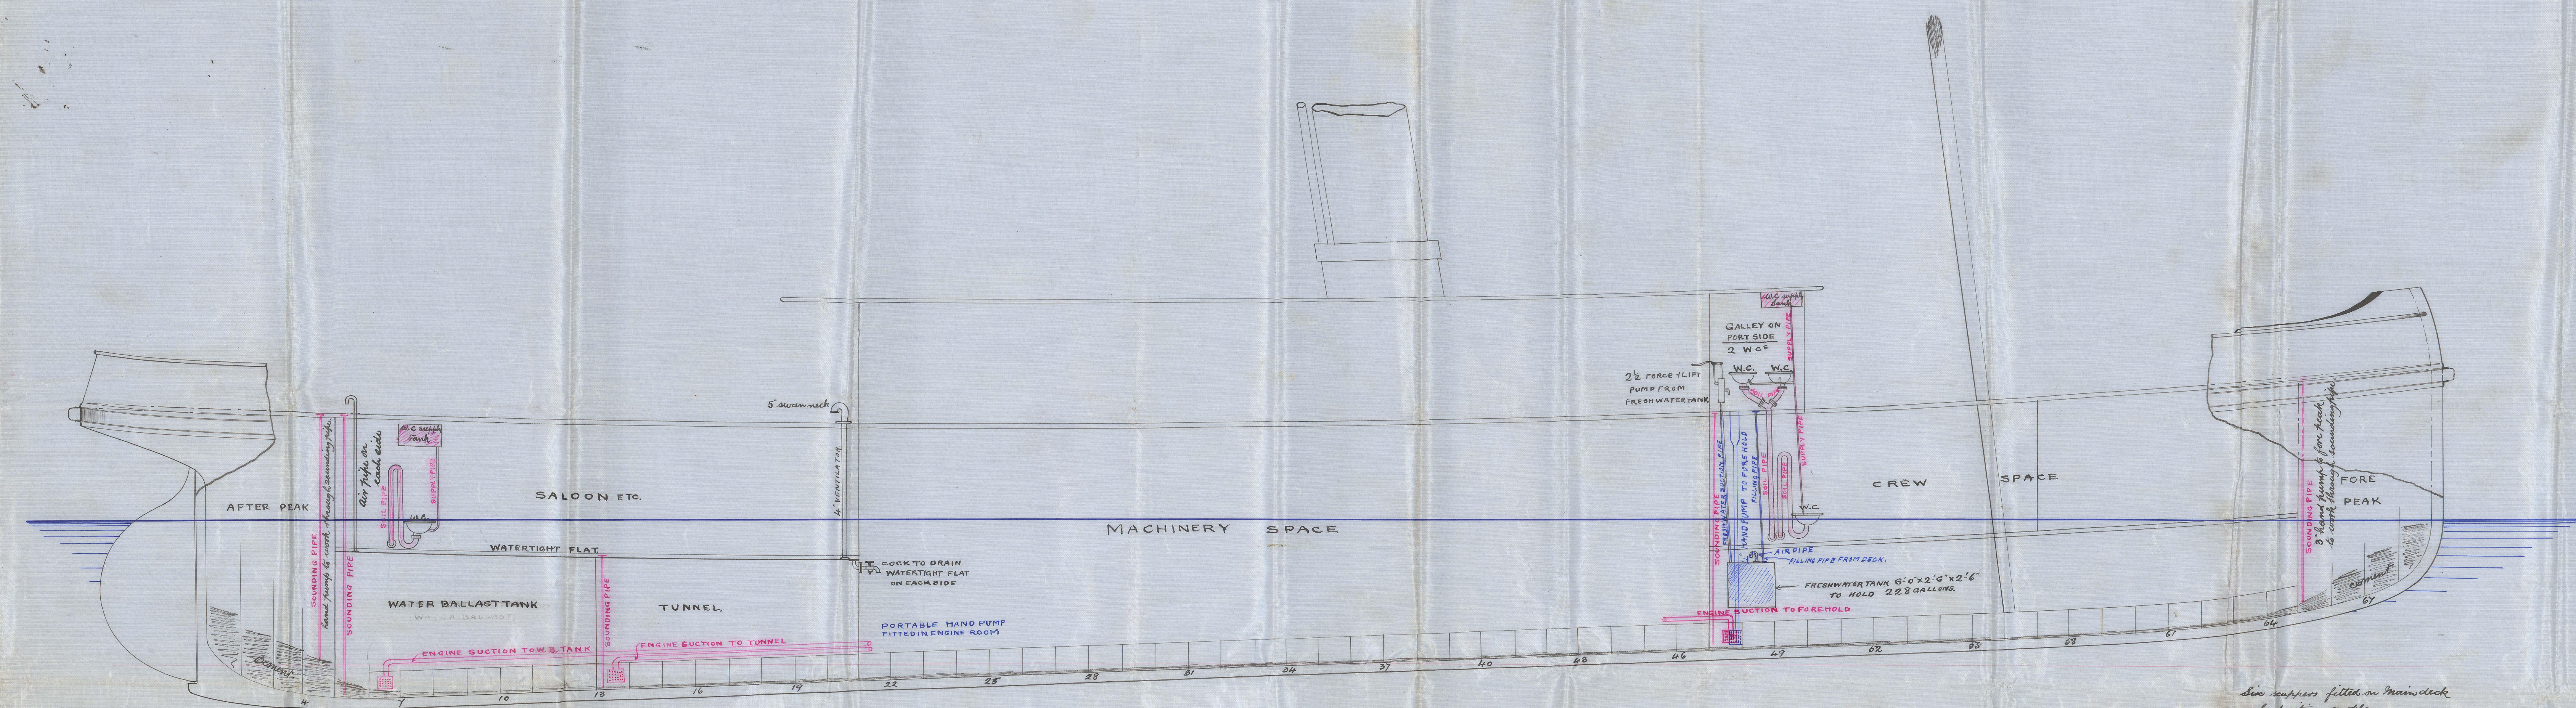


3 wash hand basins  
1 in Radio cabin  
1 in Captain's  
1 in Mate's  
Basin basin in saloon.

See supplies fitted on main deck  
for position see plan.  
See on bridge deck and four on flying bridge.

— Pumping Plan. —  
— for —  
— Twin Screw Lug. No 393 —

— Scale, 1/4" = one foot. —  
Gross Tonnage = 238.5 (about)

*12861 at "waterproof" with pipe made*

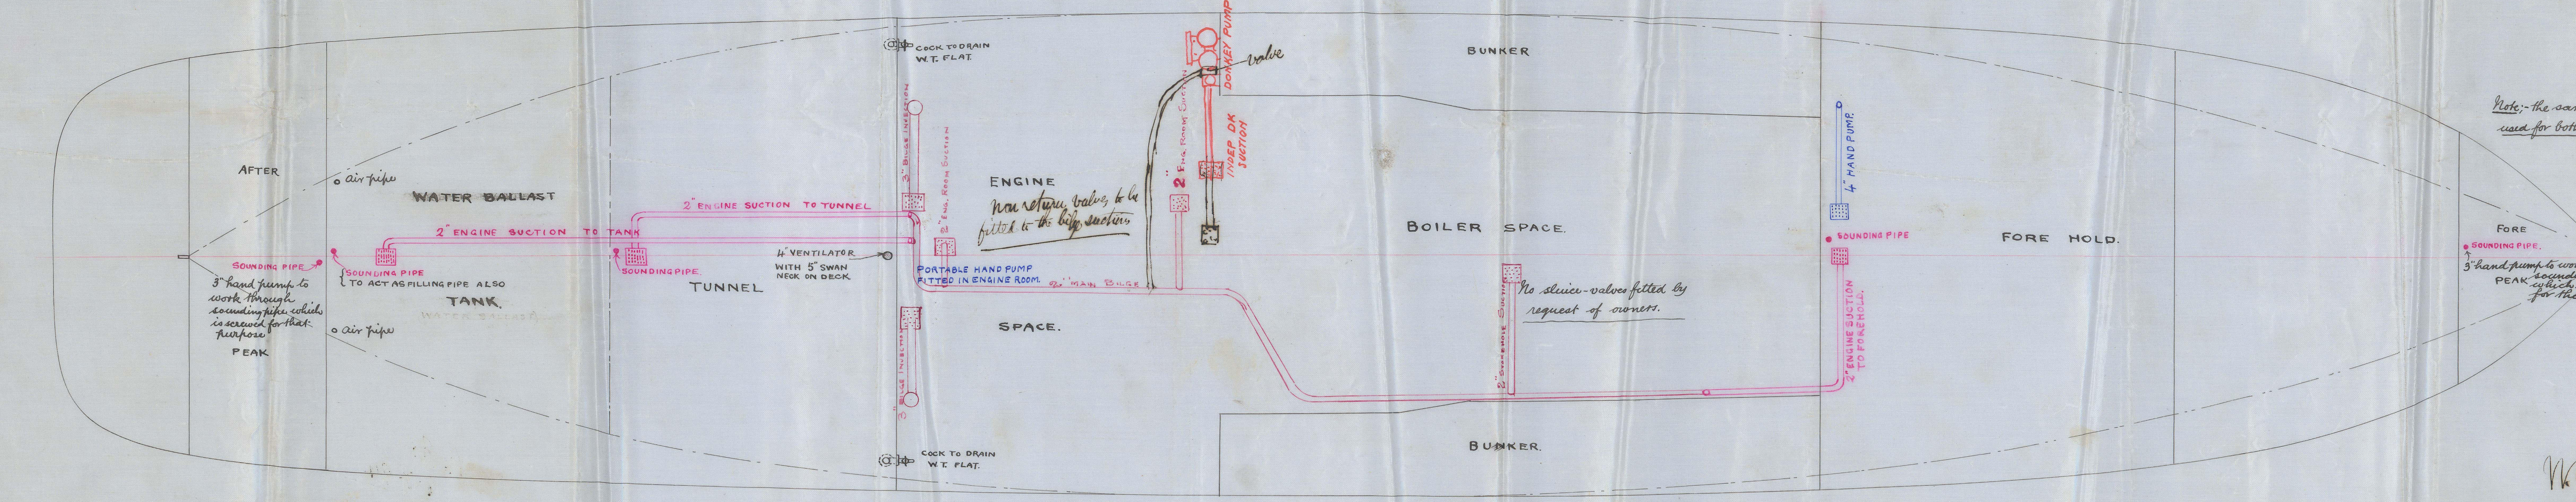

Note: the same pump is to be  
used for both fore & after peaks.

3" hand pump to work through  
PEAK sounding pipe  
which is to be secured  
for that purpose.

*W.A.  
6-7-94*

REGISTERED  
SHIP  
26.85.  
1894

REGISTERED  
SHIP  
26.85.  
1894

REGISTERED  
SHIP  
26.85.  
1894



REGISTER OF SHIPMENTS  
RECEIVED  
5 JUN 1934  
MEDICINE

Lloyd's Register  
Foundation