

Lloyd's Register of British and Foreign Shipping.

(Report on Vessel No. 13246 Port Glasgow)

S. Jug "Jax"

No. 4647 SHIP FORGINGS OR CASTINGS.

The records FORGINGS or CASTINGS, IRON or STEEL, should be struck out as may be required.

I have to report that the undermentioned Iron or Steel Forgings or Castings, manufactured by New Barclay Clark & Co of Glasgow for the vessel No. 393, being built by them of _____

have been inspected by me as set forth below, and found to be, so far as can be seen, Sound & efficient


Mark on Forgings.

Lloyd's
No. 4647
W. H.

William Hamilton
Glasgow 4/7/94

	STERN FRAME.	RUDDER FRAME.	STEM + Keel bars
Material*	<u>Scrap iron</u>	/	<u>Roll'd bar iron</u>
How made	<u>Forged</u>		
Dimensions	<u>7 x 1 3/8</u>		<u>7 x 1 3/8</u>
Progress on Inspection	<u>Forging & smithing</u>		<u>When completed</u>
Date when Inspected	<u>14. 18. 21. 29/6/94</u>		<u>21/6/94</u>

SKETCHES OF FRAMES SHOWING POSITION AND DESCRIPTION OF WELDS OF FORGINGS, OR PARTICULARS OF TESTS APPLIED TO CASTINGS.

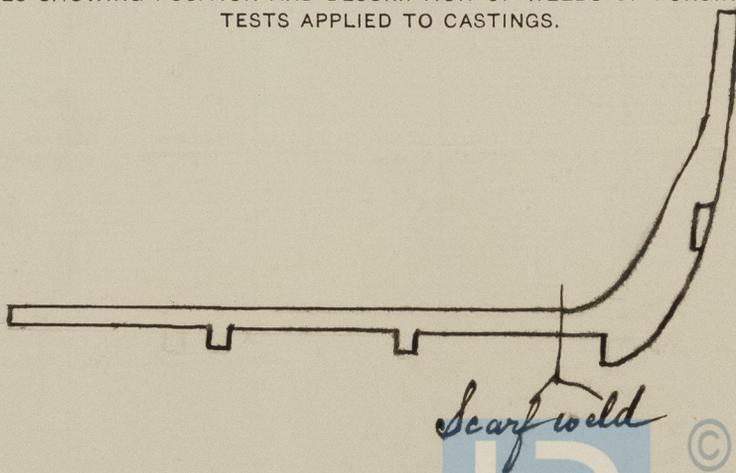

Scarf weld

© 2021

Lloyd's Register
Foundation

* If of Iron, state whether scrap or puddled Iron.