

three stays in row 16" pitch.

→ six stays in this row 16" pitch

→ eight stays in this row 16" pitch

addition

422.  
Louis Brenden  
G. J.  
1 June 1894.

W.A.  
5.6.94

Double ended


*Boiler ended*  
**BOILER N<sup>o</sup> 4 22**

SCALE  $\frac{3}{4}" = \text{ONE FOOT}$

2 OFF



Boilers  
S.S. "Santo Domingo"  
Glasgow Report  
No. 13325.

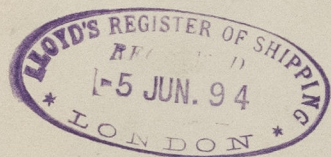

© 2021

Lloyd's Register  
Foundation

5500-5425-0055